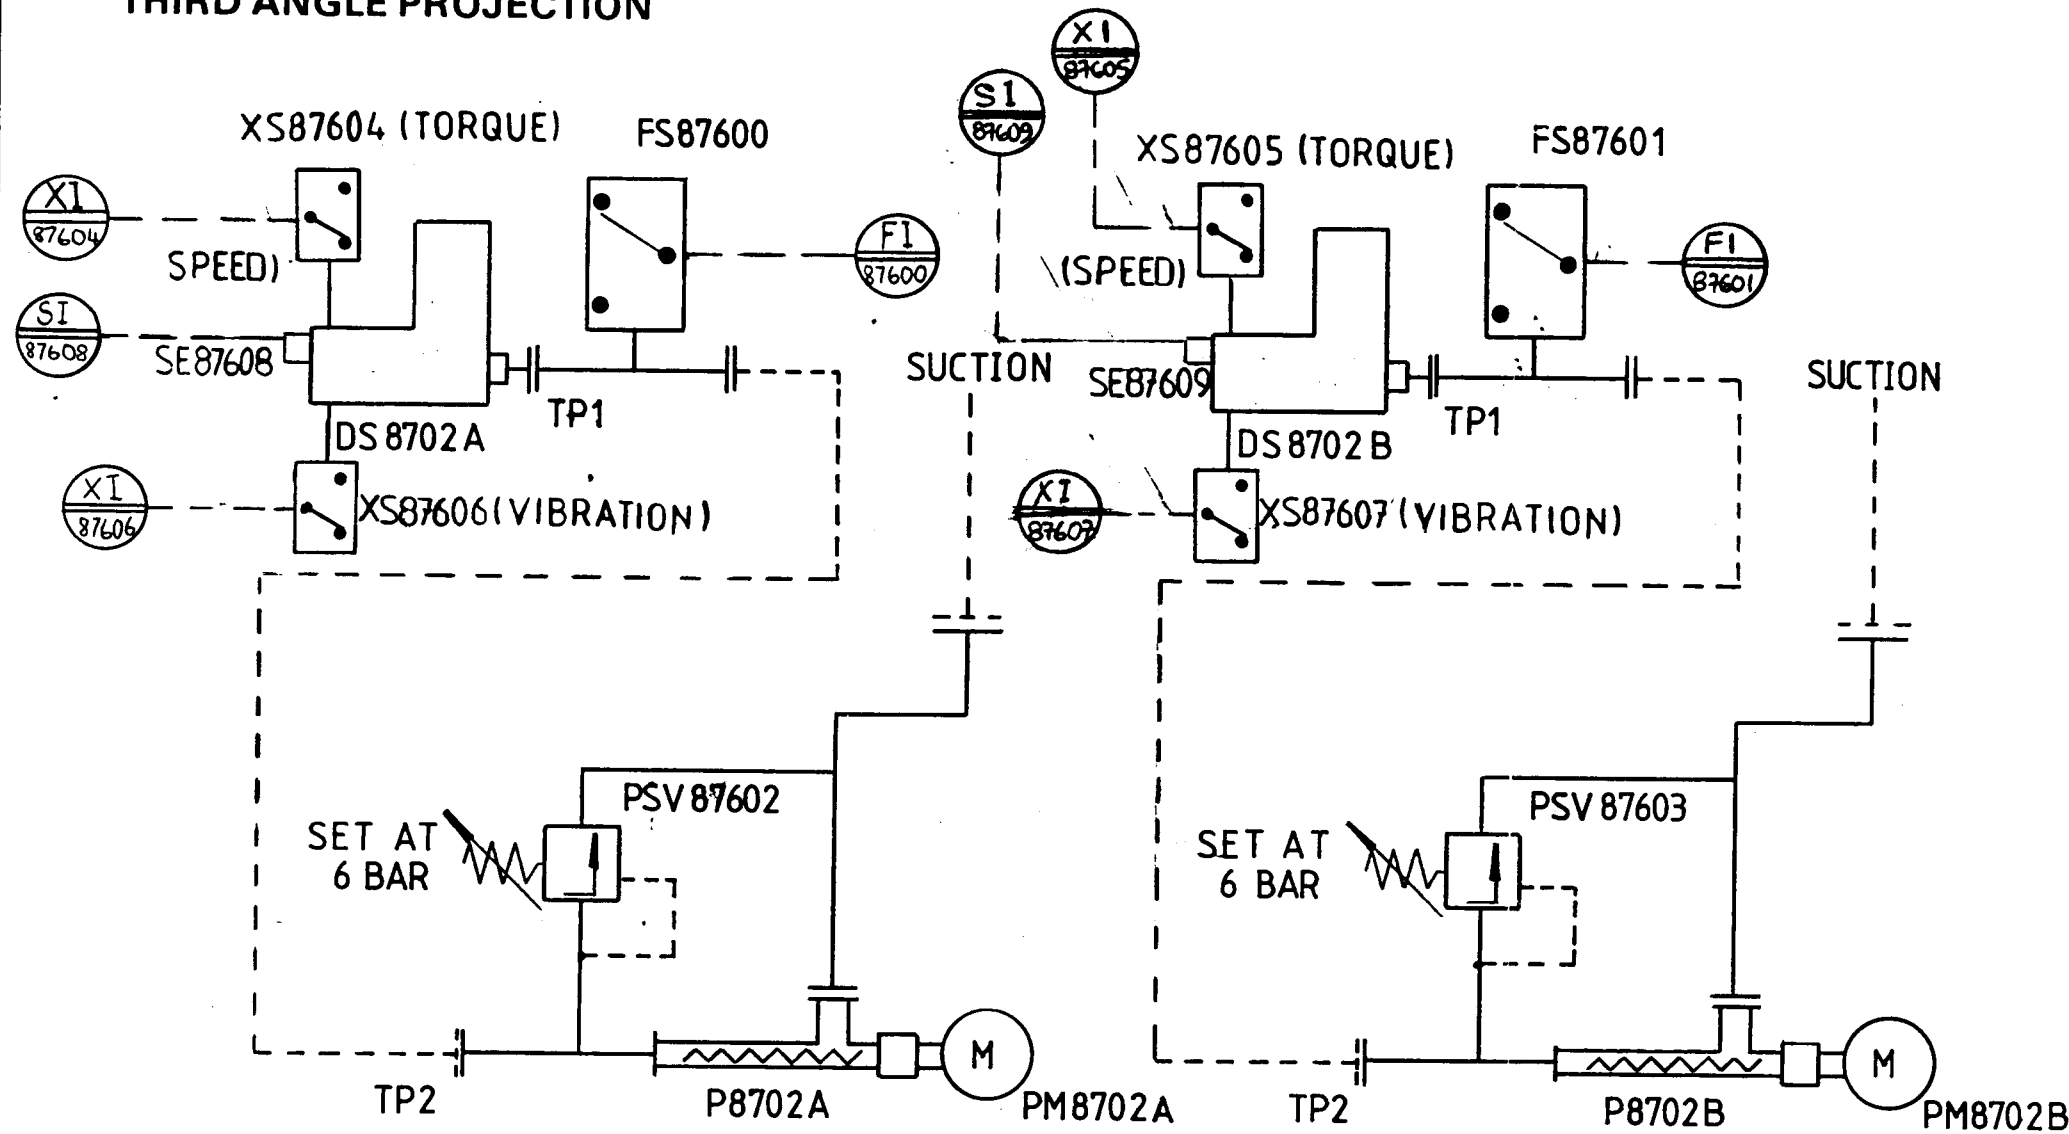


THIRD ANGLE PROJECTION

DO NOT SCALE

COMMON  
ALARM XA 87012 SEE NOTEJC-8717  
LOCAL CONTROL  
PANEL**ORIGINAL**

NOTE:- XA87012 IS LOCATED AT DRILLERS  
CONSOLE & SUPPLIED BY OTHERS.  
DREXEL TO PROVIDE VOLT FREE CONTACTS  
FOR AHL TO CABLE BETWEEN JC-8717  
& DRILLERS CONSOLE

LEGEND

----- SUPPLIED BY OTHERS

**AS SUPPLIED**

Sellers statement :  
This document accurately  
represents the as supplied  
condition of the work

Seller's Authorized Signature :

Date :

22/8/91

**COMPANY RETURN CODES**

- ☒ 1. Accepted - "As Supplied"
- ☐ 2. Accepted - No Comments
- ☐ 3. Qualified Acceptance - Minor Comments.  
Revise & Resubmit as "As Supplied"  
Work May Proceed
- ☐ 4. Qualified Acceptance - Minor Comments.  
Revise & Resubmit To Obtain Code 2  
Work May Proceed
- ☐ 5. Qualified Acceptance - Major Comments.  
Revise & Resubmit To Obtain Code 2  
Work May Proceed
- ☐ 6. Rejected - Revise & Resubmit Immediately  
Work May Not Proceed In The Affected  
Areas
- ☐ 7. Review Not Required

Company's  
Signature

Date: 6/5/92

**AMERADA HESS LIMITED****SCOTT FIELD DEVELOPMENT**Package  
Desc**CENTRIFUGE  
PACKAGE**

Equip Nos

PB702 A-B  
DS8702 A-BSDRS  
Codes

001

Module

Sheet 1 of 1

Purchase Order No

Document No

Rev

P0134

00001

04 05

**MACHINING TOLERANCES U.O.S.**

.X = ± .015" .XX ± .010" .XXX ± .005"

**DREXEL EQUIPMENT (UK) LTD.**  
WALDRON RD., MONTROSE,  
SCOTLAND DD10 8SW

SCALE

MATERIAL

HEAT  
TREATMENT

ASSEMBLY

JOB No.

8520

TITLE

P & I.D.  
CENTRIFUGE PACKAGE

DRN. BY GCB

DATE 10/2/91

CHK'D BY

DATE 11-2-91

DRG. No.

B.4637