


REEL MOUNTED STAB PLATE  
HYDRAULIC SYSTEM

- NOTES:
1. THE REFERENCE NUMBERS STAMPED ONTO THE HYDRAULIC STAB PLATES CORRESPOND TO THE AMERADA HESS FUNCTION LIST NUMBERS. TAG Nos CORRESPOND TO V.G. LINE Nos.
  2. ELECTRICAL CABLES ARE ARMoured SCREENED, TWISTED PAIRS. CONDUCTORS HAVE 2.5 mm SQ CROSS SECTIONAL AREA.

COT STAB PLATE No.	V/G REF No.
No. A4	5
No. A3	6
No. A7	7
No. A5	4
No. A8	2
No. A2	1
No. A1	8
No. A6	

FOR CONNECTION TO THE TREE CAP RUNNING TOOL.

FOR CONNECTION TO THE TUBING HANGER RUNNING TOOL.

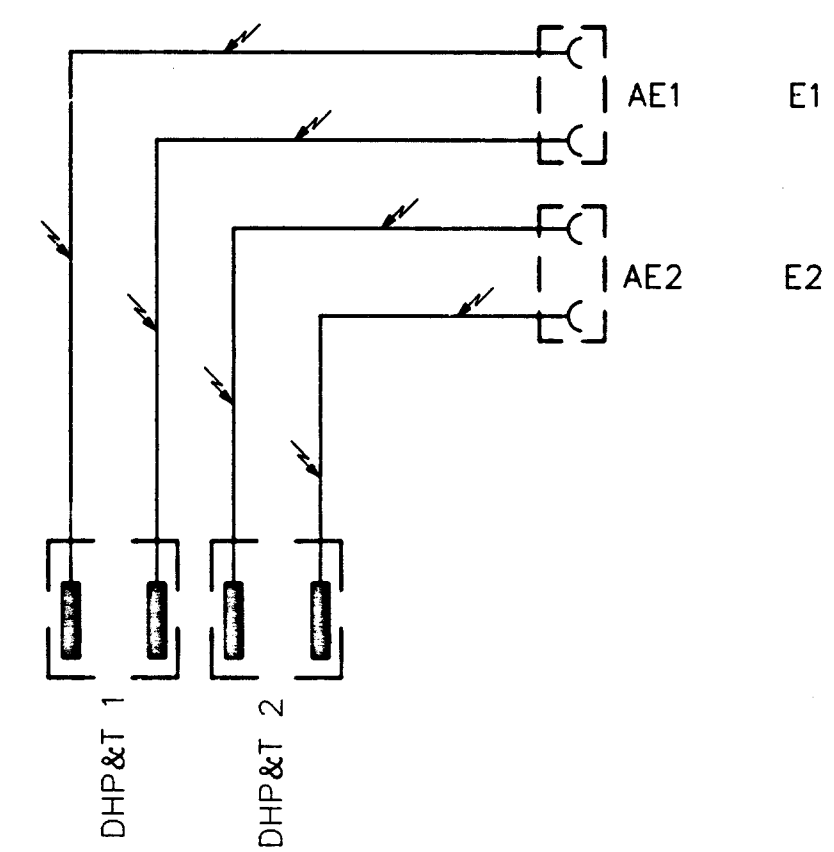

**AS SUPPLIED**

Seller shall complete both Sections A & B, sign & date

**A** All Company comments on previous submission have been fully incorporated

☐ Yes ☐ No ☒ Not Applicable

**B** There are no design changes, other than incorporation of Company comments, from previous submission

☐ Yes ☒ No

**Seller's Verifying Statement:**  
This document accurately represents the "As Supplied" condition of the Work

Sellers Authorised Signature: *[Signature]* Date: *16/3/93*

DOCUMENT REFERENCES			
Ref. No.	Description	AHL Doc. No.	COT Doc. No.
1	BOM REEL NO. 2	C0041	223030-04-00-00
2	ELE. INTERFACE DIAGRAM REEL 2	F0004	SK-66030-04-08-00
3	FD REEL NO. 2	F0012	SK-66030-04-01-00
4	GA REEL NO. 2	C0013	SK-66030-04-00-00

COMPANY RETURN CODES		AMERADA HESS LIMITED SCOTT FIELD DEVELOPMENT	
<input checked="" type="checkbox"/> 1	Accepted "As Supplied"	Package Desc	WORKOVER CONTROL SYST.
<input type="checkbox"/> 2	Accepted-No Comments	Equip. Nos	SH 6401B
<input type="checkbox"/> 3	Qualified Acceptance - Minor Comments Revise & Resubmit as "As Supplied" Work May Proceed	SDRS Codes	D01
<input type="checkbox"/> 4	Qualified Acceptance - Minor Comments Revise & Resubmit To Obtain Code 2 Work May Proceed	Module	
<input type="checkbox"/> 5	Qualified Acceptance - Major Comments Revise & Resubmit To Obtain Code 2 Work May Proceed	Purchase Order No	Document No
<input type="checkbox"/> 6	Rejected - Revise & Resubmit Immediately Work May Not Proceed In The Affected Areas		Rev
<input type="checkbox"/> 7	Review Not Required		

Company's Signature: <i>[Signature]</i>	Date: <i>16/3/93</i>	S000 CU RM 0001 P1305	D	0,0,0,9,0,2
---	----------------------	--------------------------	---	-------------

COOPER Cooper Oil Tool		Cooper Industries Cooper Oil Tool Division Luttenberg 1 3100 Celle, Germany	
PIPING & INSTRUMENTATION DIAGRAM REEL NO.2			
Partlist: 223030-04-00-00		Scale: 1 of 2	
DWG No: SK-66030-04-02-00		Sheet 1 of 2	

Rev	Date	Name	Chk.	Appr.	Remarks
B1	9.2.93	KS	MID	KUE	AS BUILT
A1	27.7.92	KS	MID	KUE	INITIAL RELEASE
Copyright according to DIN 34 Copying of this document and giving it to others and the use or communication of the contents thereof, are forbidden without express authority.					
Supersedes					
Dated					