
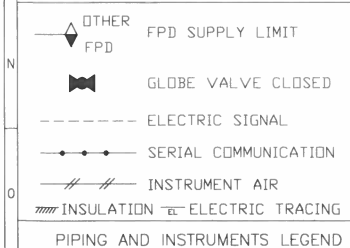


| REV | DATE | DESCRIPTION | DWN | CHK | APP |
|-----|----------|-------------|-----|-----|-----|
| 08 | 03/12/13 | As Bult | | | |
| 07 | 25/09/13 | As Bult | | | |
| 06 | 12/09/13 | As Bult | | | |
| 05 | 19-10-12 | Revised | | | |
| 04 | 29-10-12 | Revised | | | |
| 03 | 06/08/12 | Revised | | | |
| 02 | 30/05/12 | Revised | | | |
| 01 | | | | | |

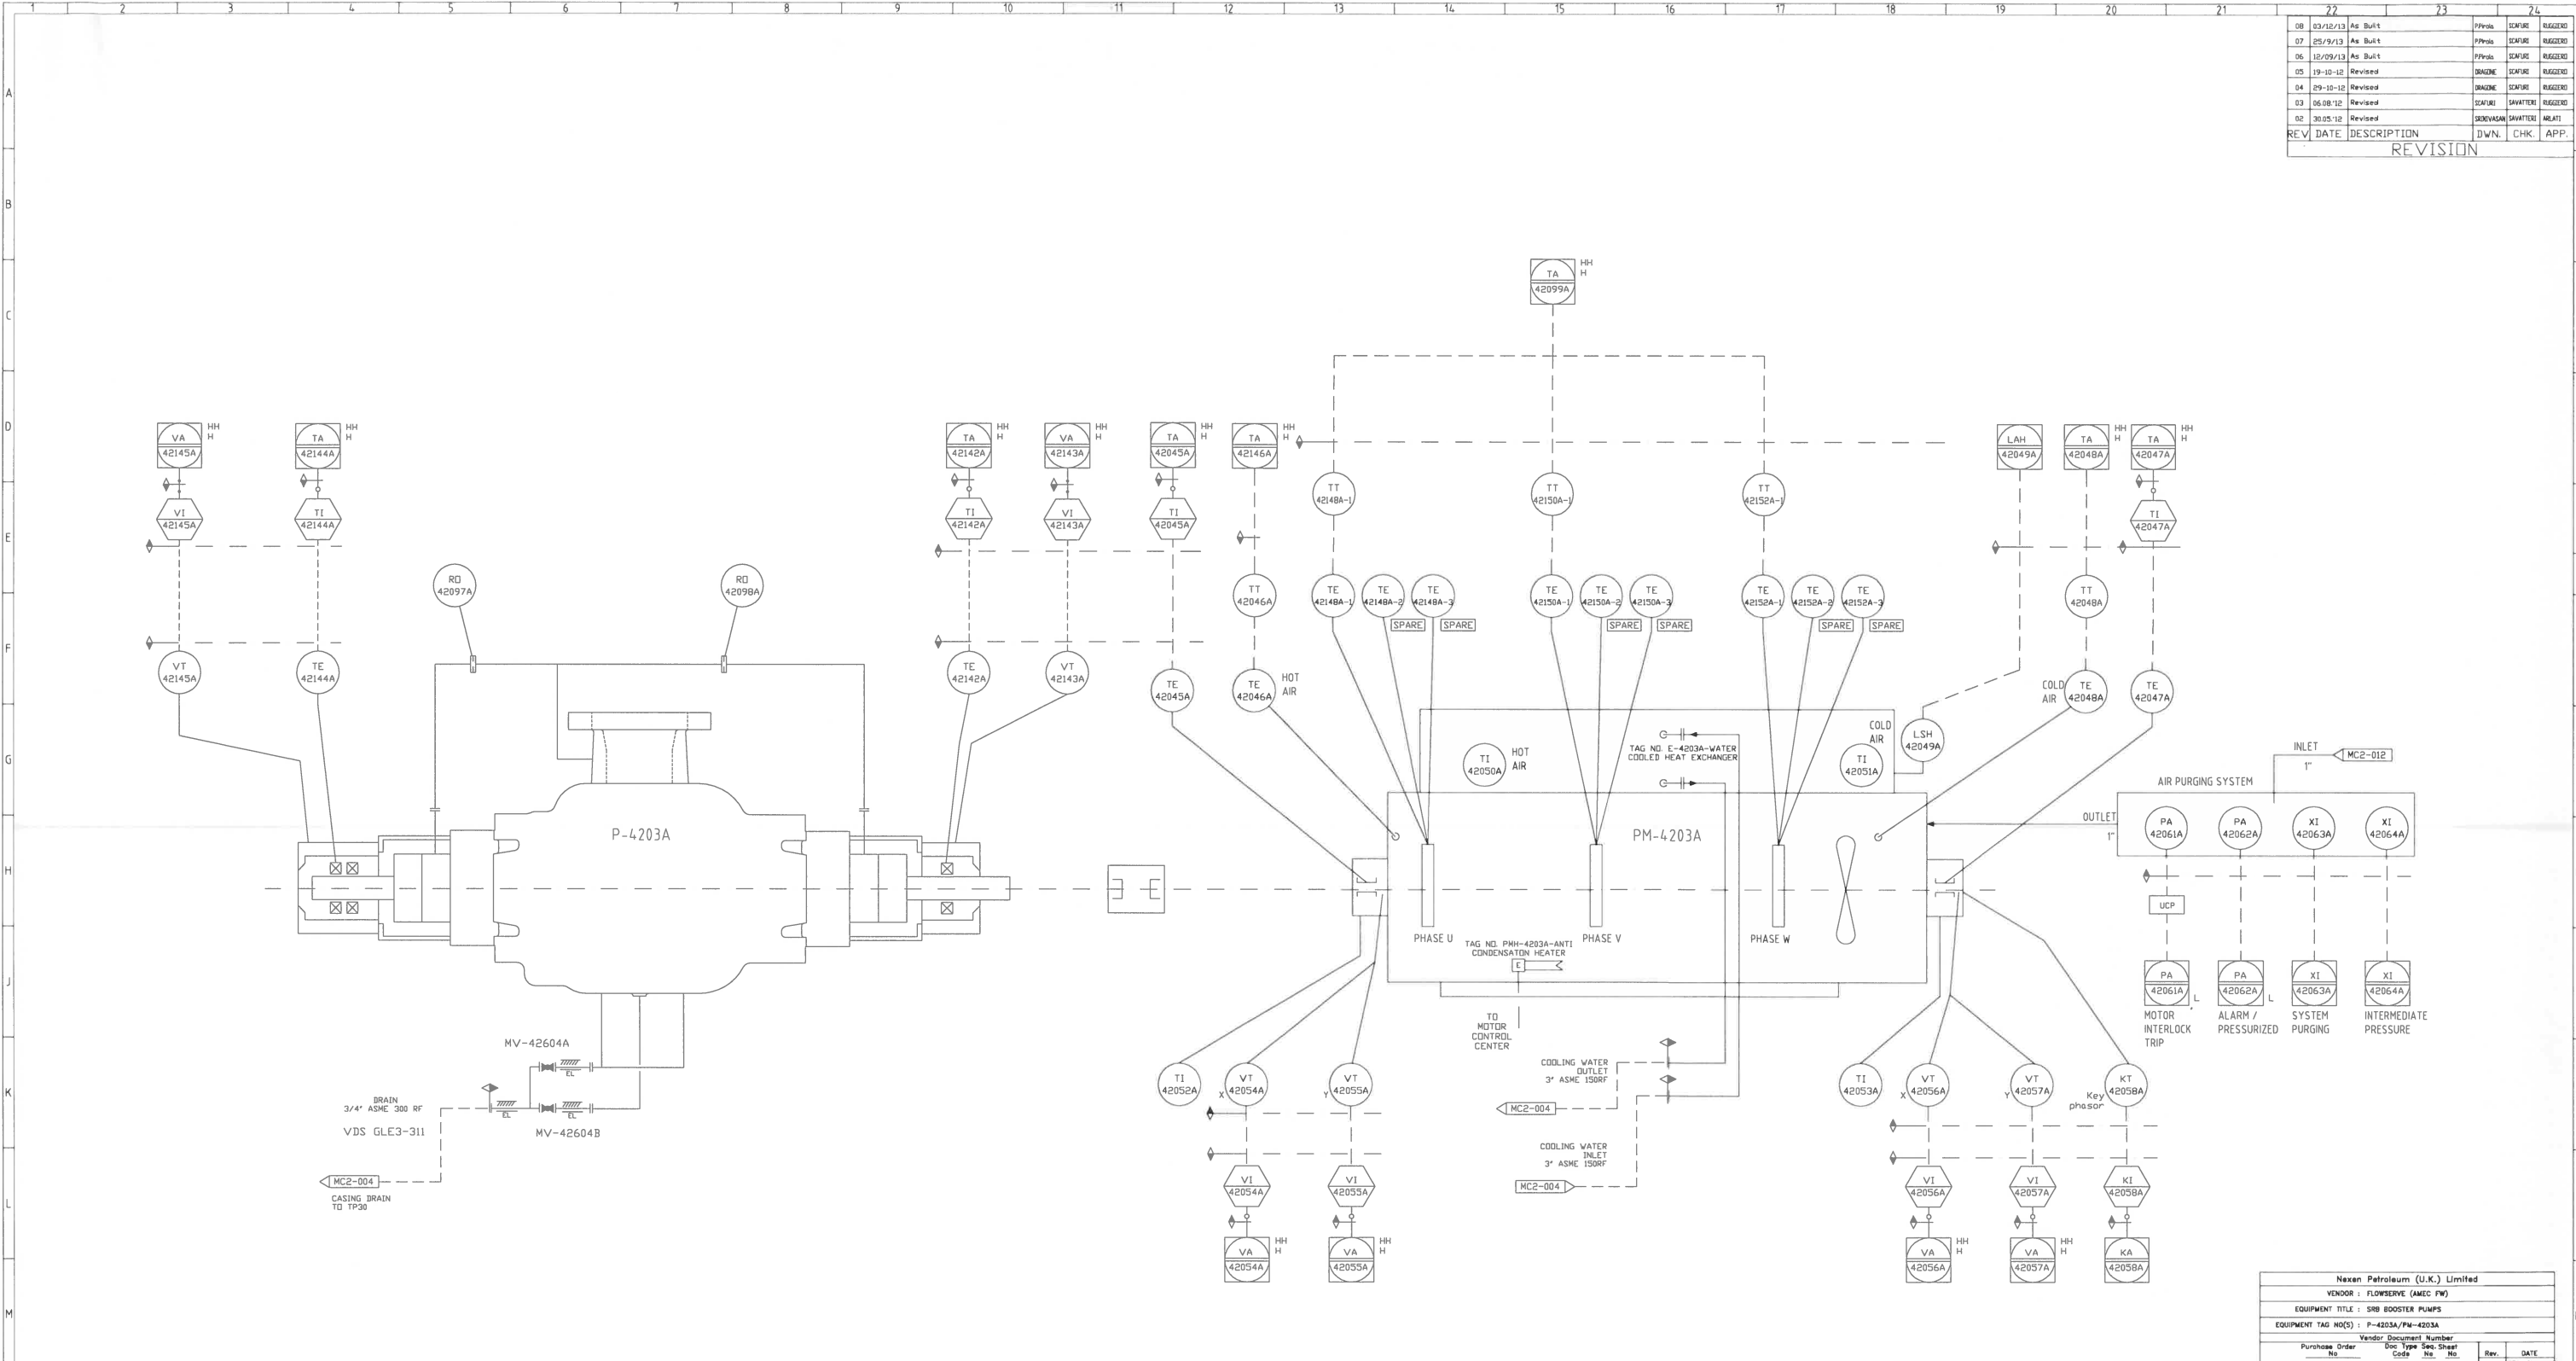

| REFERENCE DOCUMENT NUMBERS | |
|---|---|
| DOCUMENT NO. 168397-200-PO-3363-MC2-004 | P&ID SRP BOOSTER PUMPS (P-4203A / P-4203B) |
| DOCUMENT NO. 168397-200-PO-3363-MC2-012 | P&ID UTILITY STATIONS & INSTRUMENT AIR DISTRIBUTION |
| DOCUMENT NO. 168397-200-PO-3363-ID6-001 | ALARM & TRIP SCHEDULE - SRP BOOSTER PUMPS |

-From Bently Nevada to UCP XS-42101A common trip is SIL 1 category
 -Not in Flowserve scope

| | | | | | | |
|--|----------|-----------------|---------------|------|----------|-----|
| Naxen Petroleum (U.K.) Limited | | | | | | |
| VENDOR : FLOWERVE (MCC PW) | | | | | | |
| EQUIPMENT TITLE : SRB BOOSTER PUMPS | | | | | | |
| EQUIPMENT TAG NO(S) : P-4203A/PM-4203A | | | | | | |
| Vendor Document Number | | | | | | |
| Purchase Order No. | Doc | Type | Doc Sheet No. | Rev. | DATE | |
| 168397 - 200 - PO - 3363 - MC2 - 011 - 01 | Z1 | | | | 26/10/16 | |
| SUPPLIER DOCUMENT REVIEW | | | | | | |
| Rejected (Asai Code - REJ) - Quality and content is out of conformity with Company requirements. Document shall be revised by Supplier to incorporate the necessary changes and subsequently re-submitted. | | | | | | |
| Accepted With Comments (Asai Code - AGC) - Generally acceptable but elements require to be addressed. Document shall be revised by Supplier to incorporate the necessary changes and subsequently re-submitted. | | | | | | |
| Accepted As Final (Asai Code - FIN) - Documents are considered acceptable, do not re-submit. | | | | | | |
| Accepted for Information (Asai Code - AFI) - No further action required, do not re-submit. | | | | | | |
| Review of Vendor documents does not relieve Vendor of the responsibility for correctness under the Purchase Order. Permission to proceed does not constitute acceptance of design, detail and calculations, test methods or materials developed or selected by the Vendor and does not relieve the Vendor from full compliance with the Purchase Order or any other obligations, not detract from any of the Purchaser's rights. | | | | | | |
| Z1 | 26/10/16 | AD-HOC AS-BUILT | | | | |
| REV | DATE | DESCRIPTION | | DWN | CHK | APP |
| | | | | | | CLT |

| P.O. NUMBER | 4504790805 |
|----------------------|-------------------------------|
| CUSTOMER | Siemens Oil & Gas |
| JOB | Golden Eagle Area project |
| PLANT | Golden Eagle Area Development |
| END USER | Navien petroleum UK Limited |
| SERVICE | SRB Booster Pumps |
| ITEM | P-4203A / PM-4203A |
| SERIAL N. | |
| CUSTOMER INFORMATION | |
| REVISION | |
| ORDER NO. | 2011312-4135371 |
| DRAWN BY | DATE |
| CHECKED BY | DATE |
| APPROVED BY | DATE |
| Substituted | |
| CAN PIN | 2014428903 |
| SCALE | 1:1 |
| UNITS | mm |
| SHEET NO. | 1 OF 2 |