



- NOTE**
- 1 TYPICAL FIREDAMPER CONTROL SCHEMATIC
 - 2 ALL FIREDAMPERS TO BE PREFIXED UE7371
 - 3 SHORTENED FORM OF TAGGING ADOPTED TO IMPROVE READABILITY AND LIMIT CONGESTION IN ACCORDANCE TO AHL PROCEDURE E4-06 'ENGINEERING IDENTIFICATION SYSTEM,' PAGE 29, SECTION 13-1
 - 4 MCC INDICATES LOGIC INTERLOCK LOCATED IN ELECTRICAL SWITCHGEAR R116
 - 5 FOR OVERRIDE SIGNAL ZONE CONTROL SEE DRG: SCOTT-SE-L100-JN-DG-0009:00
 - 6 FOR EQUIPMENT TAG NUMBERS REFER TO HVAC DUCTING LAYOUT DIAGRAMS
 - 7 FOR FIRE & GAS INTERLOCKS SEE F&G CAUSE & EFFECTS SCOTT-SE-L100-FG-CH-0001 TO 27
 - 8 FIREDAMPER FD769 IS OFFSHORE INSTALLED.

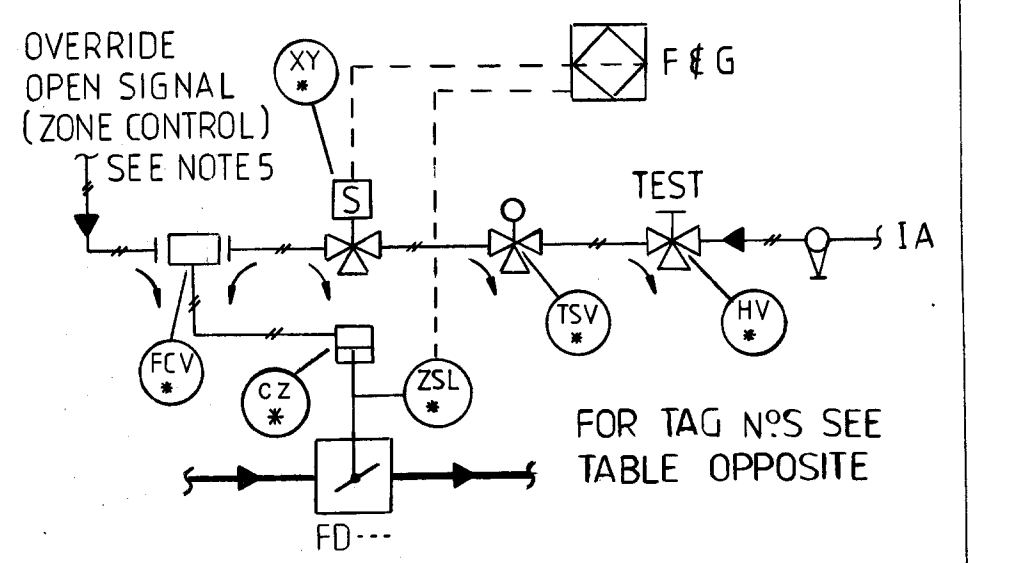

TAG NUMBERS						
F/DAMPER	CZ*	XY*	TSV*	HV*	FCV*	ZSL*
FD 724	40334A	40334A	40334A	40334A	40334A	40334A
FD 725	40335	40335	40335	40335	40335	40335
FD 726	40336	40336	40336	40336	40336	40336
FD 727	40337	40337	40337	40337	40337	40337
FD 728	40338	40338	40338	40338	40338	40338
FD 729	40339	40339	40339	40339	40339	40339
FD 730	40340	40340	40340	40340	40340	40340
FD 731	40341	40341	40341	40341	40341	40341
FD 732	40342	40342	40342	40342	40342	40342
FD 733	40343	40343	40343	40343	40343	40343
FD 734	40344	40344	40344	40344	40344	40344
FD 735	40345	40345	40345	40345	40345	40345
FD 736	40346	40346	40346	40346	40346	40346
FD 737	40347	40347	40347	40347	40347	40347
FD 738	40348	40348	40348	40348	40348	40348
FD 739	40349	40349	40349	40349	40349	40349
FD 762	40372	40372	40372	40372	40372	40372
FD 769	40379	40379	40379	40379	40379	40379

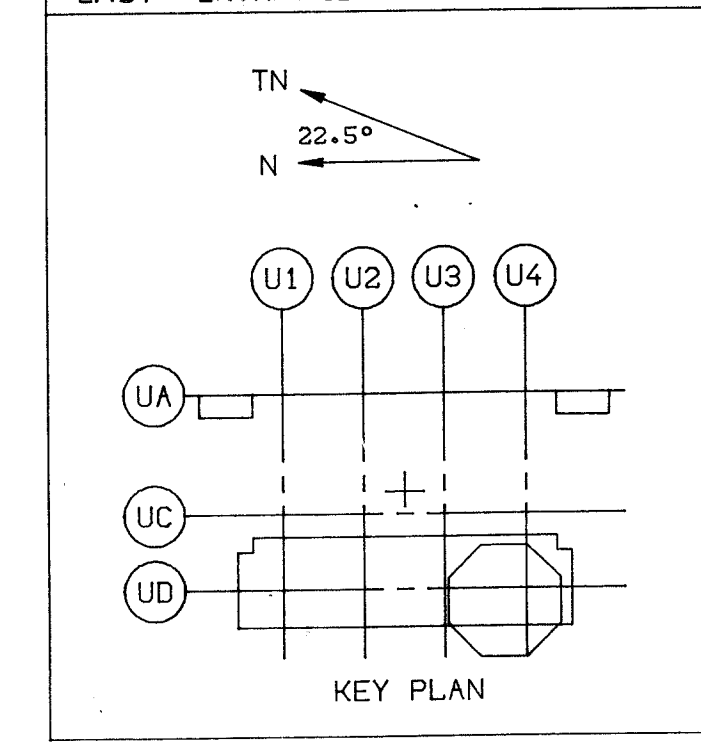

DRAWING	REV	TITLE
SCOTT-SE-L100-FG-CH-0001 TO 27		FIRE & GAS CAUSE & EFFECT DIAGS.
SCOTT-SE-L100-HV-SC-0002:00		HVAC DAMPER SCHEDULE
SCOTT-SE-L100-HV-DR-0030 TO 0051		HVAC DUCTING LAYOUT DIAGRAMS
SCOTT-SE-L100-JN-DG-0021:SERIES		HVAC/INST E&I BLOCK DIAGRAMS
SCOTT-SE-L100-HV-DR-0001:00 TO 0021:00		HVAC AIRFLOW DIAGRAMS
SCOTT-SE-L100-JN-SC-0001:00		HVAC/INST E&I LEGENDS & SYMBOLS
SCOTT-SE-L100-JN-CH-0001:00 TO 0010		HVAC/INST E&I CAUSE AND EFFECT DIAGRAMS

REV	REASON FOR ISSUE	DATE	DRN	CHK	SE APP	AHL REVIEW
10	NO CHANGE AS BUILT	5-1-93	RPL	MU		
0	APPROVED FOR CONSTRUCTION	2/11/92	RPL	IDW		
CD	APPROVED FOR DESIGN	11/10/91	NOP	AE		
C	RE-ISSUED FOR CLIENT COMMENT/REVIEW	2/1/91	RPL	NOP		
B	ISSUED FOR CLIENT COMMENT/REVIEW	11/7/91	RPL	NOP		
A	ISSUED FOR INTERNAL REVIEW/IDC	13/6/91	RPL	NOP		

MTD No	
AFD APPROVAL	
REV	SEPM AHL EM
AFC APPROVAL	
REV	SEPM AHL EM
TITLE	HVAC/INSTRUMENT E&I DUCTING INSTRUMENT DIAGRAM GENERAL EXHAUST SYSTEM
NTS	DRAWING NO. SCOTT-SE-L100-JN-DG-0004:0010
ORIGINAL SCALE	PROJECT ORIG AREA/MOD DISC TYPE SEQ.No SHT REV

AMERADA HESS LIMITED
SCOTT FIELD DEVELOPMENT
SITE AS BUILT
CONTRACT C1018



SLP ENGINEERING LIMITED
SLP ENGINEERING LTD.
HAMILTON ROAD.
LORESTOFT.
SUFFOLK. NR32 1XF.
TEL: 0502-587322
TELEX: 975401
FAX: 0502-512589

