


710296/201-3

TO/FROM 710296/201-2

FOR NOTES REFER TO DRG. 710296/201-1
SEQ-1222-ME-01-C01-0001
FOR PARTS LIST REFER TO DOC. SEQ-1222-ME-01-C13-0003

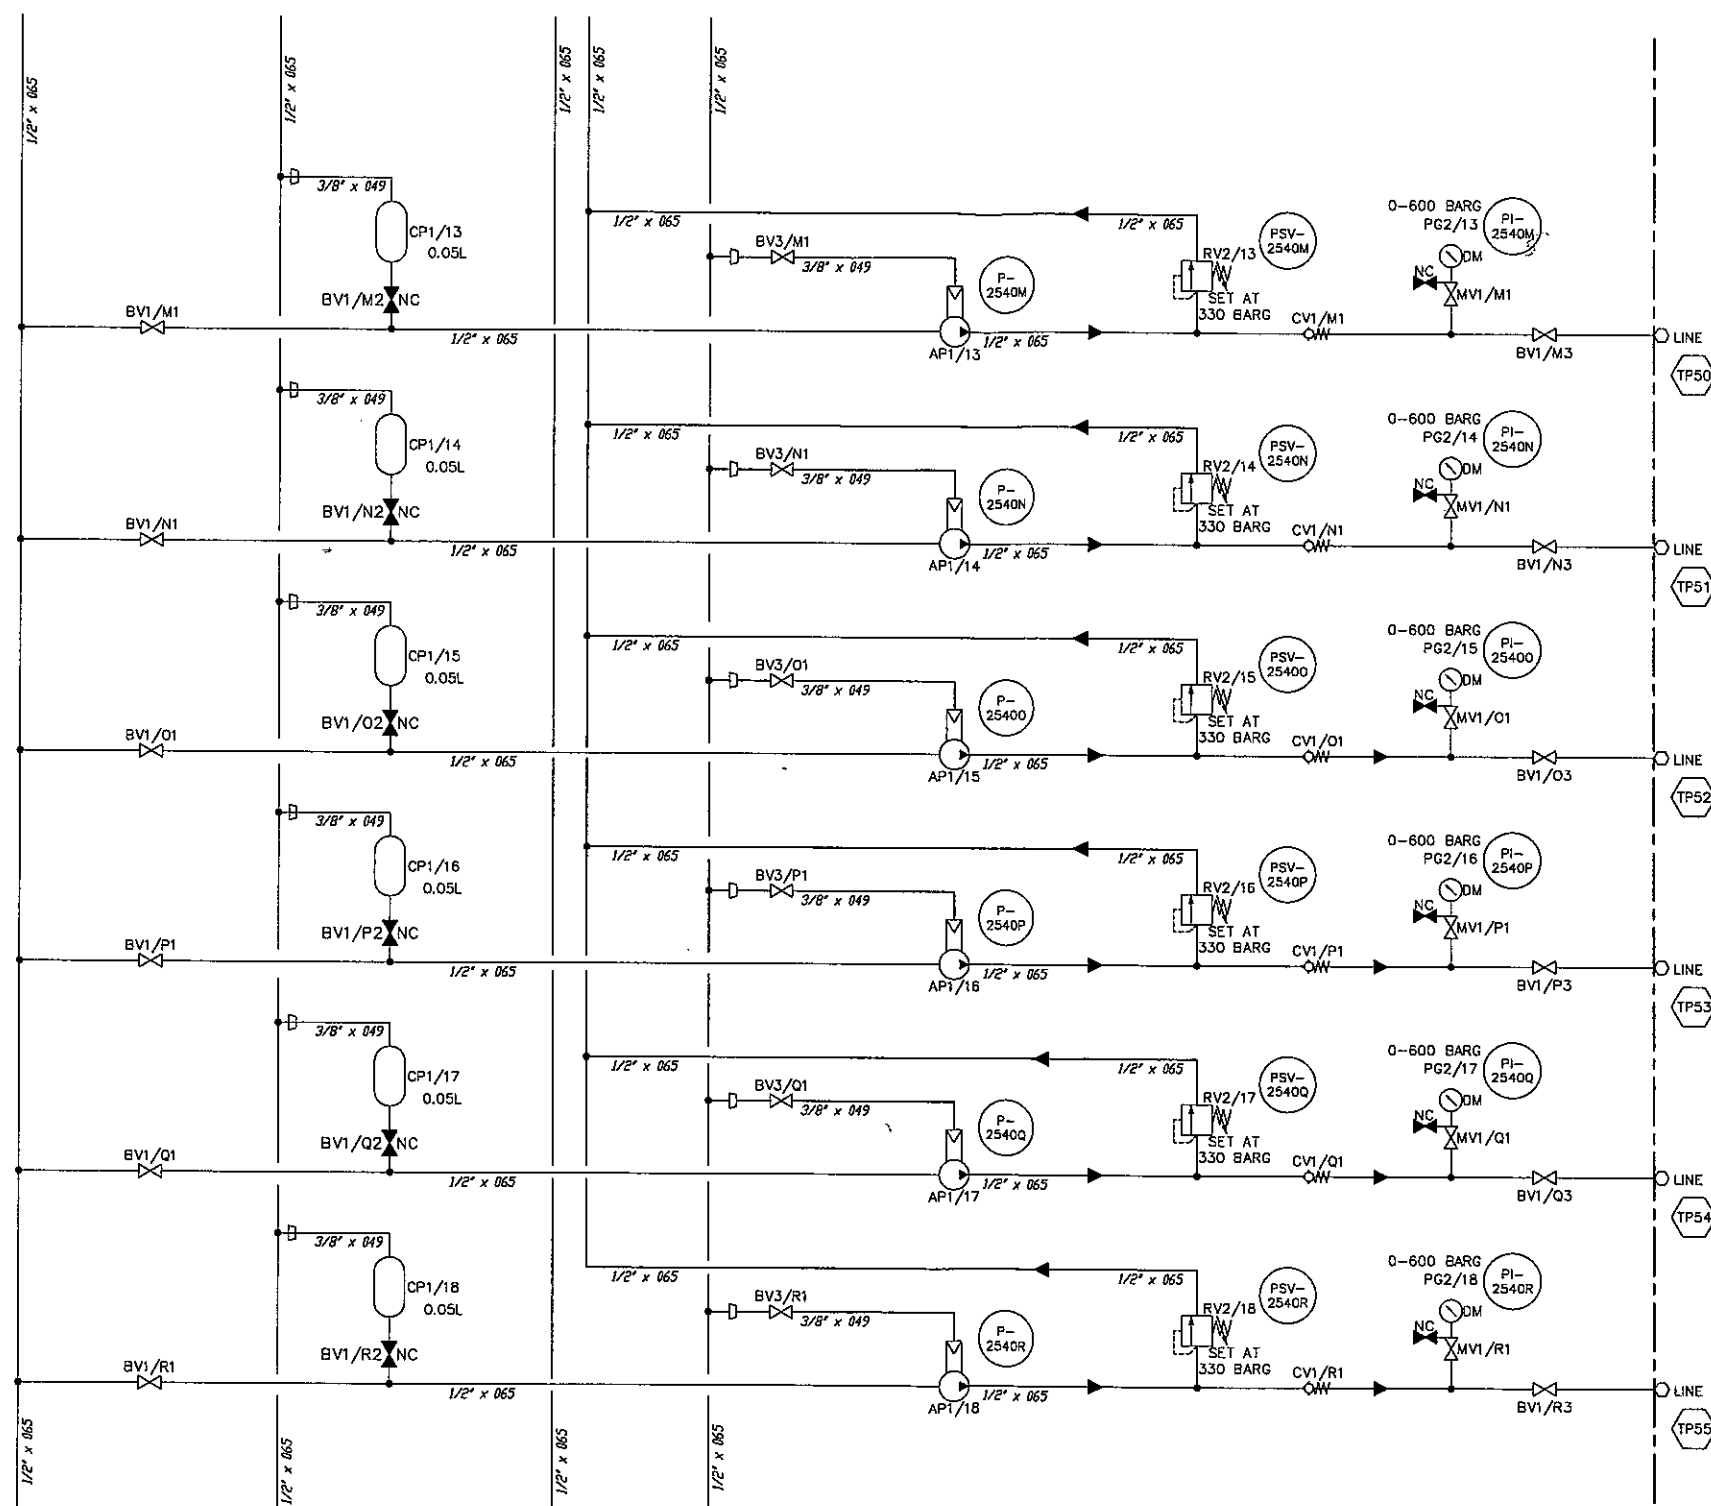

TP SCHEDULE

TP50	1/2" PARKER A-LOK B/H	INJECTION LINE M
TP51	1/2" PARKER A-LOK B/H	INJECTION LINE N
TP52	1/2" PARKER A-LOK B/H	INJECTION LINE O
TP53	1/2" PARKER A-LOK B/H	INJECTION LINE P
TP54	1/2" PARKER A-LOK B/H	INJECTION LINE Q
TP55	1/2" PARKER A-LOK B/H	INJECTION LINE R



ISSUED FOR APPROVAL

ORIGINAL
IF RED

Review of supplier's data does not relieve supplier of responsibility for correctness under terms of contract.

CODE	COMMENT	ACTION REQUIRED	MANUFACTURE
E	ACCEPTED	DO NOT RE-SUBMIT UNLESS DATA IS MODIFIED	MAY PROCEED
A	ACCEPTED WITH COMMENT	FULLY INCORPORATE COMMENTS & RE-SUBMIT DOCUMENTS	MAY PROCEED
B	REJECTED	FULLY INCORPORATE COMMENTS & RE-SUBMIT DOCUMENTS	MUST NOT PROCEED
I	INFORMATION ONLY	NO IMPACT ON MANUFACTURE. DO NOT RE-SUBMIT	MAY PROCEED

SIRL Code: C01

Purchase Document No:

SEQ-1222-ME-01-C01-0003

Purchase Revision:

04

Client Review Signature:

[Signature]
04/12/06

Rev	B	1	2	3
Description	ISSUED FOR APPROVAL	REVISED & ISSUED FOR MANUFACTURE	REVISED & RE-ISSUED FOR MANUFACTURE C.S.No.2282	REVISED & ISSUED 'AS BUILT' C.S.No.2298
Date Orig App	31/8/06 LD	18/10/06 AD SC	2/11/06 AD SC	21/11/06 AD SC

IF IN DOUBT ASK

This drawing is confidential and copyright property of © Tyco Fire & Integrated Solutions and must not be copied or lent without their written permission.

Orig	LD	31/8/06
Chd	SC	27/08/06
App	MW	27/08/06

tyco
Fire & Integrated Solutions

Oil & Gas/Marine
Jarrod Way, Bowthorpe,
Norwich, Norfolk
NR5 9JD England

Tel: +44 (0) 1603 201201
Fax: +44 (0) 1603 201333
www.tycofs.com

Project
AKER KVAERNER
SCOTT PLATFORM
SCALE INHIBITOR PACKAGE MY-2540

Contract No.
WN710296

Drawing Title
P & I.D.

Drg No
710296/201-3

Rev
3