

CR 0.00000


HXL-2A/B  
SERVICE : MINERAL OIL PLATE COOLER  
DUTY : 55 kW  
WARM PLATE DESIGN PRES./TEMP. : 18.5 bar G/100 °C  
MATERIALS OF CONSTR. : TITANIUM PLATES

NOTES:

- 1 N°2 x 100% COOLERS (ONE OPERATING & ONE IN STAND-BY). THAT AVOID RISK OF OIL-WATER CONTAMINATION IN CASE OF GASKET FAILURE. BOTH COOLERS ARE EQUIPPED WITH ANTI MIXING GASKETS WITH ATMOSPHERIC LOCALLY DRAINED GAP.
- 2 INSULATION FOR PERSONNEL PROTECTION.

EQUIPMENT TAG NUMBERS

N.P. TAG n°	DESCRIPTION	CUSTOMER TAG n°	
		X-7001A	X-7001B
HXL-2A	MINERAL OIL MAIN COOLER	E-7056A-01	E-7056B-01
HXL-2B	MINERAL OIL STAND-BY COOLER	E-7056A-02	E-7056B-02

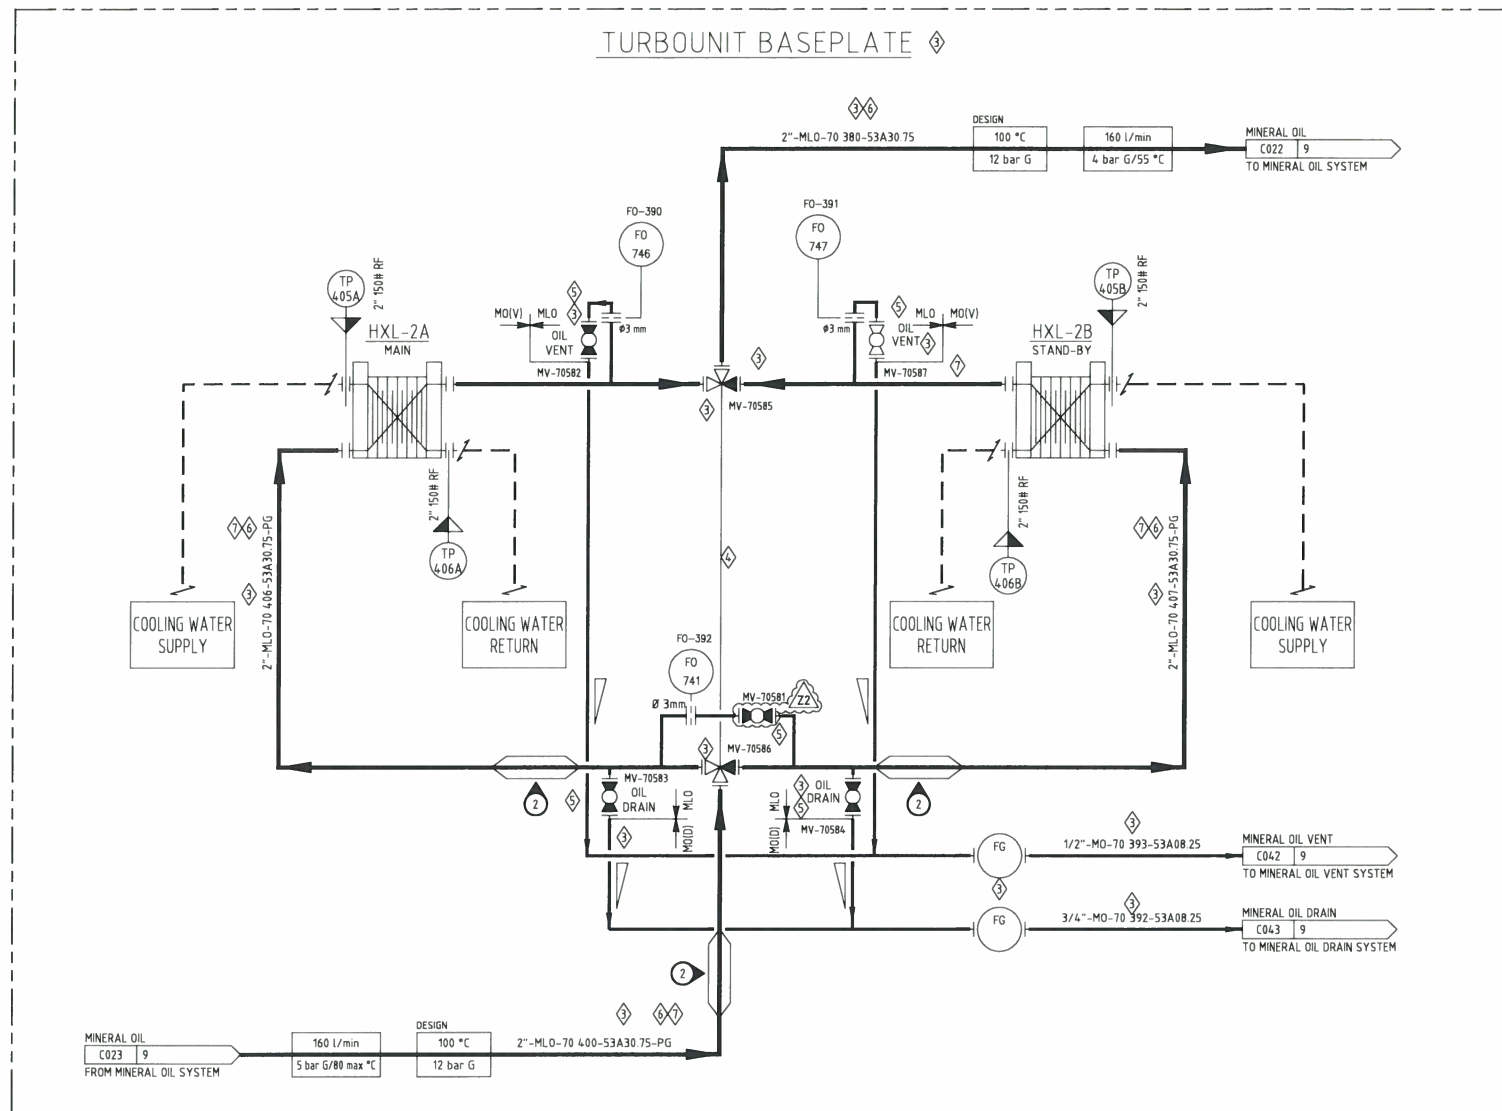

Nexen Petroleum (U.K.) Limited						
VENDOR : GE Nuova Pignone (AMEC FW)						
EQUIPMENT TITLE : PIPING & INSTRUMENT DIAGRAMS						
EQUIPMENT TAG NO(S) : X-7001A/B, X-5701A/B						
Vendor Document Number						
Purchase Order No	Doc No	Type No	Seq. No	Sheet No	Rev.	DATE
168397 - 200 - PO - 3270 - MC2 - 001 - 13					Z2	4/8/17
SUPPLIER DOCUMENT REVIEW						
Rejected (Assai Code = REJ) - Quality and content is out of conformity with Company requirements. Document shall be revised by Supplier to incorporate the necessary changes and subsequently re-submitted.						
Accepted With Comments (Assai Code = AWC) - Generally acceptable but elements require to be addressed. Document shall be revised by Supplier to incorporate the necessary changes and subsequently re-submitted.						
Accepted As Final (Assai Code = FN) - Documents are considered acceptable, do not re-submit.						
Accepted For Information (Assai Code = AFI) - No further action required, do not re-submit.						
Review of Vendor documents does not relieve Vendor of the responsibility for correctness under the Purchase Order. Permission to proceed does not constitute acceptance of design, detail and calculations, test methods or materials developed or selected by the Vendor and does not relieve the Vendor from full compliance with the Purchase Order or any other obligations, not detract from any of the Purchaser's rights.						
Z2	4/8/17	AS-BUILT FOR GIC0046			hm	kl
REV	DATE	DESCRIPTION			DRN	CHK
					APP	CLT

GE Oil & Gas	TITLE : MINERAL OIL COOLING P&I DIAGRAM	DOCUMENT CODE : SOM5081932	REVISION : 11
REVISION DESCRIPTION : NO REVISION IS INTRODUCED IN THIS SHEET	PAGE MARKER : N/A	SECURITY CODE : N	LANGUAGE : A
ORIGINAL JOB : 1709636-37	SIZE : 1	SHEET : 13 of 21	
THIS DOCUMENT IS AND CONTAINS CONFIDENTIAL AND PROPRIETARY INFORMATION OF Nuova Pignone S.r.l. WHICH SHALL NOT BE USED OR DISCLOSED TO OTHERS, EXCEPT WITH THE WRITTEN PERMISSION OF Nuova Pignone S.r.l. ALL RIGHTS RESERVED.			

REVISE WITH PIGXP ONLY