


- NOTE**  
1 TYPICAL FIREDAMPER CONTROL SCHEMATIC
- 2 ALL FIREDAMPERS PREFIXED BY -UE7371
- 3 FOR OVERRIDE SIGNAL ZONE CONTROL SEE DRG. SCOTT-SE-L100-JN-DG-0009-00
- 4 SHORTENED FORM OF TAGGING ADOPTED TO IMPROVE READABILITY AND LIMIT CONGESTION IN ACCORDANCE TO AHL PROCEDURE E4-06 ENGINEERING IDENTIFICATION SYSTEM, PAGE 29, SECTION 13.1
- 5 FOR FIRE & GAS INTERLOCKS SEE F & G CAUSE & EFFECTS SCOTT-SE-L100-FG-CH-0001 TO 27

TAG NUMBERS						
F/DAMPER	CZ*	XY*	TSV*	HV*	FCV*	ZSL*
FD 706	40316	40316	40316	40316	40316	40316
FD 707	40317	40317	40317	40317	40317	40317
FD 708	40318	40318	40318	40318	40318	40318
FD 709	40319	40319	40319	40319	40319	40319
FD 710	40320	40320	40320	40320	40320	40320
FD 711	40321	40321	40321	40321	40321	40321
FD 712	40322	40322	40322	40322	40322	40322
FD 713	40323	40323	40323	40323	40323	40323
FD 714	40324	40324	40324	40324	40324	40324
FD 715	40325	40325	40325	40325	40325	40325
FD 716	40326	40326	40326	40326	40326	40326
FD 717	40327	40327	40327	40327	40327	40327
FD 718	40328	40328	40328	40328	40328	40328
FD 719	40329	40329	40329	40329	40329	40329
FD 720	40330	40330	40330	40330	40330	40330
FD 721	40331	40331	40331	40331	40331	40331

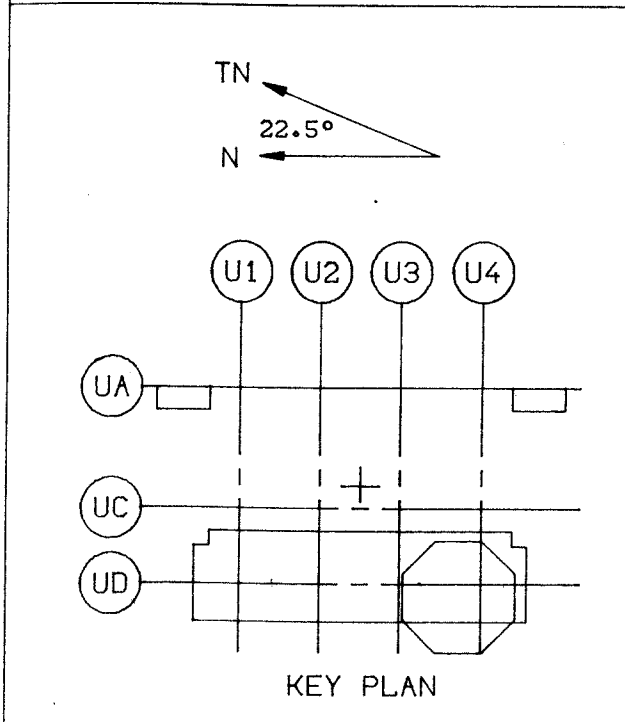

REFERENCE DRAWINGS		TITLE
DRAWING	REV	
SCOTT-SE-L100-FG-CH-0001 TO 27		FIRE & GAS CAUSE & EFFECT DIAGS.
SCOTT-SE-L100-HV-SC-0002:00		HVAC DAMPER SCHEDULE
SCOTT-SE-L100-JN-DG-0021:SERIES		HVAC/INST E&I BLOCK DIAGRAMS
SCOTT-SE-L100-CH-0001 TO 0010		HVAC/INST E&I CAUSE AND EFFECT DIAGRAMS
SCOTT-SE-L100-HV-DR-0001 TO 0021		HVAC AIRFLOW DIAGRAMS
SCOTT-SE-L100-JN-SC-0001:00		HVAC/INST E&I LEGENDS & SYMBOLS

THIS DRAWING IS THE PROPERTY OF SLP ENGINEERING LTD AND MUST NOT BE COPIED, REPRODUCED, OR SHOWN TO A THIRD PARTY WITHOUT THE WRITTEN CONSENT OF SLP ENGINEERING LTD.

AMERADA HESS LIMITED SCOTT FIELD DEVELOPMENT SITE AS BUILT CONTRACT C1018				MTD No			
10	NO CHANGE AS BUILT	5-1-93	APL	NOV	NOV	NOV	NOV
0	APPROVED FOR CONSTRUCTION	4/11/92	APL	IDW	NOV	NOV	NOV
CD	APPROVED FOR DESIGN	11/10/91	NOV	NOV	NOV	NOV	NOV
C	RE-ISSUED FOR CLIENT REVIEW/COMMENT	3-9-91	JG	NOV	NOV	NOV	NOV
B	ISSUED FOR CLIENT REVIEW/COMMENT	3/7/91	NOV	NOV	NOV	NOV	NOV
A	ISSUED FOR INTERNAL COMMENT/IDC	11/6/91	NOV	NOV	NOV	NOV	NOV
REV	REASON FOR ISSUE	DATE	DRN	CHK	LE	DM/PE	SM
					SE APP	AHL REVIEW	

AMERADA HESS LIMITED  
SCOTT FIELD DEVELOPMENT

**HESS**

**SLP** SLP ENGINEERING LIMITED  
SLP ENGINEERING LTD.  
HAMILTON ROAD,  
LOWESTOFT,  
SUFFOLK, NR32 1XP.

TEL: 0502-587322  
TELEX: 975401  
FAX: 0502-512589

TITLE HVAC/INSTRUMENTS E&I  
DUCTING & INSTRUMENT DIAGRAM  
GENERAL A/C SUPPLY SYSTEM

NTS DRAWING NO.  
SCOTT-SE-L100-JN-DG-0002-00 10

ORIGINAL SCALE	PROJECT	ORIG	AREA/MOD	DISC	TYPE	SEQ. No	SHT	REV