


REV	DATE	DESCRIPTION	DWN	CHK	APP
08	03/12/13	As Built	PPVole	Chiggers	Murkiss
07	25/9/13	As Built	PPVole	Chiggers	Murkiss
06	12/9/13	As Built	PPVole	Chiggers	Murkiss
05	19/11/12	Revised	BRADNE	SCAFFER	REGGERS
04	29/10/12	Revised	BRADNE	SCAFFER	REGGERS
03	05/08/12	Revised	SCAFFER	SAVATIER	REGGERS
02	30/05/12	Revised	BRADNE	SCAFFER	REGGERS
01	03/12/11	As Built	PPVole	Chiggers	Murkiss

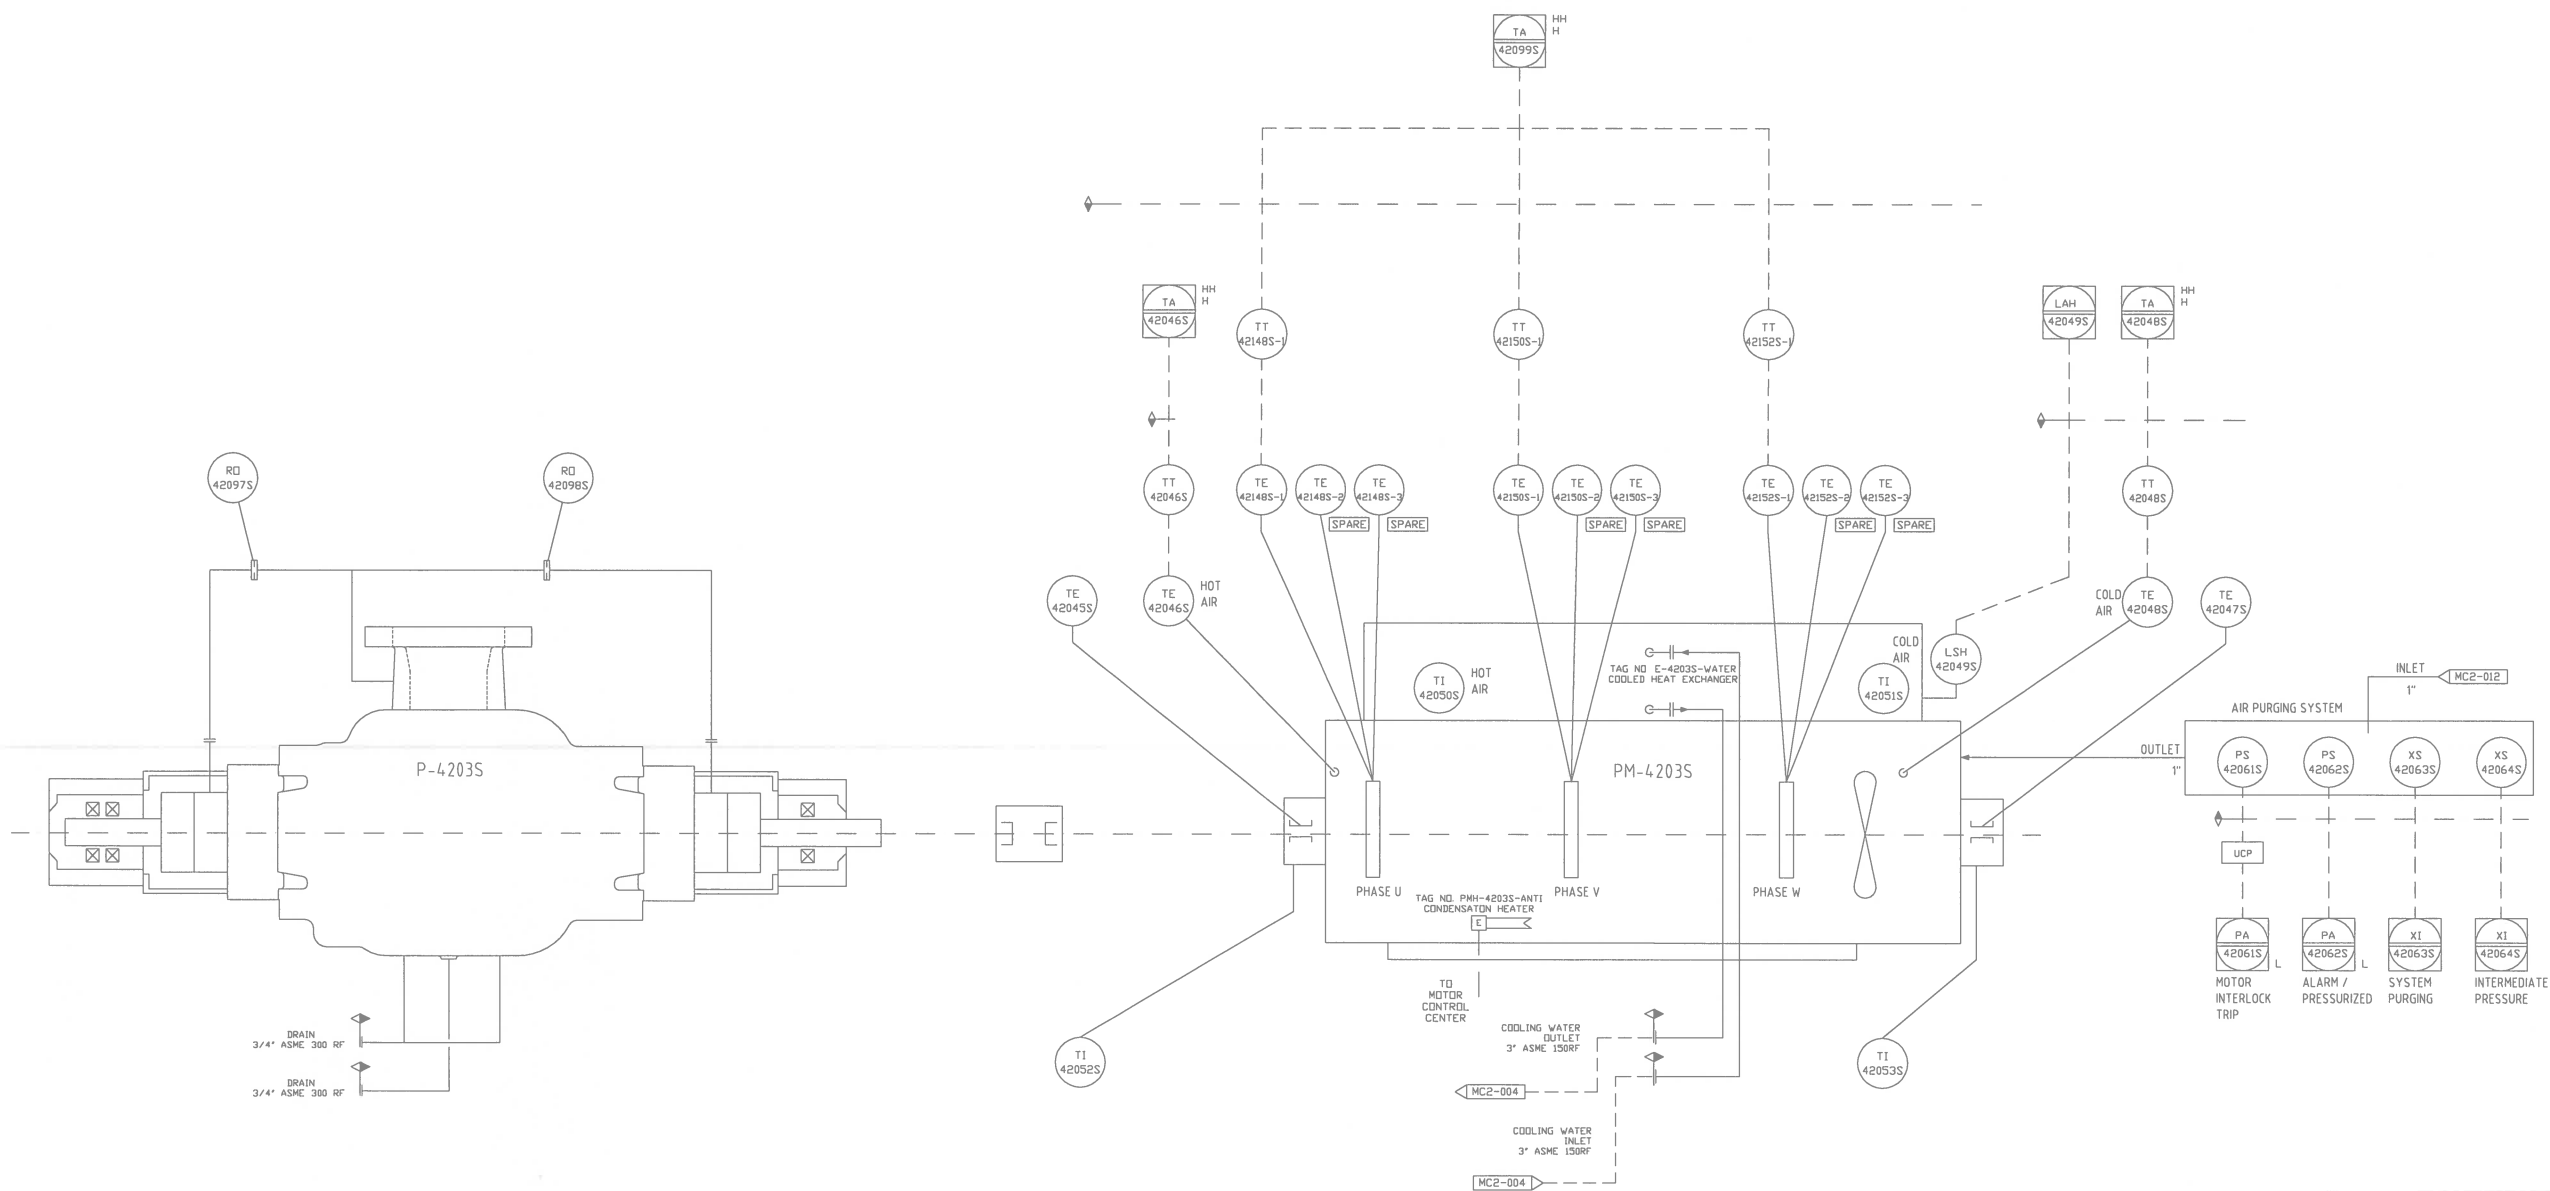

Nexen Petroleum (U.K.) Limited	
VENDOR : FLOWERVE (AMEC FW)	
EQUIPMENT TITLE : SRB BOOSTER PUMPS	
EQUIPMENT TAG NO(S) : SPARE - INSURANCE PUMP/MOTOR	
Purchase Order	Doc Type
168397 - 200 - PO - 3363 - MC2 - 011 - 03	Sec Sheet
Rev.	DATE
Z1	26/11/16
SUPPLIER DOCUMENT REVIEW	
Rejected (Asal Code - REJ) - Quality and content is out of conformity with Company requirements. Document shall be revised by Supplier to incorporate the necessary changes and subsequently re-submitted.	
Accepted With Comments (Asal Code - AWC) - Generally acceptable but elements require to be addressed. Document shall be revised by Supplier to incorporate the necessary changes and subsequently re-submitted.	
Accepted As Final (Asal Code - FIN) - Documents are considered acceptable, do not re-submit.	
Accepted For Information (Asal Code - AFI) - No further action required, do not re-submit.	
Review of Vendor documents does not relieve Vendor of the responsibility for correctness under the Purchase Order. Permission to proceed does not constitute acceptance of design, detail and calculations, test methods or materials developed or selected by the Vendor and does not release the Vendor from full compliance with the Purchase Order or any other obligations, not detract from any of the Purchaser's rights.	
Z1	26/11/16
Rev.	DATE
DESCRIPTION	DRN
DESCRIPTION	CHK
DESCRIPTION	APP
DESCRIPTION	CLT

OTHER	FPD SUPPLY LIMIT
FPD	GLOBE VALVE CLOSED
---	ELECTRIC SIGNAL
---	SERIAL COMMUNICATION
---	INSTRUMENT AIR
---	INSULATION
---	ELECTRIC TRACING
PIPING AND INSTRUMENTS LEGEND	

CONDITION MONITORING SYSTEM (WITHIN UCP)	HIGH
INSTRUMENT ON LOCAL PANEL	LOW
BOARD MOUNTED INSTRUMENT	ICSS
LOCAL MOUNTED INSTRUMENT	UCP
MOUNTED BEHIND LOCAL PANEL	
RACK MOUNTED (OR BACK OF PANEL)	

DOCUMENT NO. 168397-200-PO-3363-MC2-004 - P&ID SRP BOOSTER PUMPS (P-4203A / P-4203B)
DOCUMENT NO. 168397-200-PO-3363-MC2-012 - P&ID UTILITY STATIONS & INSTRUMENT AIR DISTRIBUTION
DOCUMENT NO. 168397-200-PO-3363-ID6-001 - ALARM & TRIP SCHEDULE - SRP BOOSTER PUMPS

P.O. NUMBER	4504790805
CUSTOMER	Siemens Oil & Gas
JOB	Golden Eagle Area project
PLANT	Golden Eagle Area Development
END USER	Nexen petroleum UK Limited
SERVICE	SRB Booster Pumps
ITEM	P-4203S X PM-4203S
SERIAL N.	
CUSTOMER INFORMATION	
STATUS OF APPROVAL	REVISED
ORDER NO.	20113E-4133381
DRAWN BY	DATE
CHECKED BY	DATE
APPROVED BY	DATE
Substituted	
DATE	26/11/16
SCALE	UNITS mm
SHEET NO.	3/3