


ORIGINAL

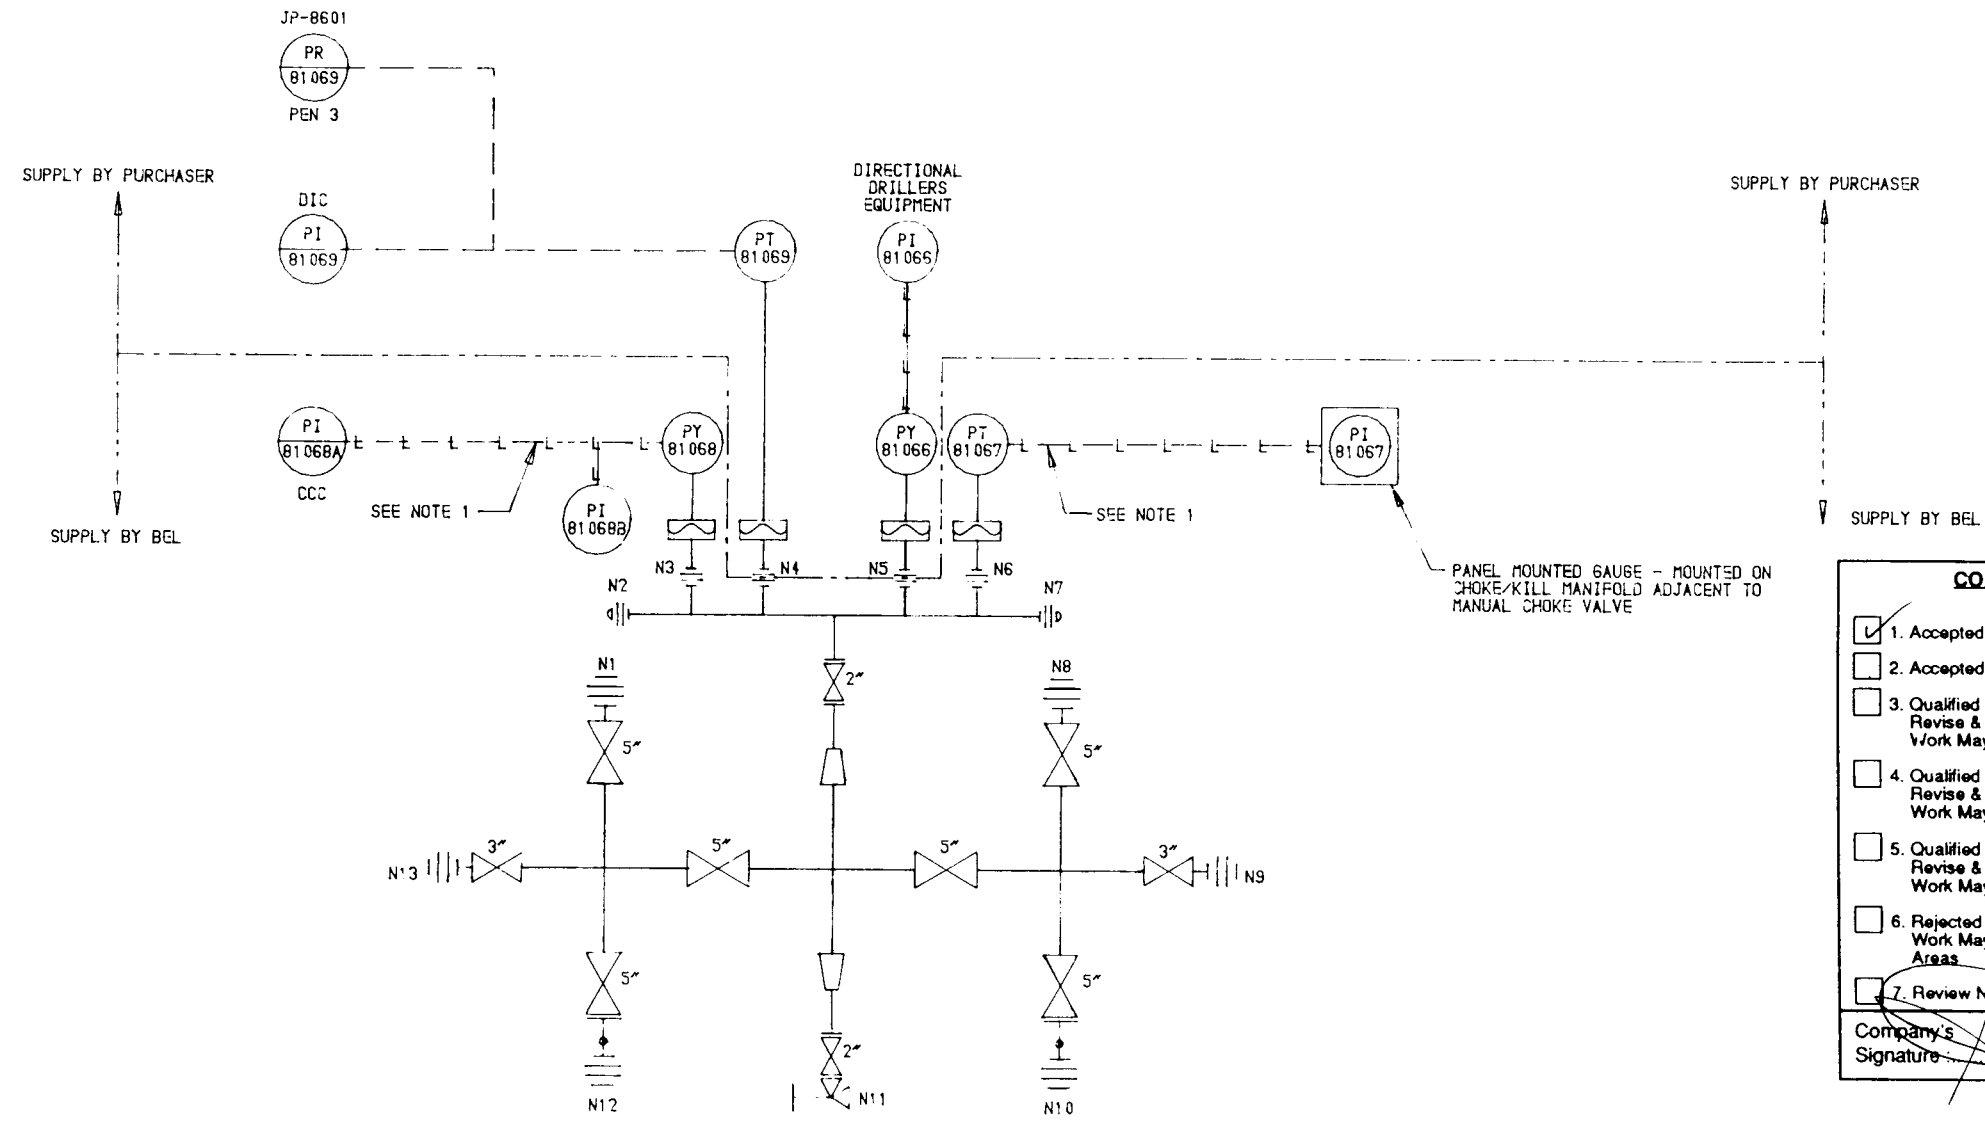

AS SUPPLIED

Seller shall complete both Sections A & B, sign & date

A

All Company comments on previous submission have been fully incorporated

☐ Yes ☐ No ☒ Not Applicable

B

There are no design changes, other than incorporation of Company comments, from previous submission

☐ Yes ☒ No

Seller's Verifying Statement:  
This document accurately represents the "As Supplied" condition of the Work

Sellers Authorised Signature: *Blum* Date: 11-2-92

COMPANY RETURN CODES

☒ 1. Accepted "As Supplied"  
☐ 2. Accepted - No Comments  
☐ 3. Qualified Acceptance - Minor Comments. Revise & Resubmit as "As Supplied" Work May Proceed  
☐ 4. Qualified Acceptance - Minor Comments. Revise & Resubmit To Obtain Code ? Work May Proceed  
☐ 5. Qualified Acceptance - Major Comments. Revise & Resubmit To Obtain Code ? Work May Proceed  
☐ 6. Rejected - Revise & Resubmit Immediately Work May Not Proceed In The Affected Areas  
☐ 7. Review Not Required

Company's Signature: *[Signature]* Date: 19/2/92

AMERADA HESS LIMITED

SCOTT FIELD DEVELOPMENT

Package Desc

PIPING & INSTRUMENT DIAG

Equip Nos

DN 8101

S. RS Codes

D 01

Module

D2

Sheet 1 of 1

Purchase Order No

Document No

Rev

DOCC-DR-EM

COI2-POI20

D

010102

016

- NOTES
- THE HYDRAULIC PRESSURE TRANSMITTERS WILL BE HARD PIPED TO A COMMON TERMINAL PLATE LOCATED AT THE TOP LEFT HAND CORNER OF THE SKID FRAME (INTERFACE SHALL BE 1/2"NPT FEMALE)
  - TERMINAL POINTS N4 & N5 WILL BE SUPPLIED AS 2"NPT FEMALE TO MATE WITH PT81069 & PY81066 (SUPPLIED BY MARTIN DECKER)

4	26-6-91	BE	CUSTOMER COMMENTS RECEIVED
3	7-5-91	BE	
2	5-4-91	BE	
1	8-2-91	BE	
REV.	DATE	BY	CHANGE NOTE No.
No. OFF PER SET			SCALE
MATERIAL			
BEL VALVES LTD. ST. PETERS, NEWCASTLE-UPON-TYNE.			
SIZE	TITLE:-		
A3	STANDPIPE MANIFOLD P&ID		
DRAWN	B. EMMERSON	8-1-91	DRAWING No.
CHECKED	B. ARNOLD	8-1-91	T200-2194
			REV.
			4

THIS DRAWING AND THE COPYRIGHT THEREIN ARE THE PROPERTY OF BEL VALVES LTD. AND ALL INFORMATION WHICH IT CONTAINS IS CONFIDENTIAL THE DRAWING MUST NOT BE REPRODUCED OR DISCLOSED NOR MUST ANY INFORMATION TAKEN THEREFROM BE DISCLOSED WITHOUT THE PRIOR CONSENT IN WRITING FROM BEL VALVES LTD.	COMPONENT IDENTIFICATION		EXCEPT WHERE OTHERWISE STATED		ALL DIMENSIONS ARE IN INCHES				
	T	W.O.	CAST No.	ONE DECIMAL PLACE - .060 TOLERANCE	~	∇	∇∇	∇∇∇	NOTE
	TO BE MARKED WHERE SHOWN THUS <input checked="" type="checkbox"/>			TWO - .010 THREE - .005	DRESSED DEBURRED DESCALED	GENERAL MACHINE FINISH 125 ✓	SMOOTH MACHINE FINISH 63 ✓	FINE MACHINE FINISH 32 ✓	SPECIAL FINISHES

813-050760-01-1T  
813050760011  
HAYS