


TERMINAL POINT LIST		DESC. OF CONNECTION	DESIGN FLOW M <sup>3</sup> /H	PRESSURE BAR		TEMPERATURE C	
				OPERATING	DESIGN	OPERATING	DESIGN
TP1	10" NB ANSI 150 R.F.	BOOSTER PUMP SUCTION	693.6	9.6	19.7	60	70
TP2	8" NB ANSI 150 R.F.	BOOSTER PUMP DELIVERY	693.6	12.78	19.7	60	70
TP3	3/4" NB ANSI 150 R.F.	VENT TO FLARE	-	12.78	19.7	60	70
TP4A	3/4" NB ANSI 150 R.F.	MAIN PUMP DRAIN	-	12.78	19.7	60	70
TP4B	3/4" NB ANSI 150 R.F.	MAIN PUMP DRAIN	-	12.78	19.7	60	70
TP5							
TP6							
TP7	1/2" N.P.T. OPEN	SEAL LEAKAGE CONNECTION	-	1	19.12	60	70
TP8	3/4"NB ANSI 150 R.F.	SEAL SYSTEM C.W. SUPPLY	0.81	4.5	18.7	10	60
TP9	3/4"NB ANSI 150 R.F.	SEAL SYSTEM C.W. RETURN	0.81	4.5	18.7	10	60
TP10	1"NB ANSI 300 R.F.	SEALANT SUPPLY CONNECTION	0.27	25	45	80	80
TP11	1"NB ANSI 300 R.F.	SEALANT RETURN CONNECTION	0.27	25	45	60	80
TP12	1"NB ANSI 300 R.F.	ACCUMULATOR SEALANT SUPPLY	0.27	25	45	60	80
TP13	1"NB ANSI 300 R.F.	ACCUMULATOR SEALANT RETURN	0.27	25	45	60	80
TP14	1/2"NB ANSI 150 R.F.	ACCUMULATOR AIR SUPPLY	20	3.5	12.5	30/-7	60
TP15	1/2"NB ANSI 300 R.F.	SYSTEM DRAIN CONNECTION	-	25	45	60	80
TP16	1/2"NB ANSI 150 R.F.	DRIP TRAY DRAIN CONNECTION	-	1	18.7	10	60
TP17	1/2" NPT	GLAND BOWL DRAIN	-	1	18.7	10	60

COMPANY RETURN CODES		AMERADA HESS LIMITED	
<input checked="" type="checkbox"/> 1. Accepted "As supplied" <input type="checkbox"/> 2. Accepted - No Comments <input type="checkbox"/> 3. Qualified Acceptance - Minor Comments. Revise & Resubmit as "As Supplied" Work May Proceed <input type="checkbox"/> 4. Qualified Acceptance - Minor Comments. Revise & Resubmit To Obtain Code 2. Work May Proceed <input type="checkbox"/> 5. Qualified Acceptance - Major Comments. Revise & Resubmit To Obtain Code 2. Work May Proceed <input type="checkbox"/> 6. Rejected - Revise & Resubmit Immediately Work May Not Proceed In The Affected Areas <input type="checkbox"/> 7. Revision Required		SCOTT FIELD DEVELOPMENT Package Desc: OIL EXPORT AND BOOSTER PUMPS Equip Nos: PY0101A/B/C SFG Code: D01 Module: DP Sheet 1 of 1 Purchase Order No: P0041 Document No: D 01003 Rev: 06	
Company Signature: <i>[Signature]</i> Date: <i>[Date]</i>			

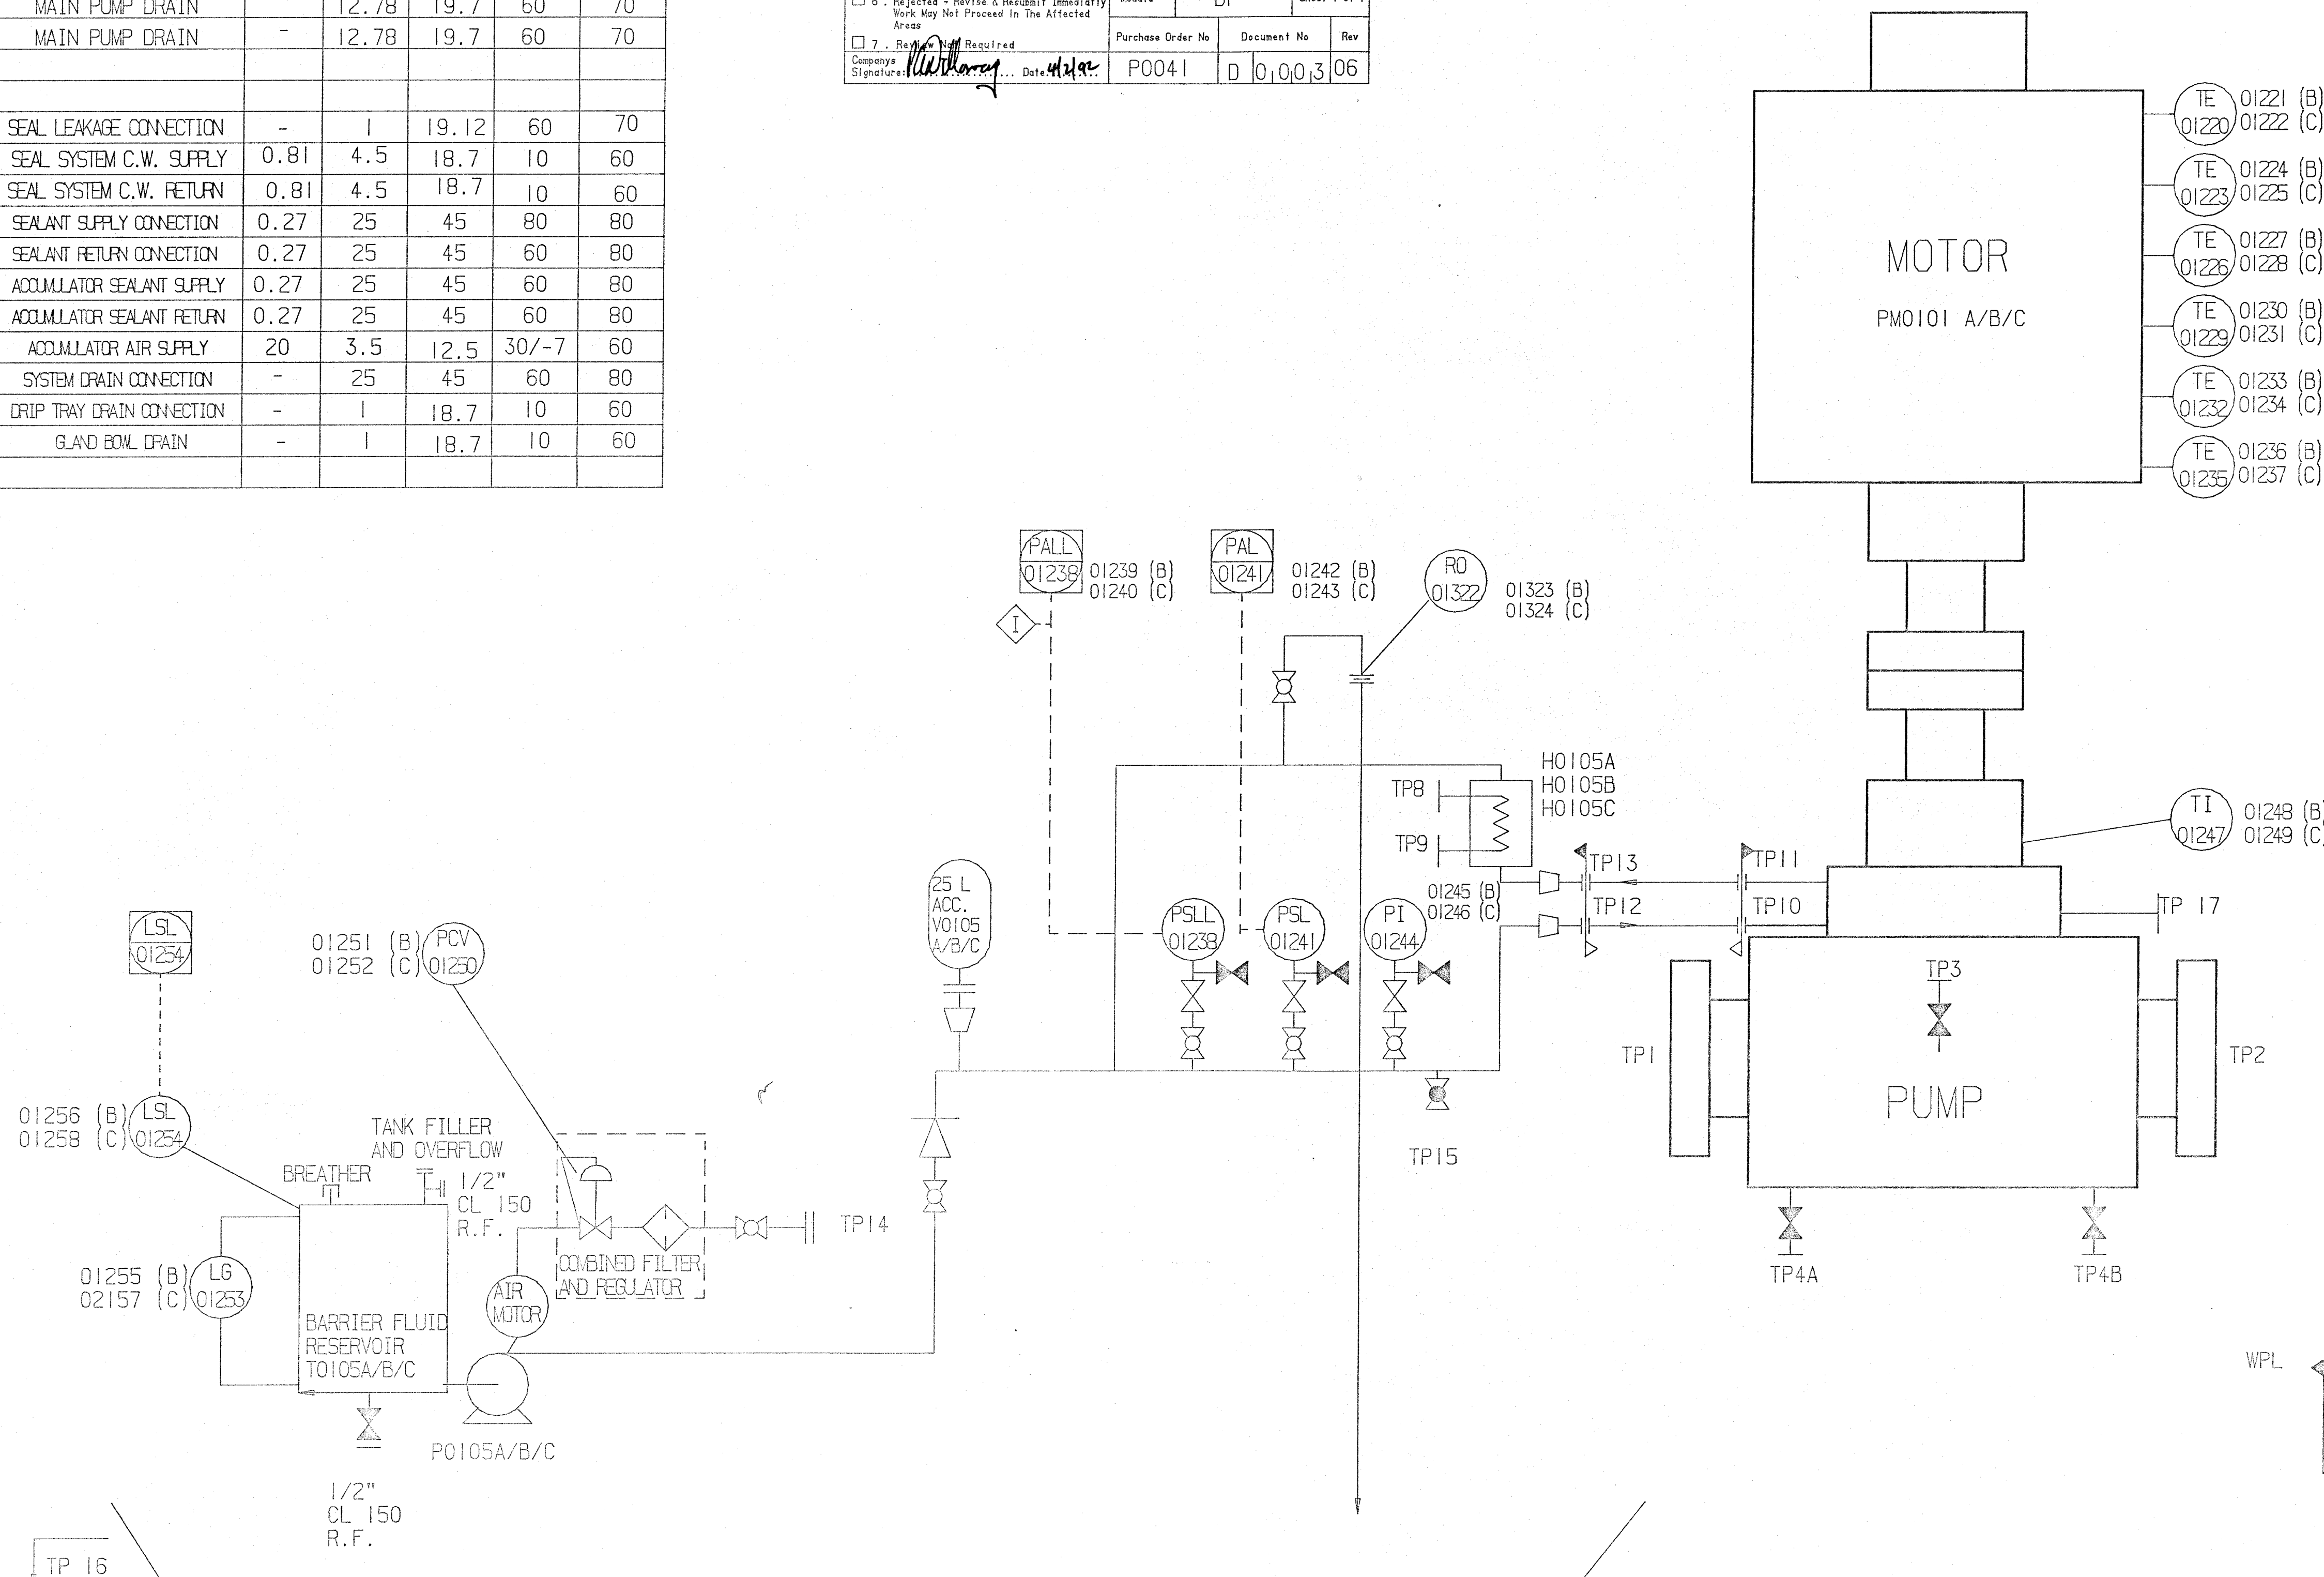

**AS SUPPLIED**  
 Sellers statement:  
 This document accurately  
 represents the as supplied  
 condition of the work  
 Suber's Authorized Signature: *[Signature]* 30/10/91

**FINAL CERTIFIED**  
 SIG. *[Signature]*  
 DATE 30/10/91  
 WEIR PUMPS LTD.

THIS DRAWING IS OWNED  
 BY  
**WEIR PUMPS  
 LIMITED**

AND IS CONDITIONALLY  
 LOANED TO THE RECIPIENT  
 WHO BY RECEIVING IT HAS  
 AGREED NOT TO REPRODUCE  
 OR COPY IT IN WHOLE OR  
 IN PART NOR TO FURNISH  
 INFORMATION FROM IT TO  
 OTHERS NOR TO MAKE ANY  
 USE OF IT THAT IS NOT  
 THE SUBJECT OF WRITTEN  
 AGREEMENT BY WEIR  
 PUMPS LIMITED AND TO  
 RETURN IT UPON REQUEST.

ISSUE NO.	REVISION, SIG. & DATE	ORIGINAL ISSUE	SEE ECR 7114 IN 4/23/91	DRIP TRAY ADDED FOR SEAL SYSTEM IN 12/5/91	DRG REVISED BY LINE WITH FLEXIDUX DRG IN 12/5/91	CLIENTS COMMENTS IN 21/10/91	DRG AS BUILT IN 24/10/91
1		1					
2		2					
3		3					
4		4					
5		5					
6		6					

IF IN DOUBT-ASK

DRN. IR  
 CHK. JKM  
 APP. DP  
 CROSS REFERENCE

DATE: 26/11/90  
 DATE: 26/11/90  
 DATE: 27/11/90

TITLE  
**PIPING AND INSTRUMENT DIAGRAM  
 FOR SCOTT OIL BOOSTER**  
 UNIT 12846  
 DRG NO. A45130P-330/06  
 SHEET