

CR 0 00000

A

B



C

D

E

F

1 2 3 4 5 6 7 8

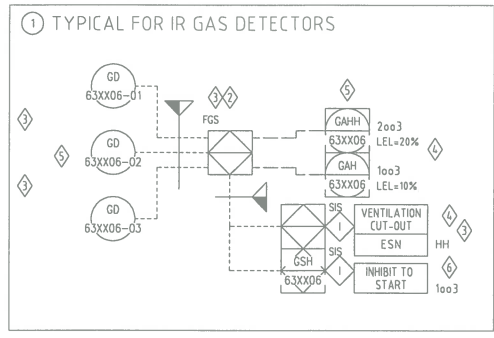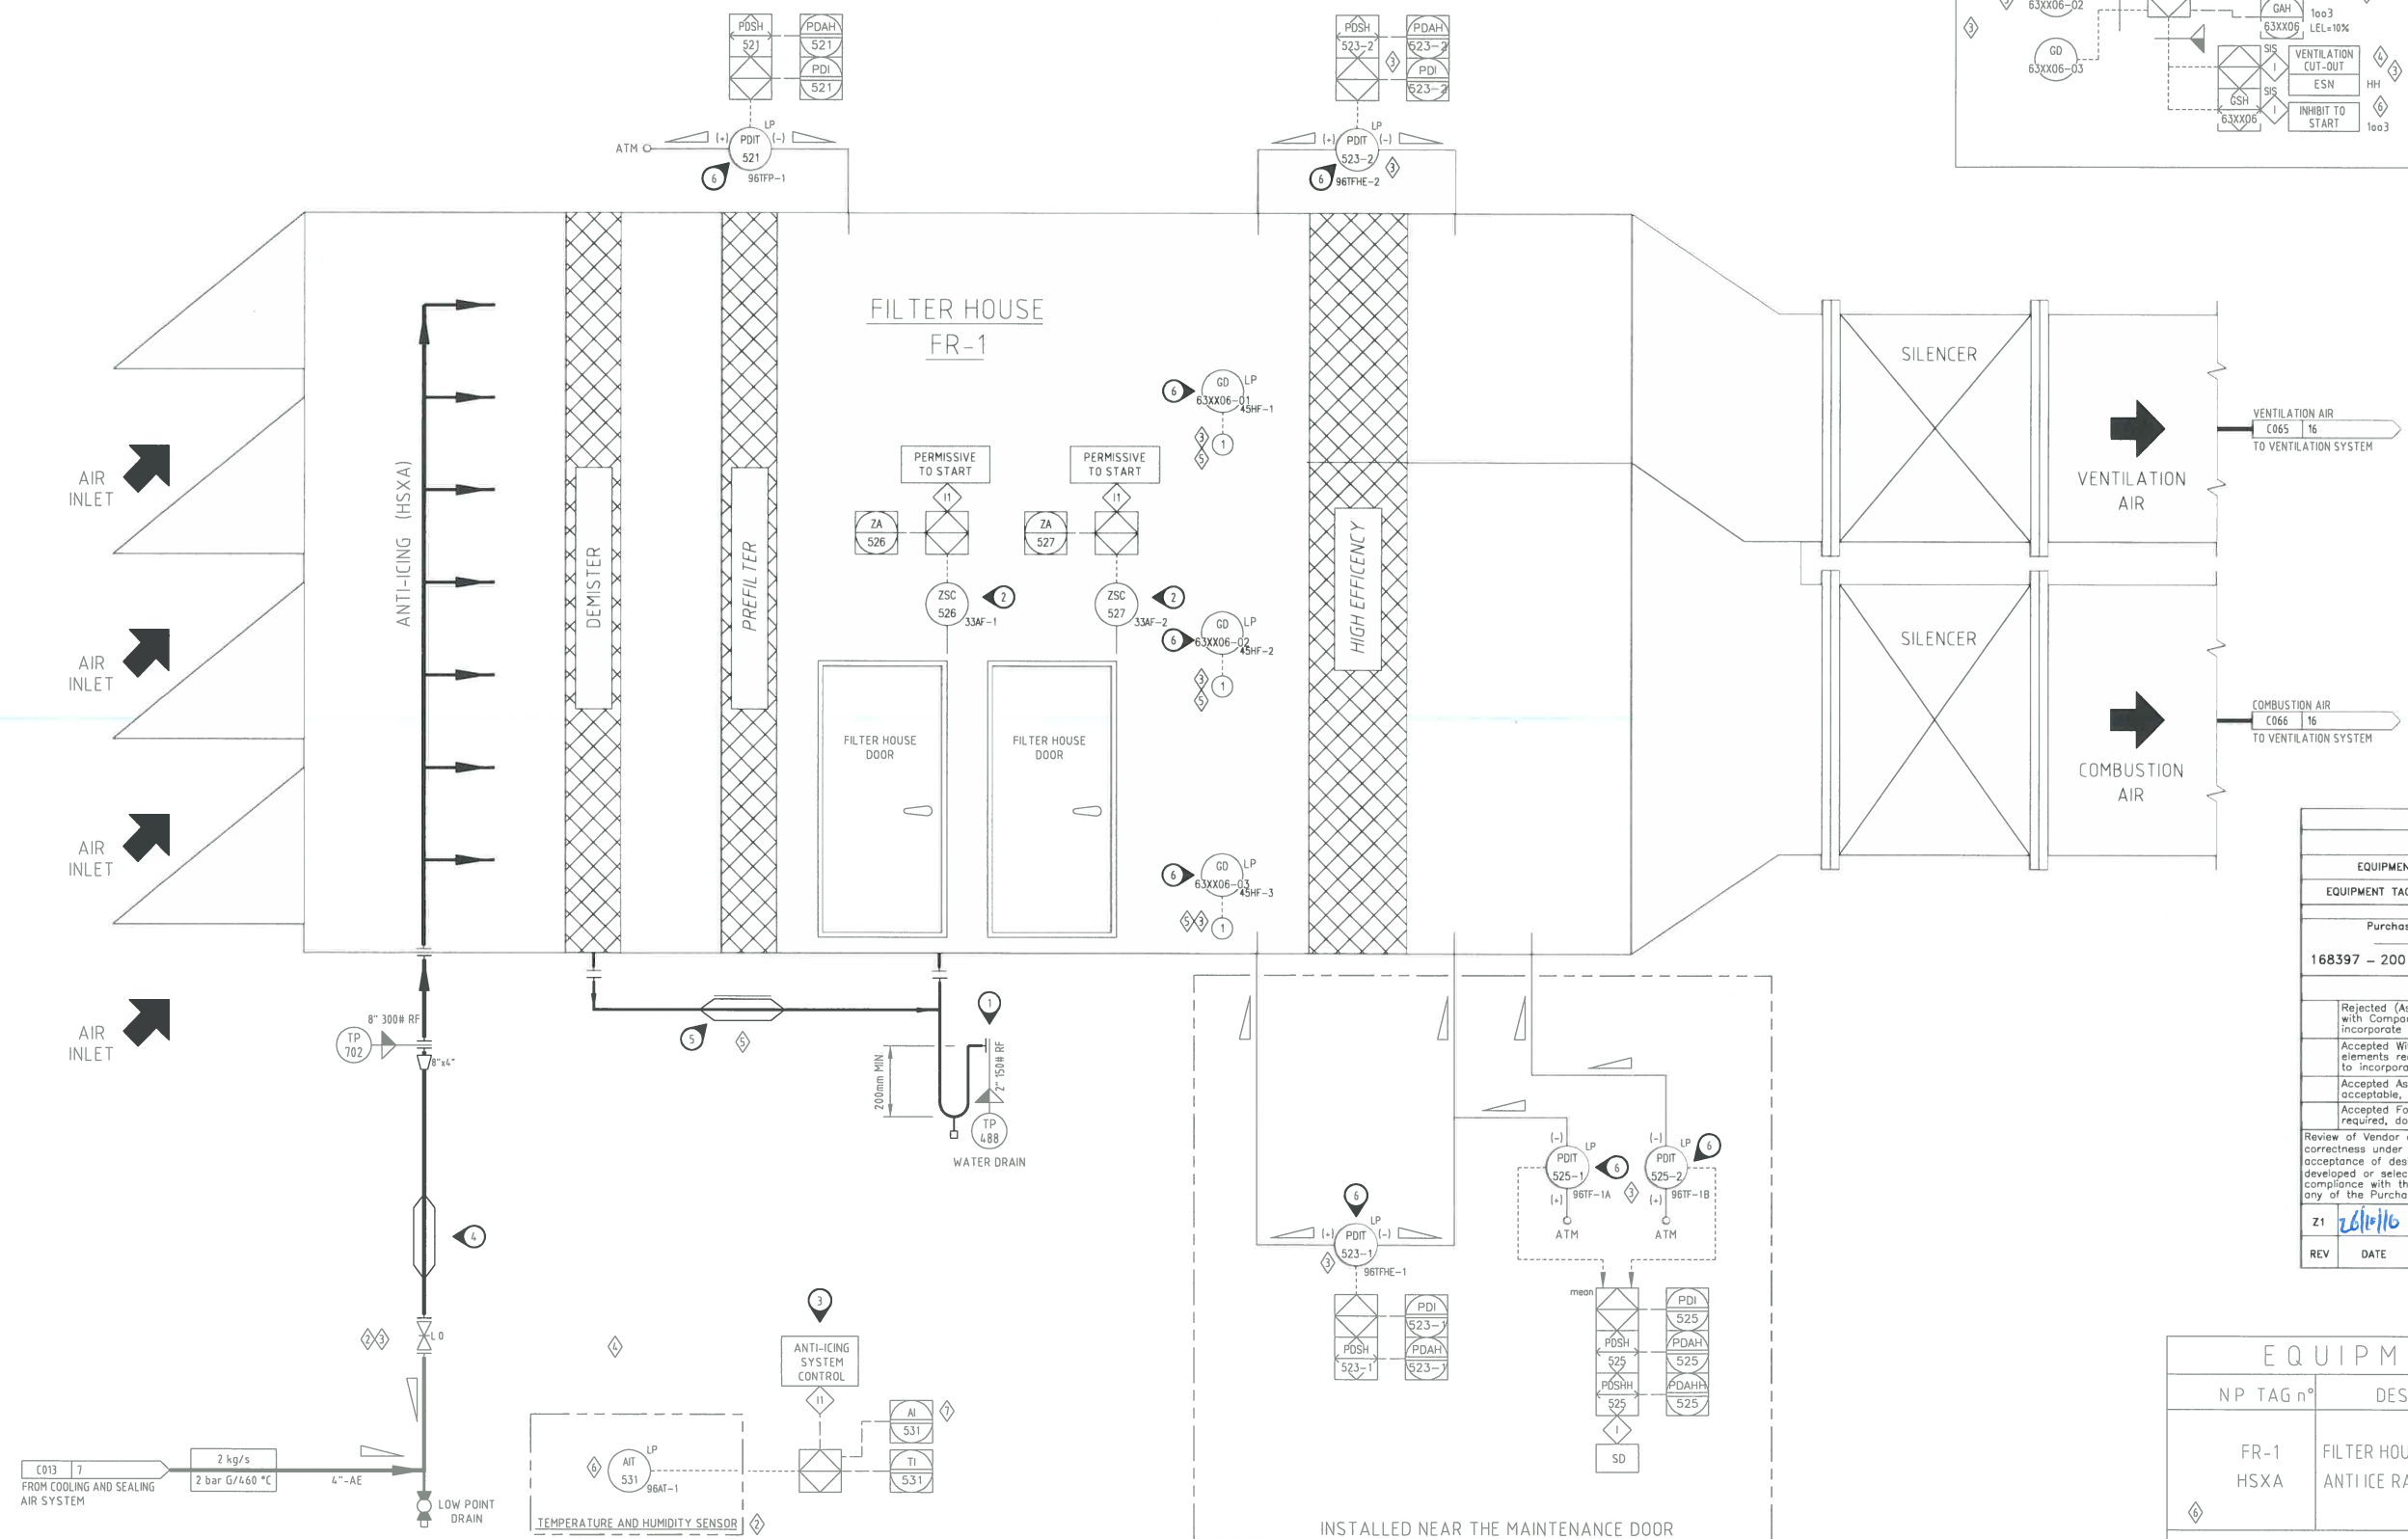

- NOTES
- 1 THIS CONNECTION MUST NOT BE BLINDED AND DOES NOT ALLOW ANY BACKPRESSURE. HYDRAULIC GUARDS MUST BE FILLED WITH WATER BEFORE RUNNING THE SYSTEM.
  - 2 TWO MAINTENANCE ACCESS DOOR, ONE LIMIT SWITCH FOR EACH DOOR.
  - 3 THE ANTI-ICING SYSTEM CONTROL INCLUDES INPUT FROM "T2A/B" TEMPERATURE SENSOR.
  - 4 PROVIDE PERSONNEL PROTECTION FOR ANTI-ICING PIPING BETWEEN G.T. PACKAGE AND AIR INTAKE FILTER HOUSING.
  - 5 HEAT TRACING AND INSULATION SUPPLIED BY CUSTOMER.
  - 6 LP IS LOCAL PANEL INSTALLED ON FILTER HOUSE ENCLOSURE.

Nexen Petroleum (U.K.) Limited					
VENDOR : GE Nuova Pignone (AMEC FW)					
EQUIPMENT TITLE : PIPING & INSTRUMENT DIAGRAMS					
EQUIPMENT TAG NO(S) : X-7001A/B, X-5701A/B					
Vendor Document Number					
Purchase Order No	Doc Type	Seq. Sheet No	Rev.	DATE	
168397 - 200 - PO - 3270 - MC2 - 001 - 15			Z1	26/10/16	
SUPPLIER DOCUMENT REVIEW					
Rejected (Assai Code - REJ) - Quality and content is out of conformity with Company requirements. Document shall be revised by Supplier to incorporate the necessary changes and subsequently re-submitted.					
Accepted With Comments (Assai Code - AWC) - Generally acceptable but elements require to be addressed. Document shall be revised by Supplier to incorporate the necessary changes and subsequently re-submitted.					
Accepted As Final (Assai Code - FIN) - Documents are considered acceptable, do not re-submit.					
Accepted For Information (Assai Code - AFI) - No further action required, do not re-submit.					
Review of Vendor documents does not relieve Vendor of the responsibility for correctness under the Purchase Order. Permission to proceed does not constitute acceptance of design, detail and calculations, test methods or materials developed or selected by the Vendor and does not relieve the Vendor from full compliance with the Purchase Order or any other obligations, not detract from any of the Purchaser's rights.					
Z1	26/10/16	AD-HOC AS-BUILT			
REV	DATE	DESCRIPTION	DRN	CHK	APP CLT

EQUIPMENT TAG NUMBER			
NP TAG n°	DESCRIPTION	CUSTOMER TAG	
FR-1 HSXA	FILTER HOUSE ANTI-ICE RACK	X-7001A	X
		F-7001A	F
		E-5711A	5711B

FIRE & GAS TAG NUMBERS RULE			
e.g. GD-63XX06-01			
Fire Zone		56 for X 7001A	60 for X-7001B

TITLE: FILTER HOUSE P&ID DIAGRAM		DOCUMENT CODE: SOM5081932	REVISION: 11
REVISION DESCRIPTION: NO REVISION IS INTRODUCED IN THIS SHEET		PAGE NUMBER: N/A	SECURITY CODE: N
ORIGINAL JOB: 1703636-37		SIZE: 1	LANGUAGE: A
THIS DOCUMENT IS AND CONTAINS CONFIDENTIAL AND PROPRIETARY INFORMATION OF Nuova Pignone S.r.l. WHICH SHALL NOT BE USED OR DISCLOSED TO OTHERS, EXCEPT WITH THE WRITTEN PERMISSION OF Nuova Pignone S.r.l. UNPUBLISHED WORK ©2014 Nuova Pignone S.r.l. ALL RIGHTS RESERVED.		SHEET: 15 of 21	

REVISE WITH P&ID ONLY