

P-3602 A

Non-Hazardous Open Drains Pump
Production Platform
Process liquid: Seawater with oil contamination
Rated capacity: 10m³/h
Differential pressure:1.16 bar
NPSHa: 8,2 m
Installed power : 2,2 kW
Design pressure: 6 barg
Design temperature: -7.6/50°C
PSV set pressure: 3.4 barg
Materials: 25%Cr Duplex Stainless Steel process wetted

V-3602 A

Seal system vessel
Type: Bladder accumulator
max. working pressure: 20 barg @ 80°C (Bladder)
max.working pressure: 75 barg (Vessel)
Vessel Total Capacity: 20 litres
Materials: Stainless Steel
Normal operating pressure: 4 barg

Legend

Hard

wired

Serial


Link

Process shutdown system

Process control system

Termination Point Schedule

N1A	pump inlet flange 3" ANSI B 16.5, 150lbs, RF
N2A	pump outlet flange 3" ANSI B16.5, 150lbs, RF
N3A	pump casing drain flange 2" ANSI B16.5, 150lbs, RF c/w valve + blind flange
N4A	baseplate drain flange 2" ANSI B16.5, 150lbs, RF c/w valve + blind flange
N5A	plan 53B filling connection 1/2" ANSI B16.5, 300lbs, RF c/w 1/2" NPT quick release coupling
N6A	N2 charging connection accumulator 1/4" BSP/M
N7A	Drain connection accumulator 1/2" ANSI B16.5, 300lbs, RF c/w blind flange
N8A	plan 53B vent connection 1/2" ANSI B16.5, 300lbs, RF c/w blind flange
N9A	Drain connection barrier interconnection piping 1/2" ANSI B16.5, 300lbs, RF c/w blind flange

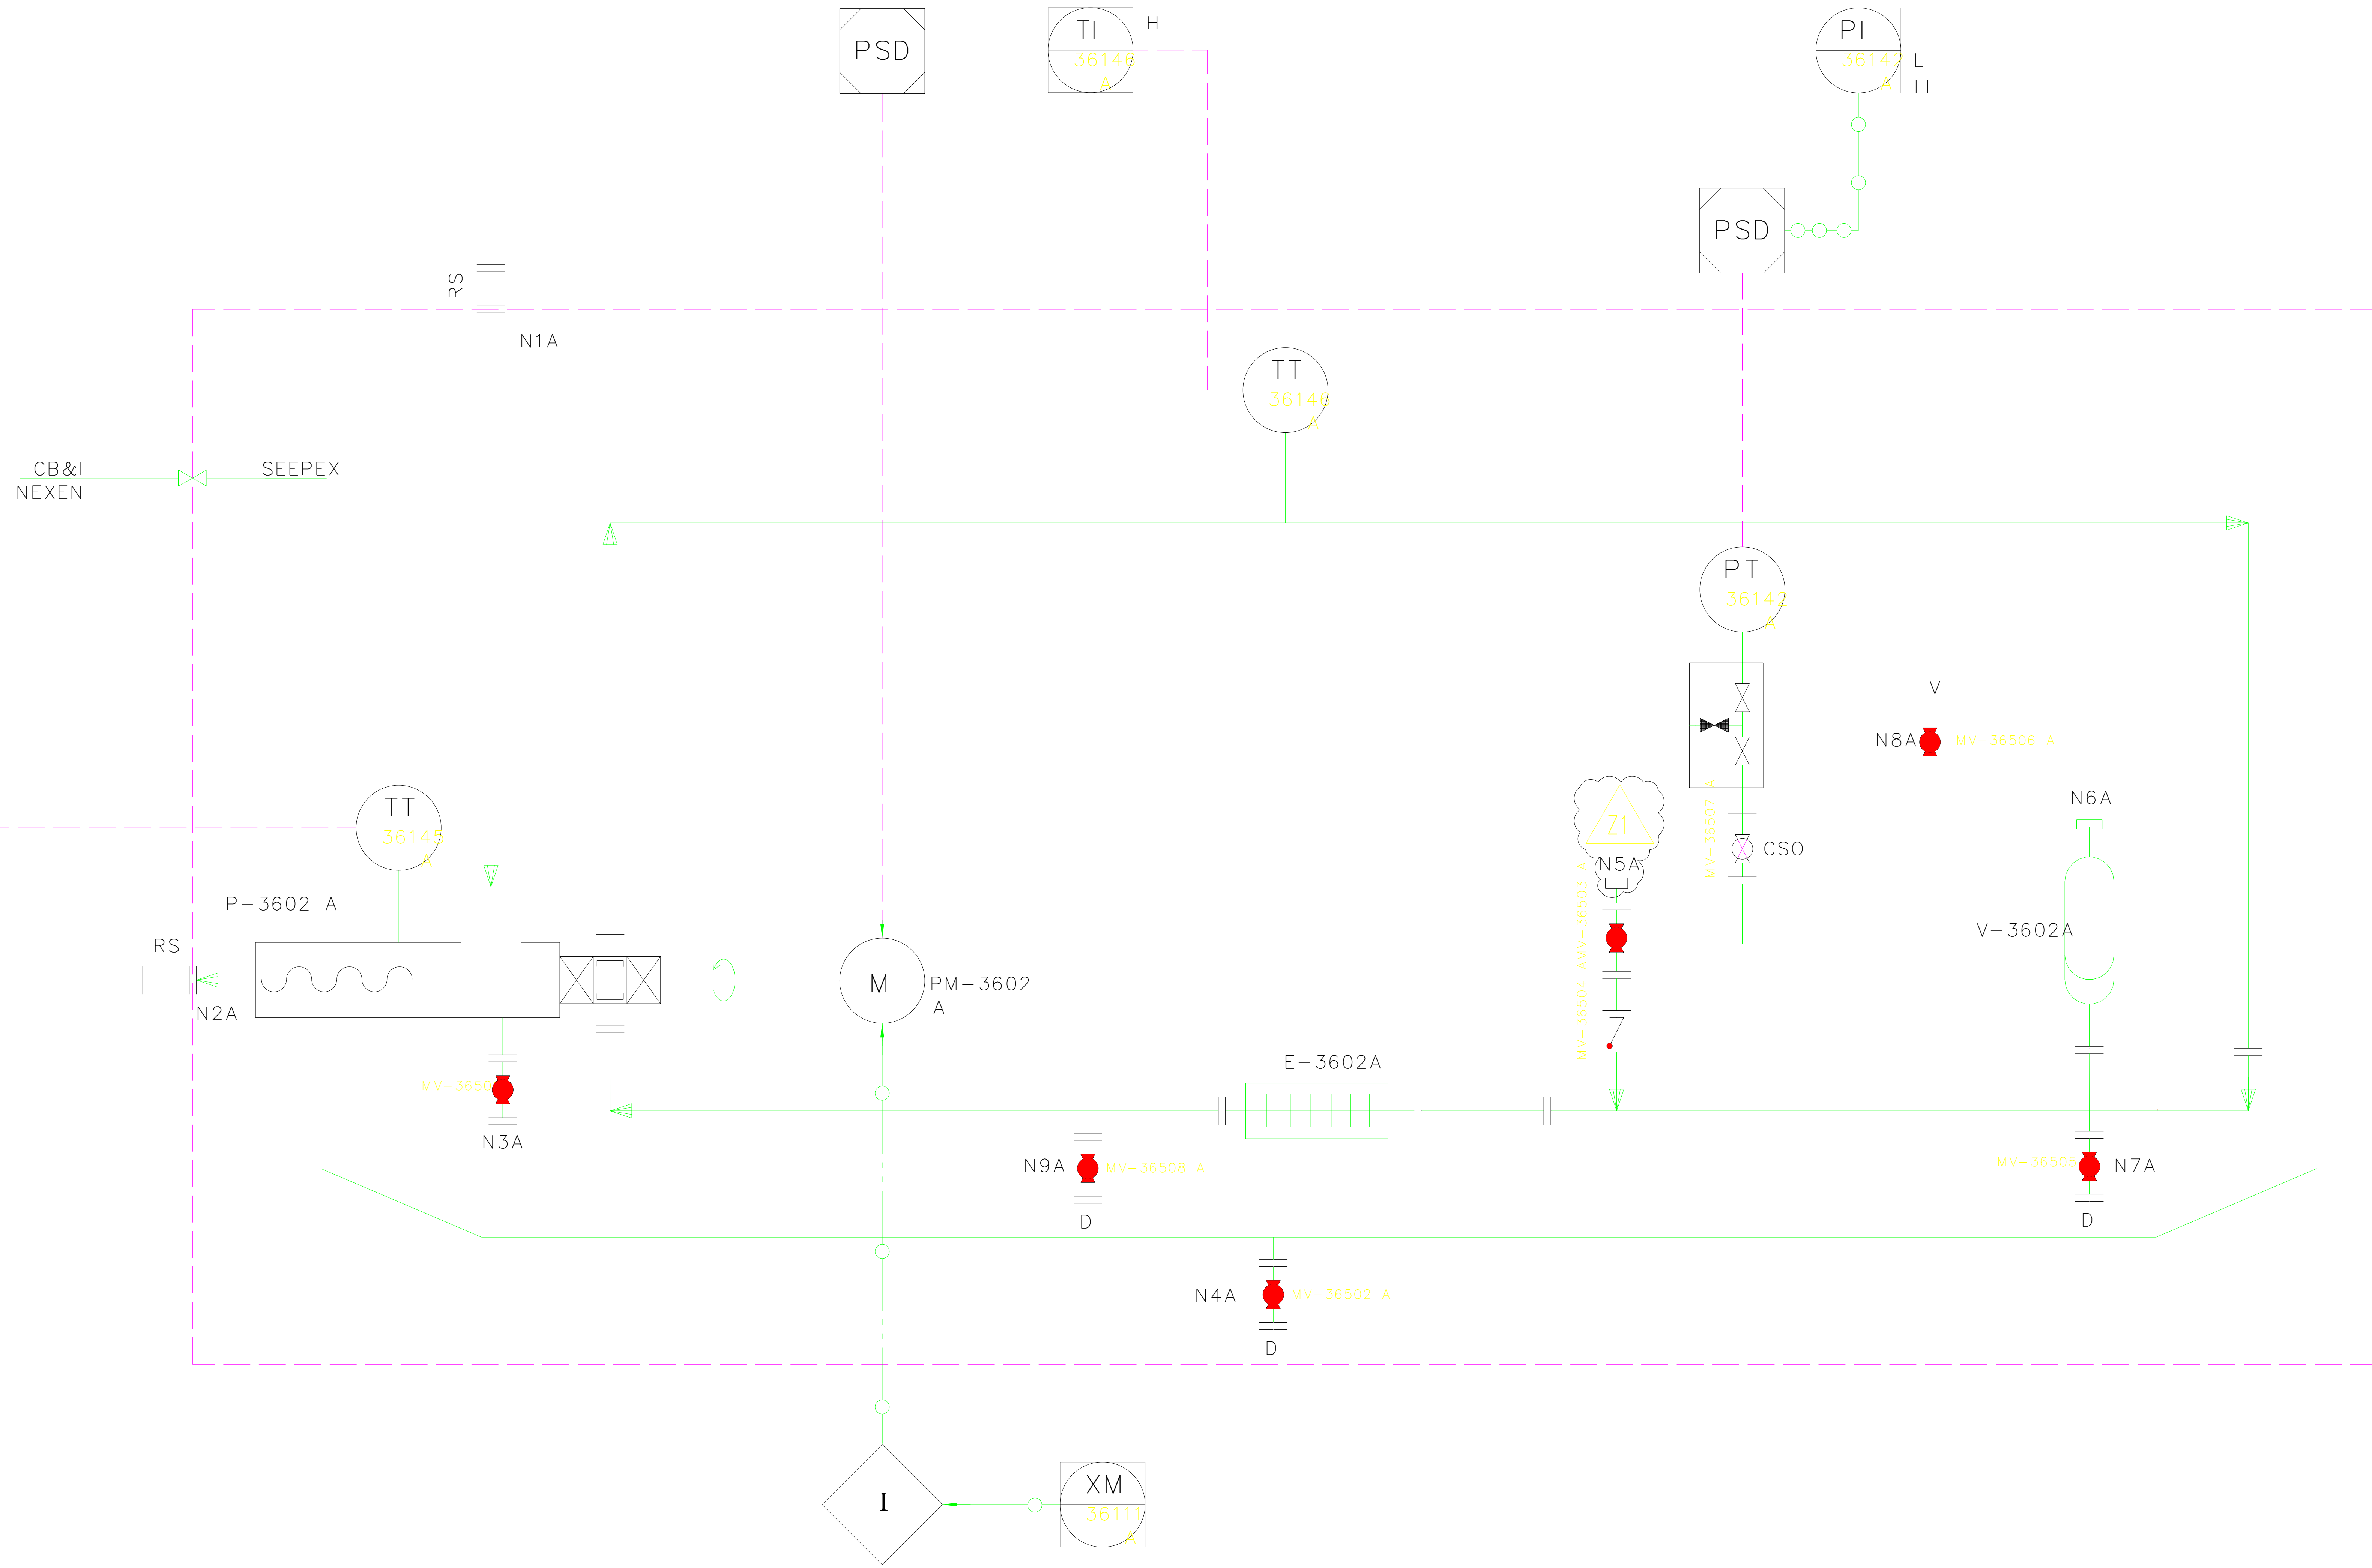

NOTES

1. PUMP P-3602A IS MOUNTED ON A SINGLE BASE PLATE.

REV	DATE	DESCRIPTION	DRN	CHK	APP	CLT
Z1	14.03.16	AD-HOC AS-BUILT	SB	KS	AH	TR
E	25.09.12	REVISE	MEL			
D	23.08.12	REVISE	MEL			
C	24.01.12	REVISE	MEL			
B	23.12.11	REVISE	MEL			



TITLE:
PIPING AND INSTRUMENT DIAGRAM
NON-HAZARDOUS OPEN DRAINS PUMP
P-3602A

SCALE (A1): N.T.S.

ASSAI No:

CONTRACT No: 168397

CLIENT CONTRACT No:

DRAWING No.	REV
168397-100-PO-3280-MC2-006-01	Z1

FILENAME: C:\TEMP\168397-100-PO-3280-MC2-006-01_Z1.DWG (PRINTED: 05/04/2016 06:58:50)