


NOTE

1 TYPICAL FIREDAMPER CONTROL SCHEMATIC

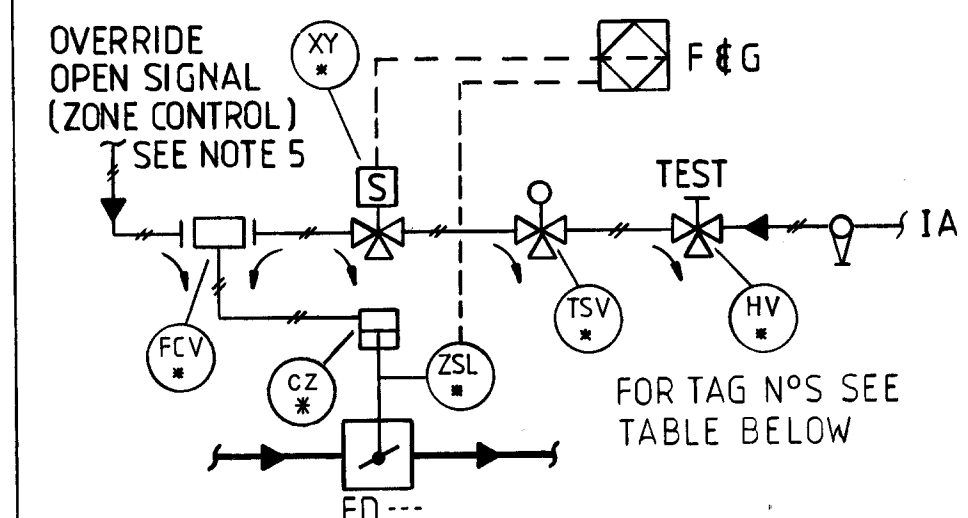

2 ALL FIRE DAMPERS TO BE PREFIXED UE 7371

3 SHORTENED FORM OF TAGGING ADOPTED TO IMPROVE READABILITY AND LIMIT CONGESTION IN ACCORDANCE TO AHL PROCEDURE E4-06 'ENGINEERING IDENTIFICATION SYSTEM', PAGE 29 SECTION 13-1

4 I MCC INDICATES LOGIC INTERLOCK LOCATED IN ELECTRICAL SWITCHGEAR R116

5 FOR OVERRIDE SIGNAL ZONE CONTROL SEE DRG SCOTT-SE-L100-JN-DG-0009:00


6 FOR EQUIPMENT TAG NUMBERS REFER TO HVAC DUCTING LAYOUT DIAGRAMS

7 FOR FIRE & GAS INTERLOCKS SEE F&G CAUSE & EFFECTS SCOTT-SE-L100-FG-CH-0001 TO 27

8 REF HVAC CONTROL PANEL 7371A

TAG NUMBERS						
F/DAMPER	CZ*	XY*	TSV*	HV*	FCV*	ZSL*
FD722	40332	40332	40332	40332	40332	40332


HVAC CONTROL PANEL 7371A

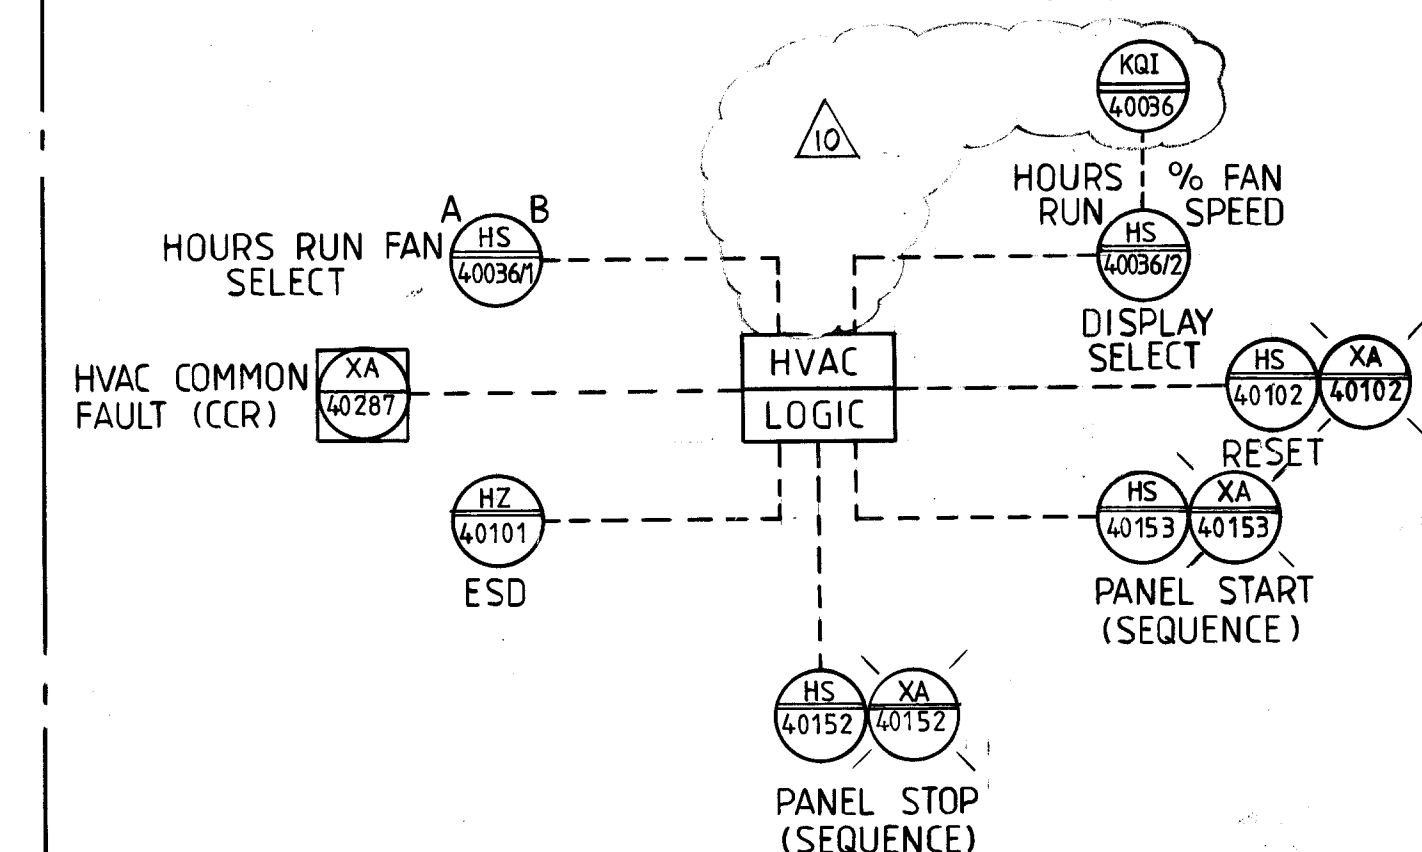

NOTE 8

COMMON TO ALL FANS

AMERADA HESS LIMITED
SCOTT FIELD DEVELOPMENT
SITE AS BUILT
CONTRACT C1018

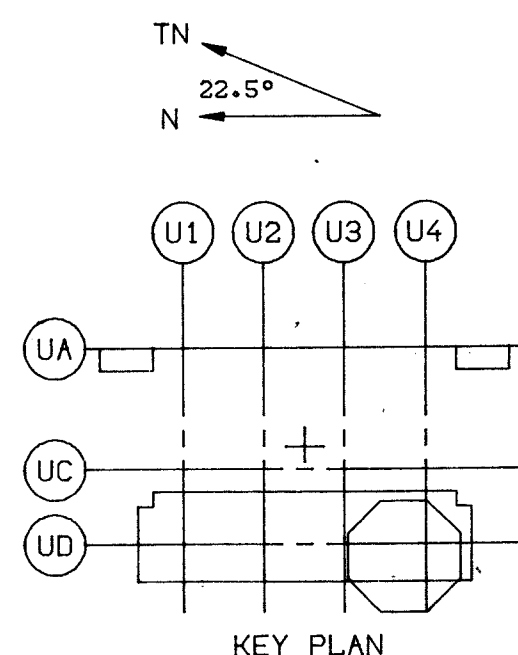

REFERENCE DRAWINGS		TITLE
DRAWING	REV	
SCOTT-SE-L100-FG-CH-0001 TO 27		FIRE & GAS CAUSE & EFFECT DIAGS.
SCOTT-SE-L100-HV-SC-0002:00		HVAC DAMPER SCHEDULE
SCOTT-SE-L100-HV-DR-0030 TO 0051		HVAC DUCTING LAYOUT DIAGRAMS
SCOTT-SE-L100-JN-DG-0021:SERIES		HVAC/INST E&I BLOCK DIAGRAMS
SCOTT-SE-L100-JN-CH-0001 TO 0010		HVAC/INST E&I CAUSE AND EFFECT DIAGRAMS
SCOTT-SE-L100-HV-DR-0001 TO 0021		HVAC AIRFLOW DIAGRAMS
SCOTT-SE-L100-JN-SC-0001:00		HVAC/INST E&I LEGENDS & SYMBOLS
THIS DRAWING IS THE PROPERTY OF SLP ENGINEERING LTD AND MUST NOT BE COPIED, REPRODUCED, OR SHOWN TO A THIRD PARTY WITHOUT THE WRITTEN CONSENT OF SLP ENGINEERING LTD.		

MTD No										AFD APPROVAL			AFC APPROVAL			REV			AHL EM		
10	NO CHANGE AS BUILT	5-1-93	APL	MD	MD	MD	MD	MD	MD												
0	APPROVED FOR CONSTRUCTION	4/11/92	APL	MD	MD	MD	MD	MD	MD												
CD	APPROVED FOR DESIGN	10/10/91	MD	MD	MD	MD	MD	MD	MD												
C	RE-ISSUED FOR CLIENT REVIEW/COMMIT	3-9-91	JG	MD	MD	MD	MD	MD	MD												
B	ISSUED FOR CLIENT REVIEW/COMMENT	3/1/91	MD	MD	MD	MD	MD	MD	MD												
A	ISSUED FOR INTERNAL COMMENT/IDC	11/6/91	MD	MD	MD	MD	MD	MD	MD												
REV	REASON FOR ISSUE		DATE	DRN	CHK	LE	DM/PE	LE	SM	REV			AHL EM			ORIGINAL SCALE			PROJECT		

AMERADA HESS LIMITED
SCOTT FIELD DEVELOPMENT

SLP SLP ENGINEERING LIMITED
SLP ENGINEERING LTD.
HAMILTON ROAD.
LONESTOFT
SUFFOLK NR32 1XF.
TEL: 0502-587322
TELEX: 975401
FAX: 0502-512589

TITLE HVAC/INSTRUMENTS E&I
DUCTING & INSTRUMENT DIAGRAM
GENERAL A/C SUPPLY SYSTEM

DRAWING NO. NTS
SCOTT-SE-L113-JN-DG-0001:00 10