

DRG NO. A45130P-324/06

PART NAME :-

**AS SUPPLIED**  
Seller shall complete both Sections A & B, sign & date  
A All Company comments on previous submission have been fully incorporated  
☒ Yes ☐ No ☐ Not Applicable  
B There are no design changes, other than incorporation of Company comments, from previous submission  
☐ Yes ☒ No  
Seller's Verifying Statement:  
This document accurately represents the "As Supplied" condition of the Work  
Sellers Authorized Signature: *[Signature]* Date: 21/8/92

**FINAL CERTIFIED**  
S/G. *[Signature]*  
DATE: 24/10/91  
WEIR PUMPS LTD.


TERMINAL POINT LIST	DESC OF CONNECTION
TP1	10"NB "GRAYLOCK" MAIN PUMP SUCTION
TP2	8"NB "GRAYLOCK" MAIN PUMP DELIVERY
TP3	1"NB 2500 RTJ FLANGE PUMP DRAIN
TP4	1"NB ANSI 150FF FLANGE BEDPLATE DRAIN
TP5	3"NB ANSI 150FF FLANGE COOLING WATER SUPPLY
TP6	3"NB ANSI 150FF FLANGE COOLING WATER RETURN
TP7	3"NB ANSI 150FF FLANGE MECH SEAL OFF LOAD
TP8	4"NB ANSI 150FF FLANGE MECH SEAL OFF LOAD RELIEF VALVE OUTLET

NOTE:- TP 1 & TP2 SUPPLIED WITH MATING HUBS TO SUIT SCH160 PIPE COMPLETE WITH SEAL RINGS CLAMPS AND BOLTS

FIRST ANGLE PROJECTION

COMPANY RETURN CODES		AMERADA HESS LIMITED	
<input checked="" type="checkbox"/> 1. Accepted "As supplied"		SCOTT FIELD DEVELOPMENT	
<input type="checkbox"/> 2. Accepted - No Comments		Package Desc	SEAWATER INJECTION PUMPS
<input type="checkbox"/> 3. Qualified Acceptance - Minor Comments. Revise & Resubmit as "As Supplied" Work May Proceed		Equip Nos	PY 1404
<input type="checkbox"/> 4. Qualified Acceptance - Minor Comments. Revise & Resubmit To Obtain Code 2 Work May Proceed		SERS Code	DO1/E10
<input type="checkbox"/> 5. Qualified Acceptance - Major Comments. Revise & Resubmit To Obtain Code 2 Work May Proceed		Module	0110 Sheet 1 of 1
<input type="checkbox"/> 6. Rejected - Revise & Resubmit Immediately Work May Not Proceed In The Affected Areas		Purchase Order No	P0027
<input type="checkbox"/> 7. Rejected - Not Rejected		Document No	D 0,0,02
Company Signature: <i>[Signature]</i> Date: 21/8/92		Rev	06

- LOCAL INSTRUMENT
- FRONT OF PANEL MOUNTED INSTRUMENT
- REAR OF PANEL MOUNTED INSTRUMENT

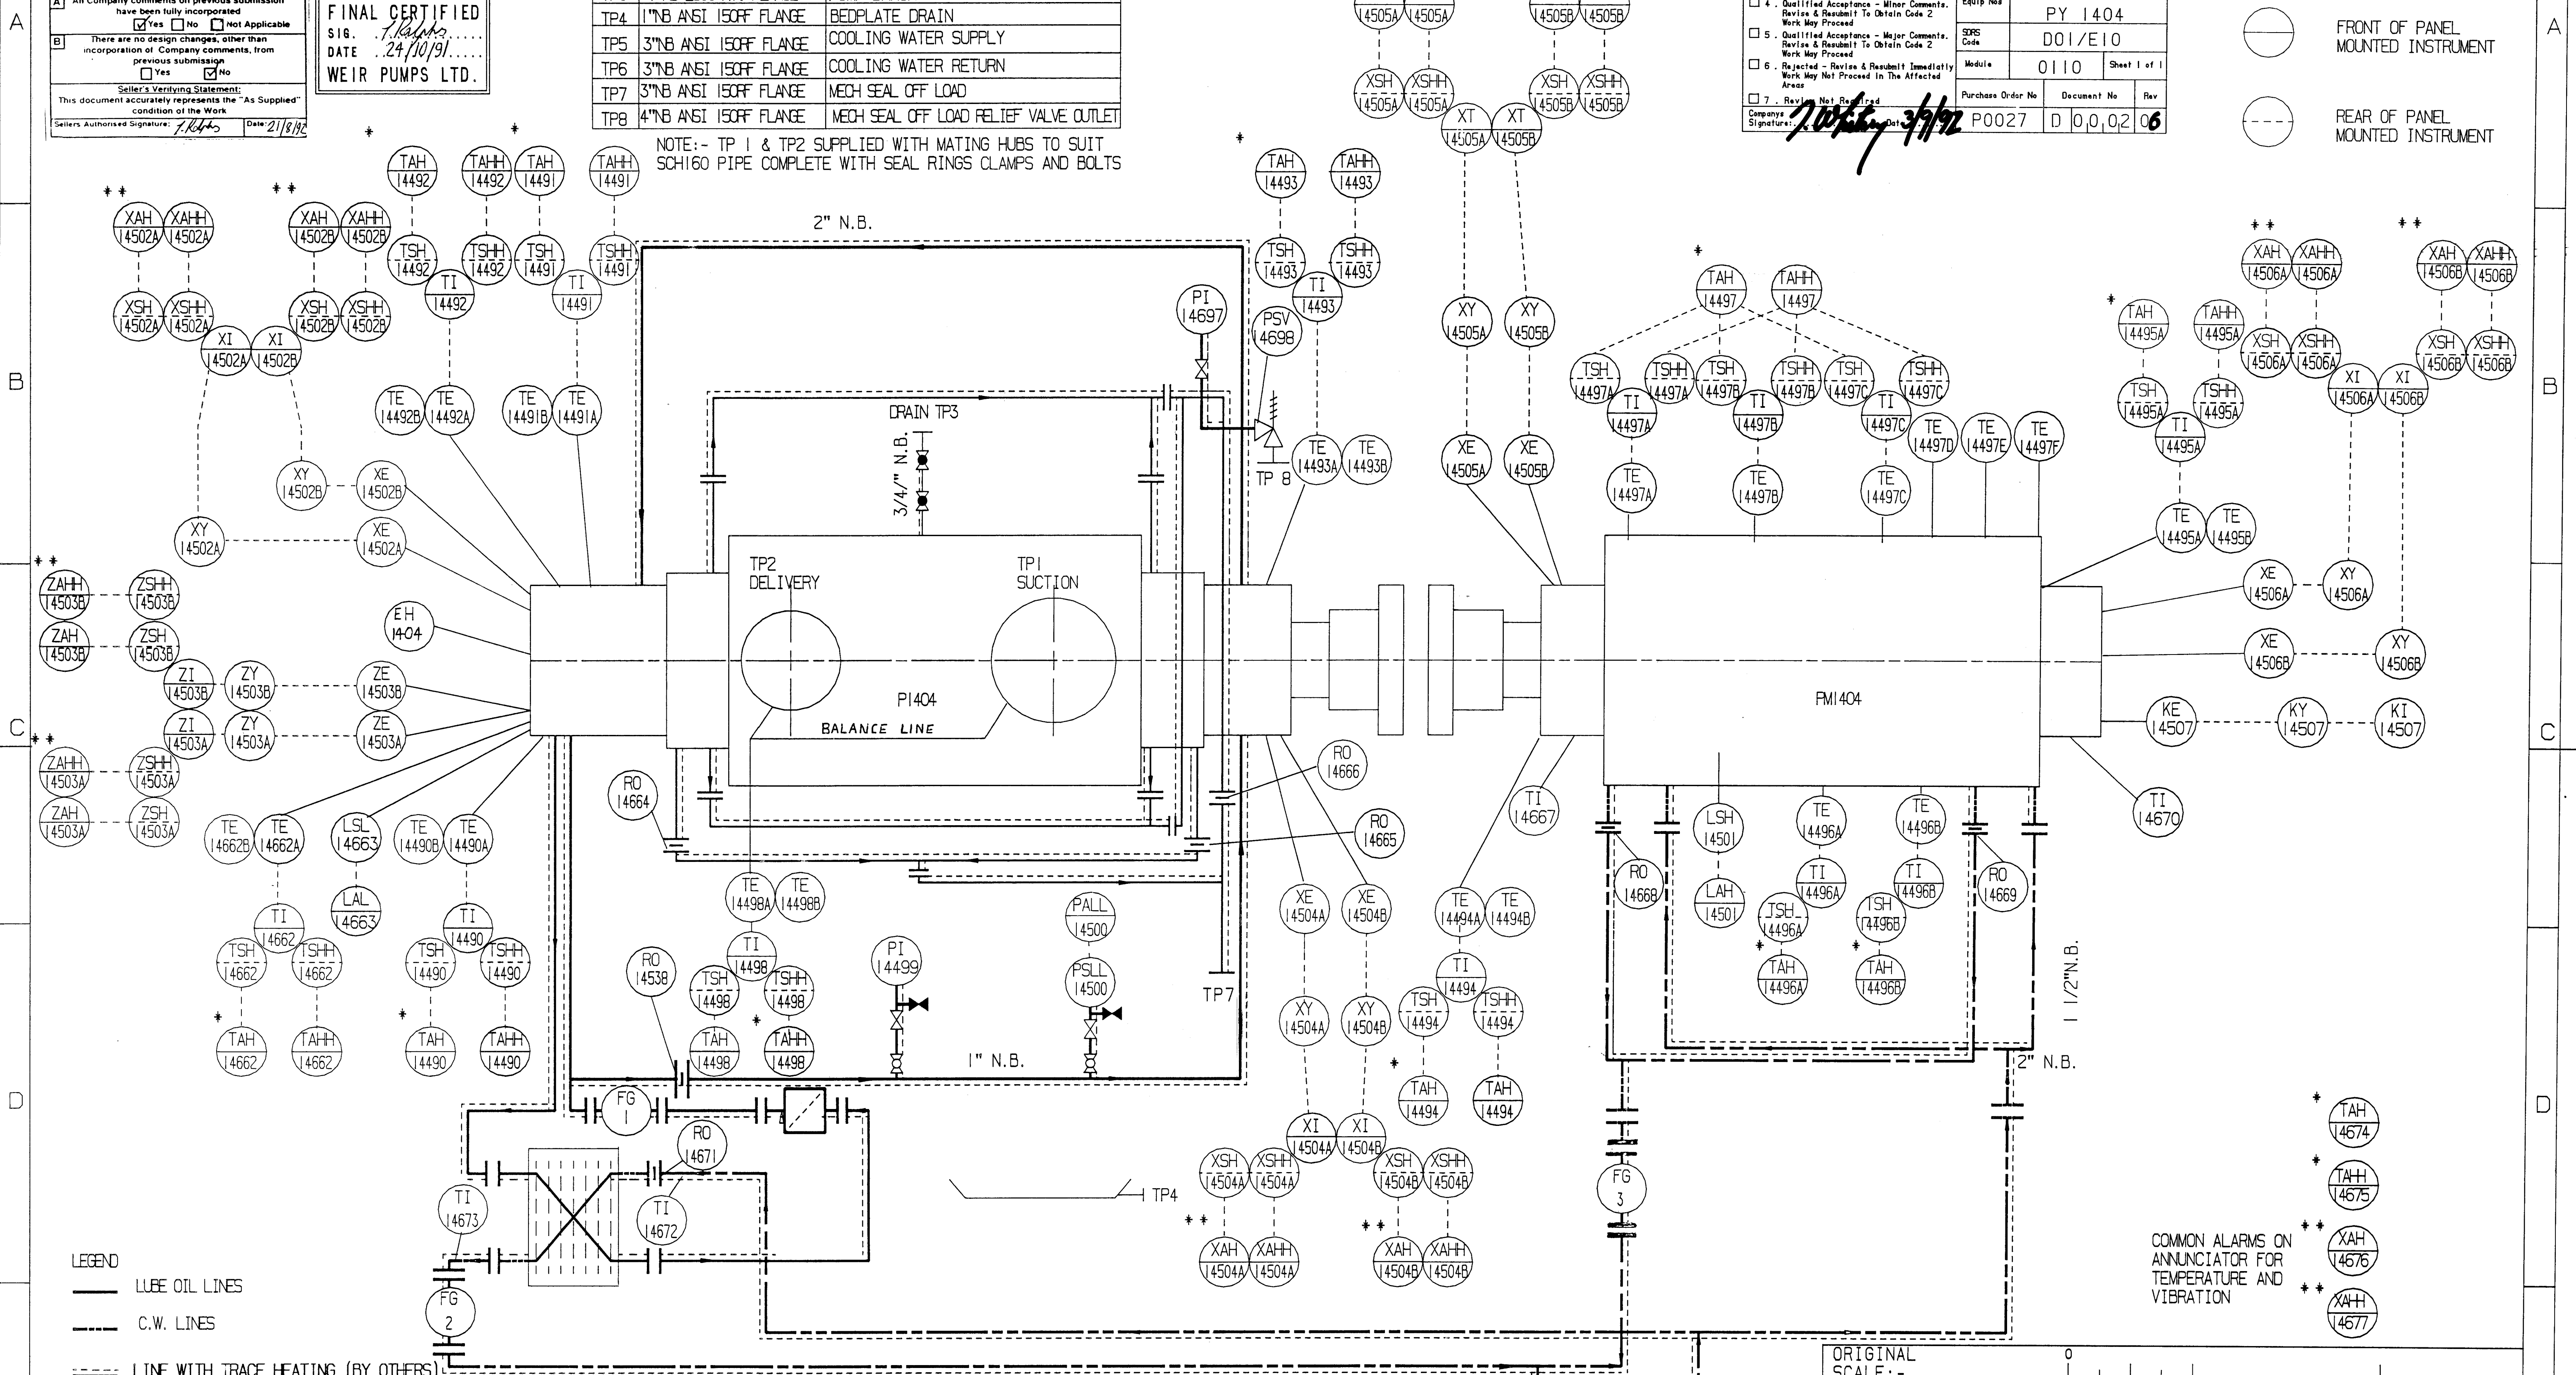

**LEGEND**  
— LUBE OIL LINES  
--- C.W. LINES  
--- LINE WITH TRACE HEATING (BY OTHERS)

THIS DRAWING IS OWNED BY  
**WEIR PUMPS LIMITED**  
AND IS CONDITIONALLY LOANED TO THE RECIPIENT WHO BY RECEIVING IT HAS AGREED NOT TO REPRODUCE OR COPY IT IN WHOLE OR IN PART NOR TO FURNISH INFORMATION FROM IT TO OTHERS NOR TO MAKE ANY USE OF IT THAT IS NOT THE SUBJECT OF WRITTEN AGREEMENT BY WEIR PUMPS LIMITED AND TO RETURN IT UPON REQUEST.

ISSUE NO.	ZONE	REVISION	SIG.	DATE
1	1	1	1	1
2	1	1	1	1
3	1	1	1	1
4	1	1	1	1
5	1	1	1	1
6	1	1	1	1

ORIGINAL ISSUE  
1 SEE ENGR61 IN 15/1/91  
2 CLIENTS COMMENTS TAG NOS ADDED  
3 TRACE HEATING ADDED  
4 CLIENTS COMMENTS TP 8 ADDED IN 22/8/91  
5 CLIENTS COMMENTS DRG AS BUILT IN 23/10/91  
6 DRG ERROR 6/18/92

ORIGINAL SCALE:-		DO NOT SCALE DRAWING		IF IN DOUBT-ASK	
DRN. IR	DATE: 15/10/90	TITLE		PIPING AND INSTRUMENT DIAGRAM FOR SCOTT FIELD S.W.I. PUMP	
CHK. J KM	DATE: 29/10/90	CROSS REFERENCE		UNIT 12843-704	
APP. DP	DATE: 29/10/90	INSTRUMENT LIST 112861P-233		DRG NO. A45130P-324/06	
				STATE LATEST ISSUE NO. WHEN QUOTING DRG. PART DESCRIPTION CODE NO.	