


813-04329-01-1T
... 21 10042420011

BATTERY ROOM 217

CORRIDOR 216 SOUTH

NOTE

1. TYPICAL FIREDAMPER CONTROL SCHEMATIC

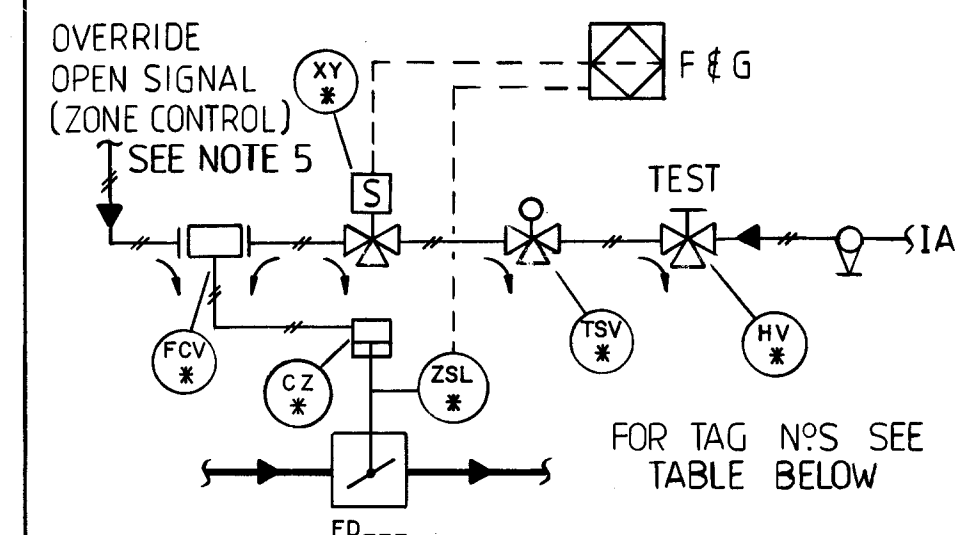

2. ALL FIRE DAMPERS TO BE PREFIXED UE 7371

3. SHORTENED FORM OF TAGGING ADOPTED TO IMPROVE READABILITY AND LIMIT CONGESTION IN ACCORDANCE WITH AHL PROCEDURE E4-06 'ENGINEERING IDENTIFICATION SYSTEM'.
PAGE 29, SECTION 13.1

4. MCC INDICATES LOGIC INTERLOCK LOCATED IN ELECTRICAL SWITCHGEAR R116

5. FOR ZONE CONTROL OVERRIDE SIGNAL SEE DRG: SCOTT-SE-L100-JN-DG-0009:00


6. FOR EQUIPMENT TAG NUMBERS REFER TO HVAC DUCTING LAYOUT DIAGRAMS

7. FOR FIRE & GAS INTERLOCKS SEE F&G CAUSE & EFFECTS SCOTT-SE-L100-FG-CH-0001 TO 27

HVAC LAYDOWN AREA LEVEL 1

ELECTRICAL SWITCHROOM 116

HVAC PLANTROOM 113

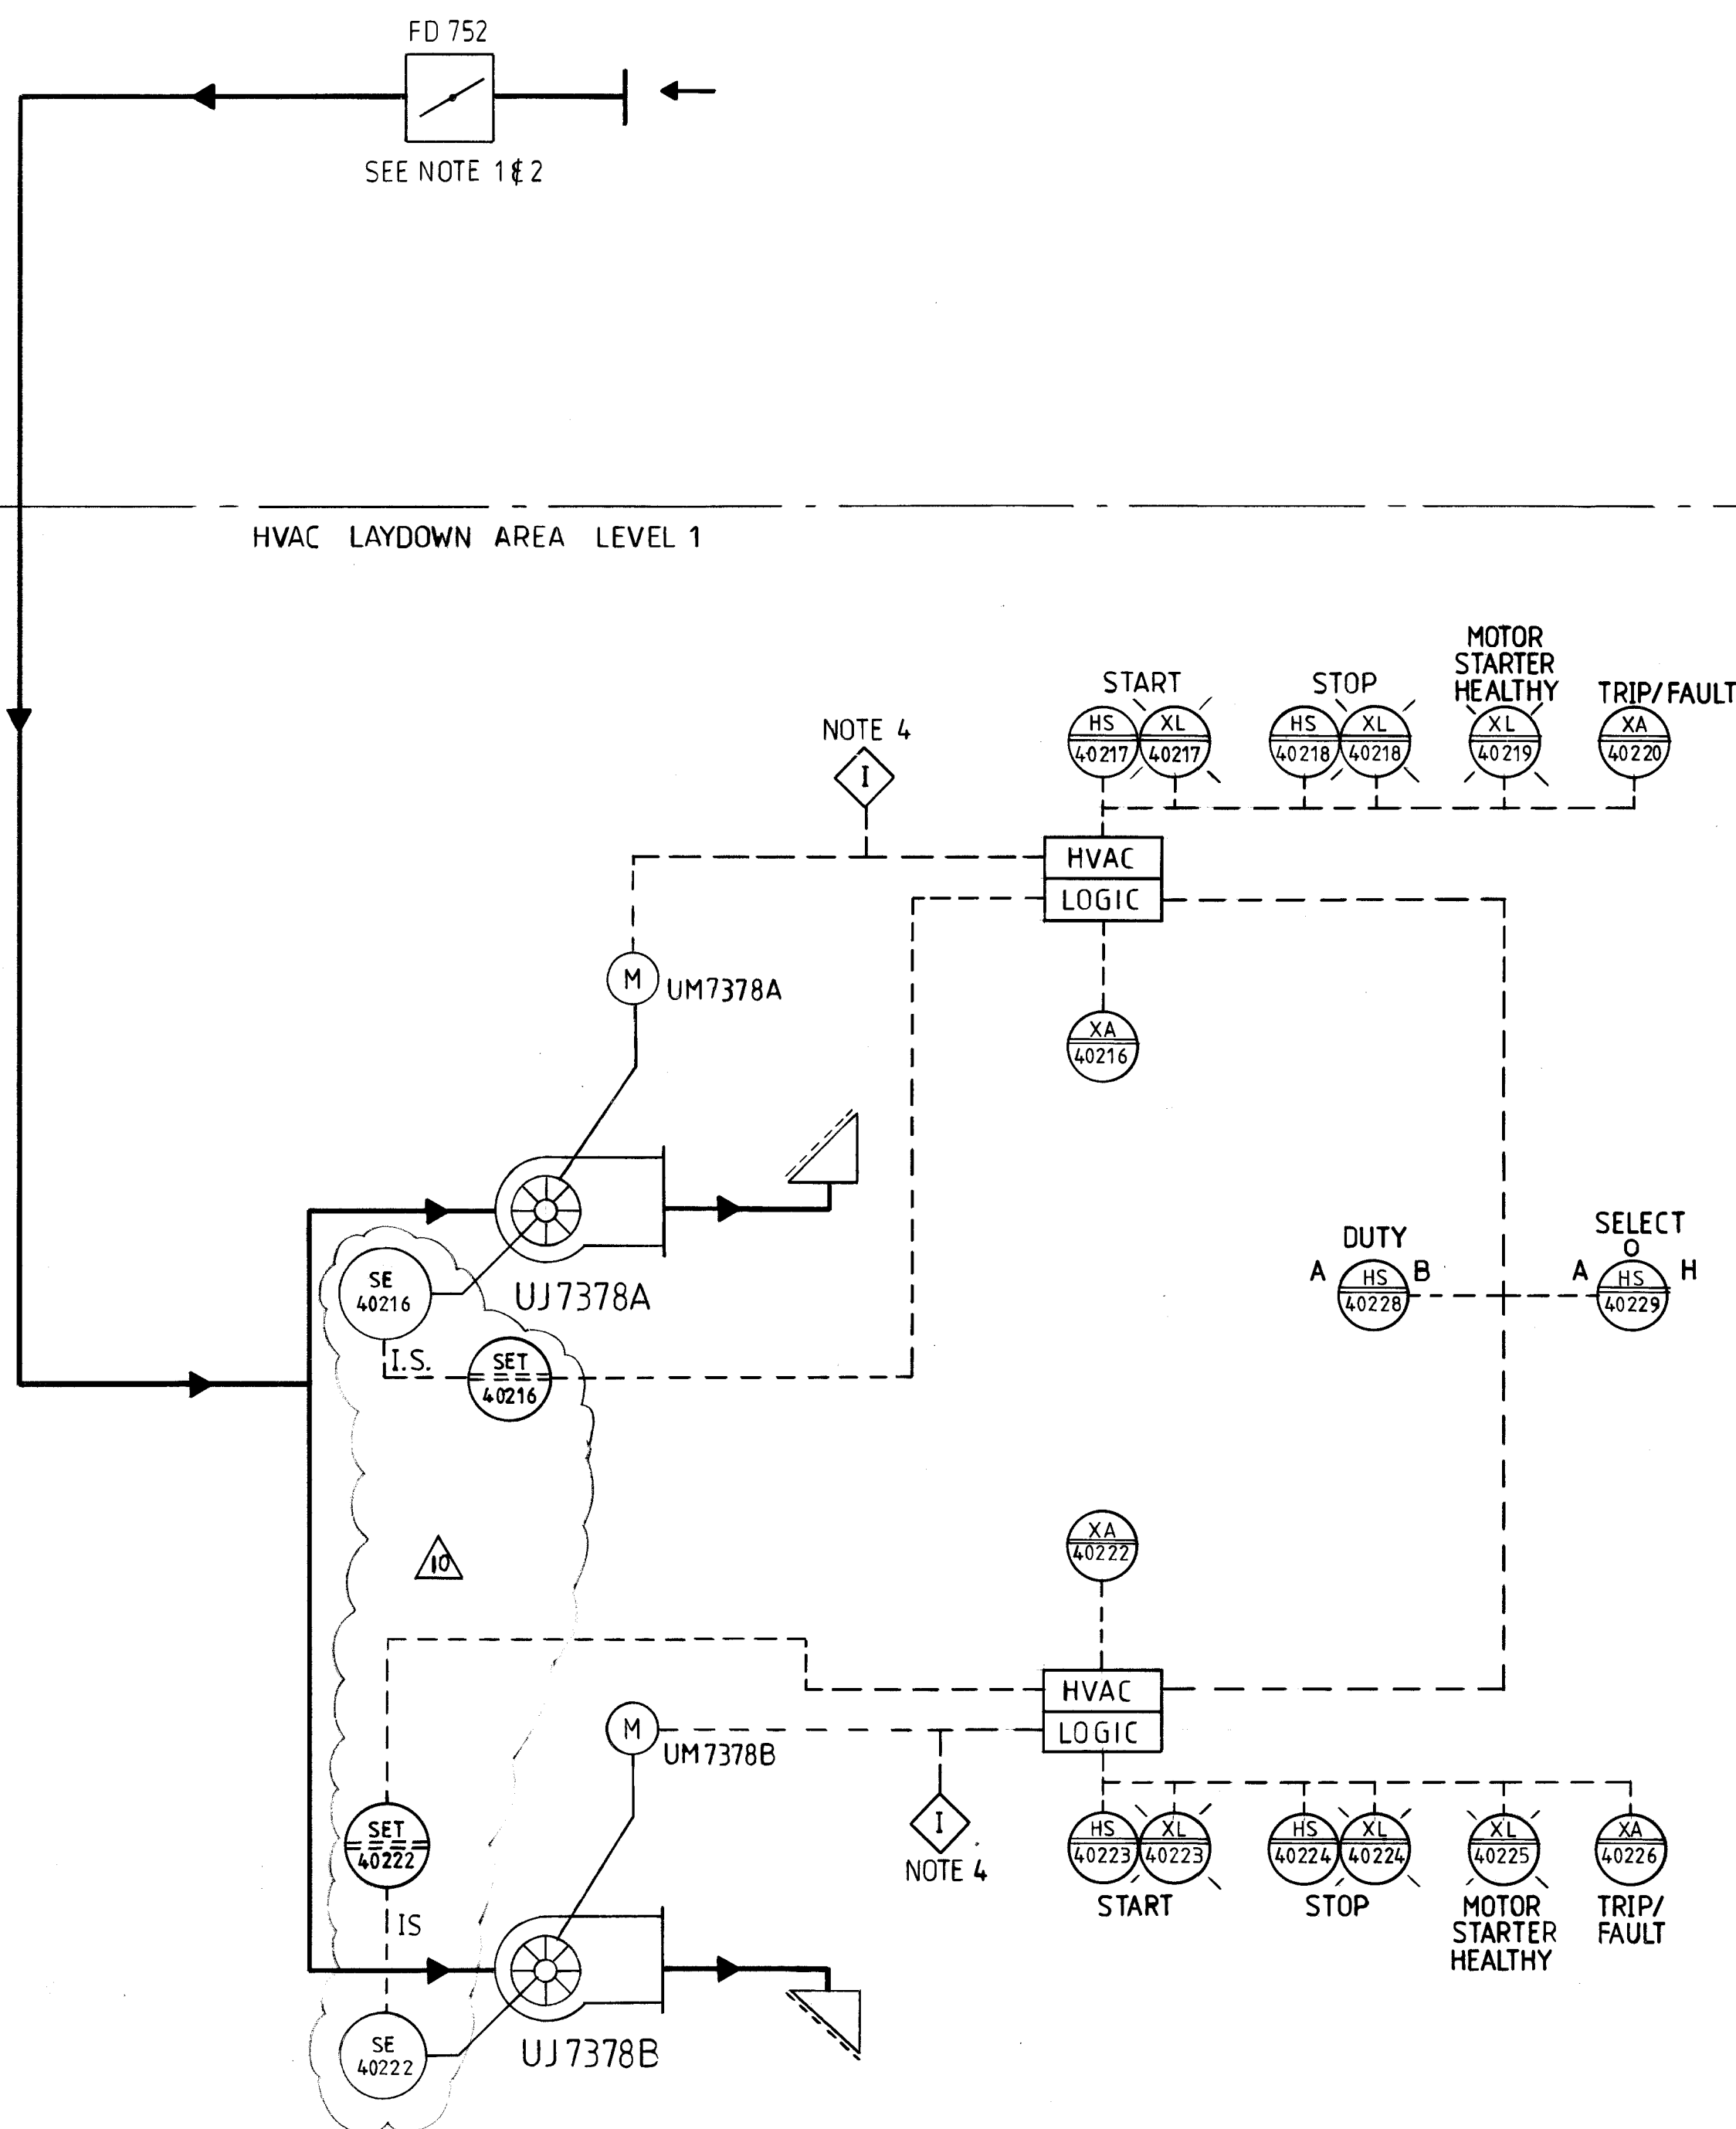

AMERADA HESS LIMITED
SCOTT FIELD DEVELOPMENT
SITE AS BUILT
CONTRACT C1013

COMMON TO
BOTH UNITS

TAG NUMBERS						
F/DAMPER	CZ*	XY*	TSV*	HV*	FCV*	ZSL*
FD 752	40362	40362	40362	40362	40362	40362

AMERADA HESS LIMITED
SCOTT FIELD DEVELOPMENT



SLP SLP ENGINEERING LIMITED
SLP ENGINEERING LTD.
HAMILTON ROAD,
LOVESTOFT,
SUFFOLK, NR32 1XF.
TEL: 0502-587322
TELEX: 975401
FAX: 0502-512589



TITLE HVAC/INSTRUMENTS E&I
DUCTING & INSTRUMENT DIAGRAM
BATTERY ROOM EXHAUST SYSTEM

NTS DRAWING NO.
SCOTT-SE-L100-JN-DG-0007:00
ORIGINAL SCALE PROJECT ORIS AREA/MOD DISC TYPE SEQ. No SHI H&V

REFERENCE DRAWINGS	
DRAWING	REV
SCOTT-SE-L100-FG-CH-0001 TO 27	
SCOTT-SE-L100-HV-SC-0002:00	
SCOTT-SE-L100-JN-DR-0030 TO 0051	
SCOTT-SE-L100-JN-DG-0021:SERIES	
SCOTT-SE-L100-JN-CH-0001:00 TO 0010:00	
SCOTT-SE-L100-HV-DR-0001 TO 0021	
SCOTT-SE-L100-JN-SC-0001:00	
FIRE & GAS CAUSE & EFFECT DIAGS.	
HVAC DAMPER SCHEDULE	
HVAC DUCTING LAYOUT DIAGRAMS	
HVAC/INST E&I BLOCK DIAGRAMS	
HVAC/INST E&I CAUSE AND EFFECT DIAGRAMS	
HVAC AIRFLOW DIAGRAMS	
HVAC/INST E&I LEGENDS & SYMBOLS	

THIS DRAWING IS THE PROPERTY OF SLP ENGINEERING LTD AND MUST NOT BE COPIED, REPRODUCED, OR SHOWN TO A THIRD PARTY WITHOUT THE WRITTEN CONSENT OF SLP ENGINEERING LTD.

REV	REASON FOR ISSUE	DATE	DRN	CHK	LE	DM/PE	LE	SM
10	NO CHANGE AS BUILT	5-1-93	APL	MOB	MYL			
0	APPROVED FOR CONSTRUCTION.	4/11/92	APL	IDW	MYL			
CD	APPROVED FOR DESIGN	11/10/91	MOB	R	MYL			
C	RE-ISSUED FOR CLIENT REVIEW/COMMENT	21/8/91	FW	MOB	MYL			
B	ISSUED FOR CLIENT REVIEW/COMMENT	3/7/91	\$	MOB	MYL			
A	ISSUED FOR INTERNAL COMMENT / IDC	14/6/91	\$	MOB	MYL			

MTD No		
AFD APPROVAL		
REV	SEPM	AHL EM
AFC APPROVAL		
REV	SEPM	AHL EM

TN
22.5°
N

