


GAS LIFT MANIFOLD (EAST)

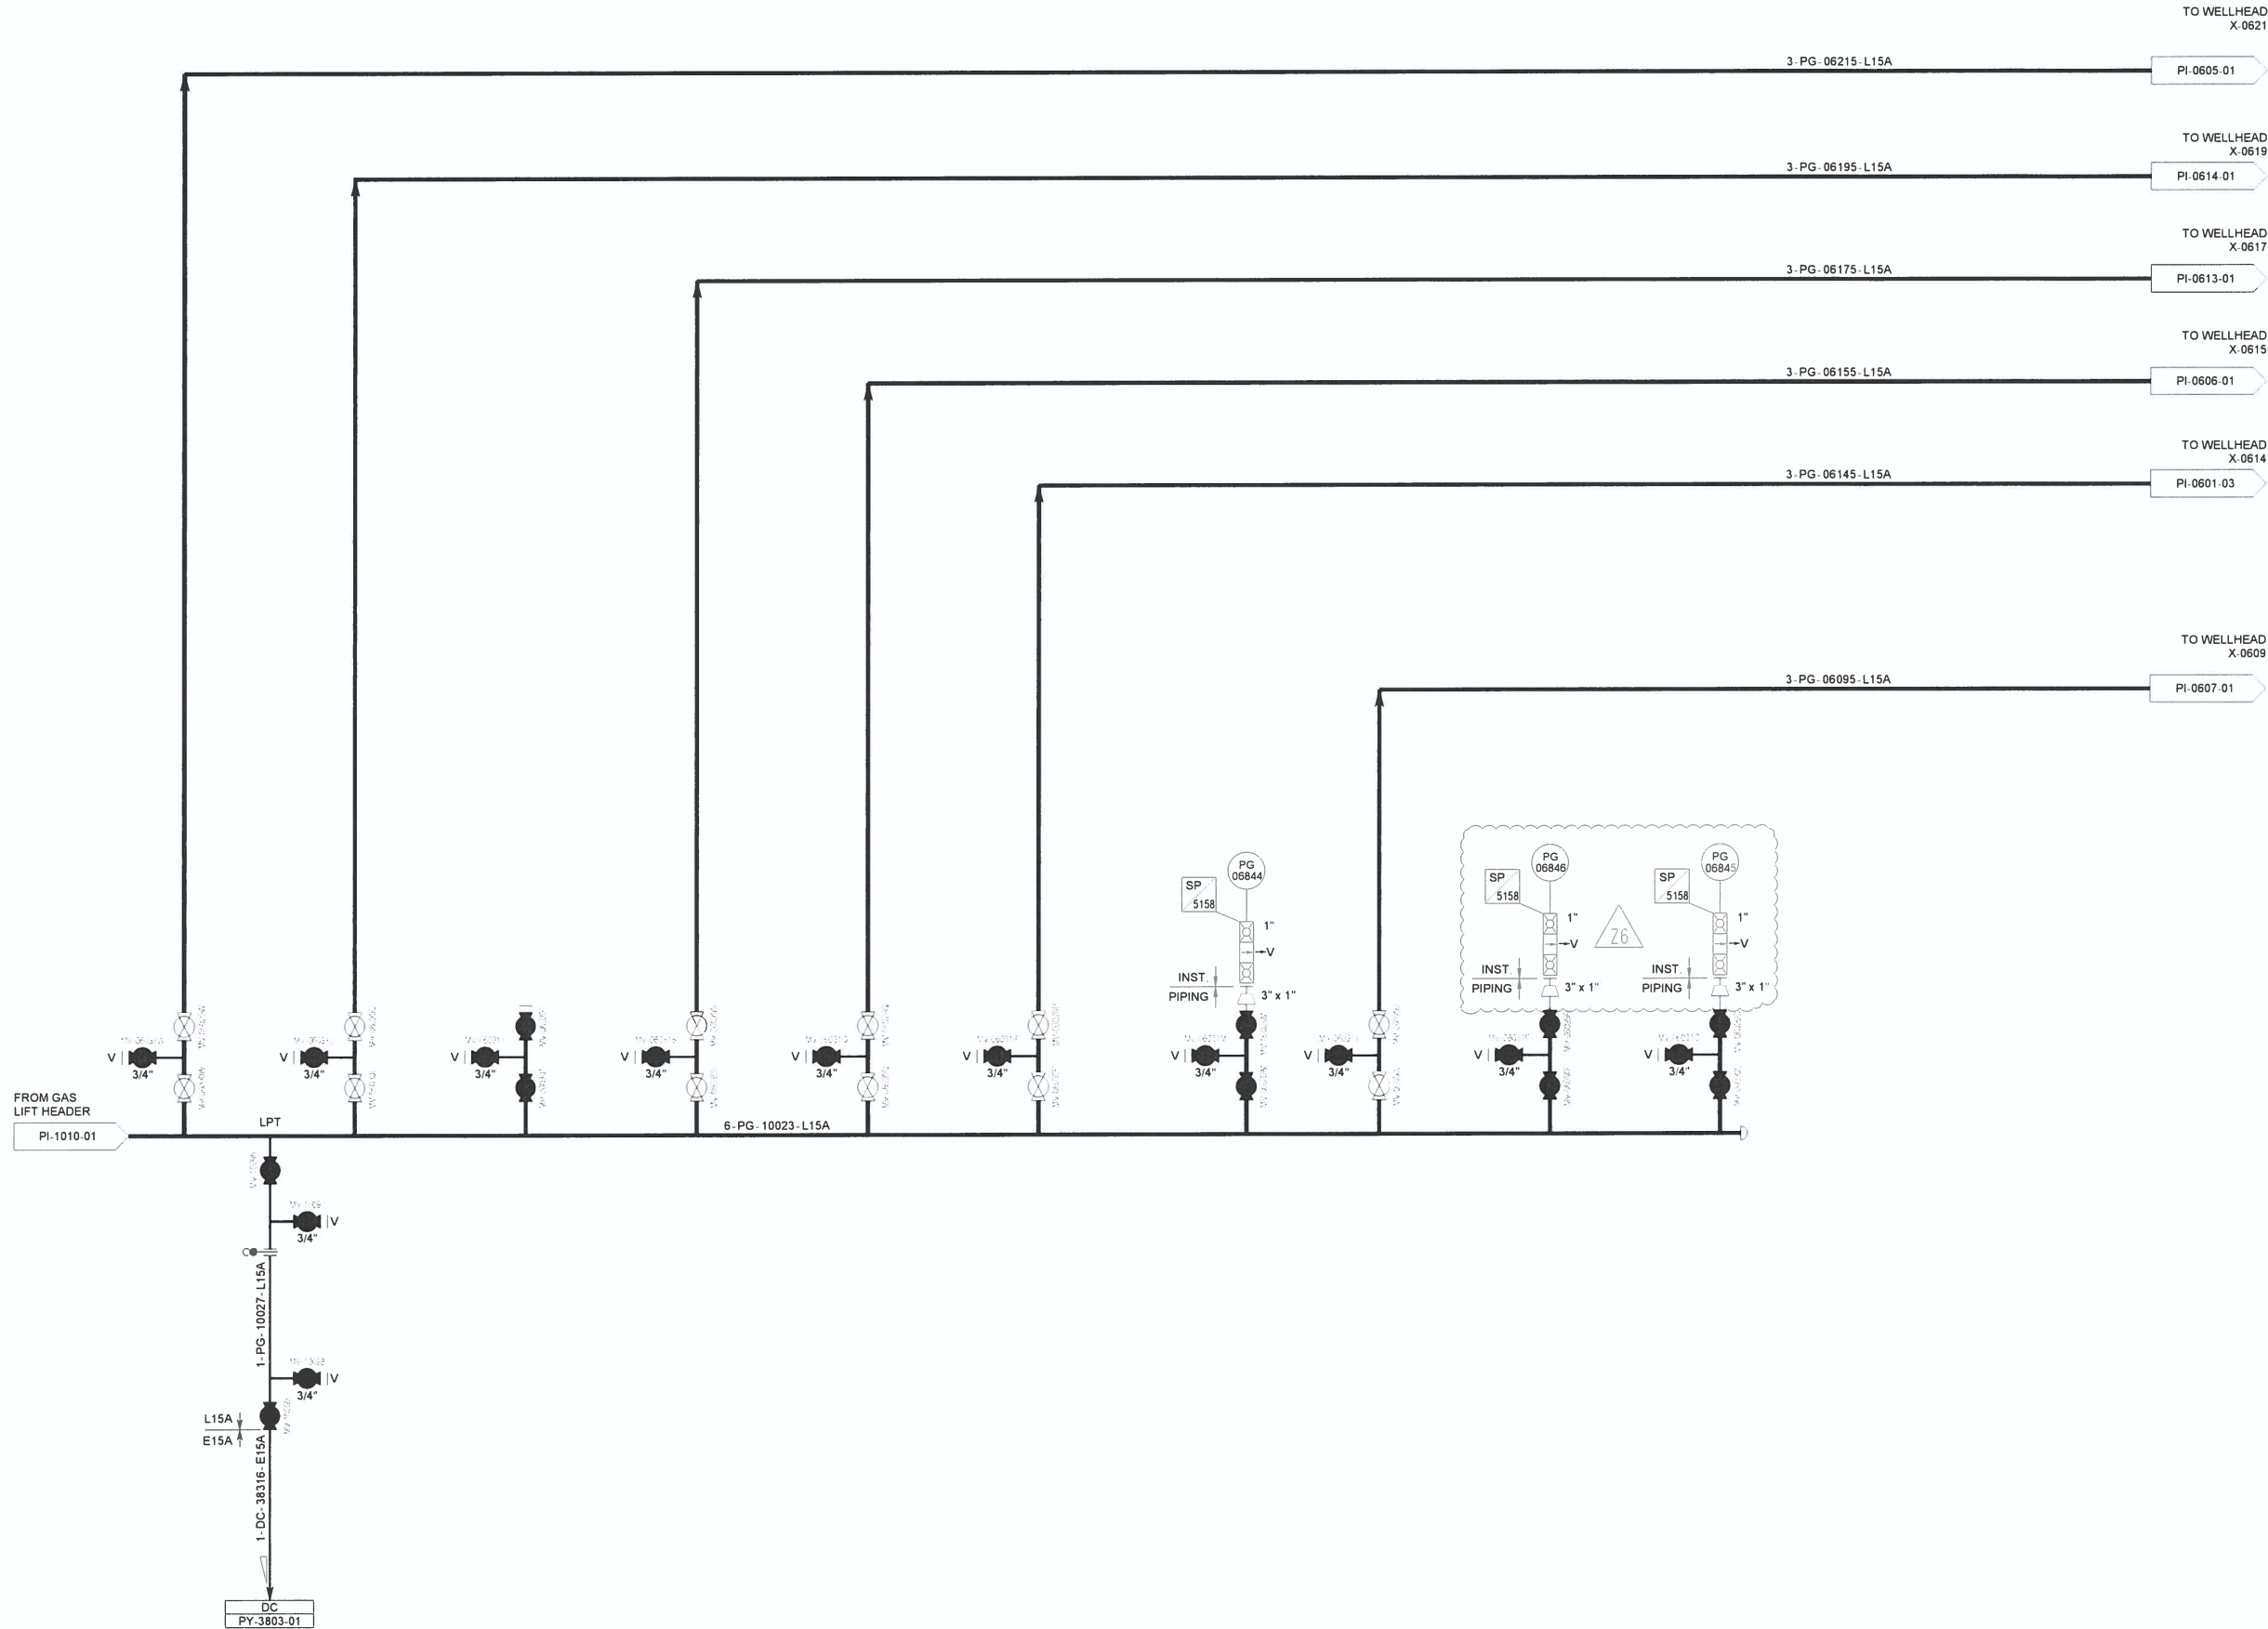

NOTES

REFER TO LEGEND SHEETS 168397-100-PR-PI-0001 TO 0012 FOR DETAILS OF PIPING CLASS, INSULATION, EQUIPMENT TYPES, INSTRUMENT DETAILS, VALVES AND SPECIFIC HOOK-UP REQUIREMENTS.

1. GAS LIFT WILL NOT BE REQUIRED AT THE OUTSET. EACH FLOWLINE IS TO BE ISOLATED FROM ITS RESPECTIVE WELL UNTIL REQUIRED.

| | | | | | | |
|-----|------------|----------------------------------|-----|-----|-----|-----|
| Z1 | 11/07/2014 | AS BUILT | JPN | JG | JG | JM |
| Z6 | 14/09/2023 | AS-BUILT FOR GMOC0675 | SD | TF | TF | |
| Z5 | 05/11/20 | AS-BUILT FOR GMOC0513 | TF | JL | JL | TR |
| Z4 | 15/09/16 | AS BUILT FOR GMOC0001 & GIC0020 | LM | AH | AH | TR |
| Z3 | 06/04/2016 | AS-BUILT FOR GMOC0001 | LM | SB | JL | TR |
| Z2 | 07/10/2015 | AS-BUILT FOR AD-HOC AND GMOC0001 | LM | JL | AH | TR |
| REV | DATE | DESCRIPTION | DRN | CHK | APP | CLT |



TITLE:
PIPING & INSTRUMENT DIAGRAM
GAS LIFT MANIFOLD (EAST)

| | |
|---------------------|------------------------------------|
| SCALE (A1): | NTS |
| ASSAI No: | PR18PU0011 |
| CONTRACT No: | 168397 |
| CLIENT CONTRACT No: | GEA-CT-CON-00808 |
| DRAWING No: | 168397 - 100 - PR - PI - 1012 - 01 |
| REV | Z6 |