
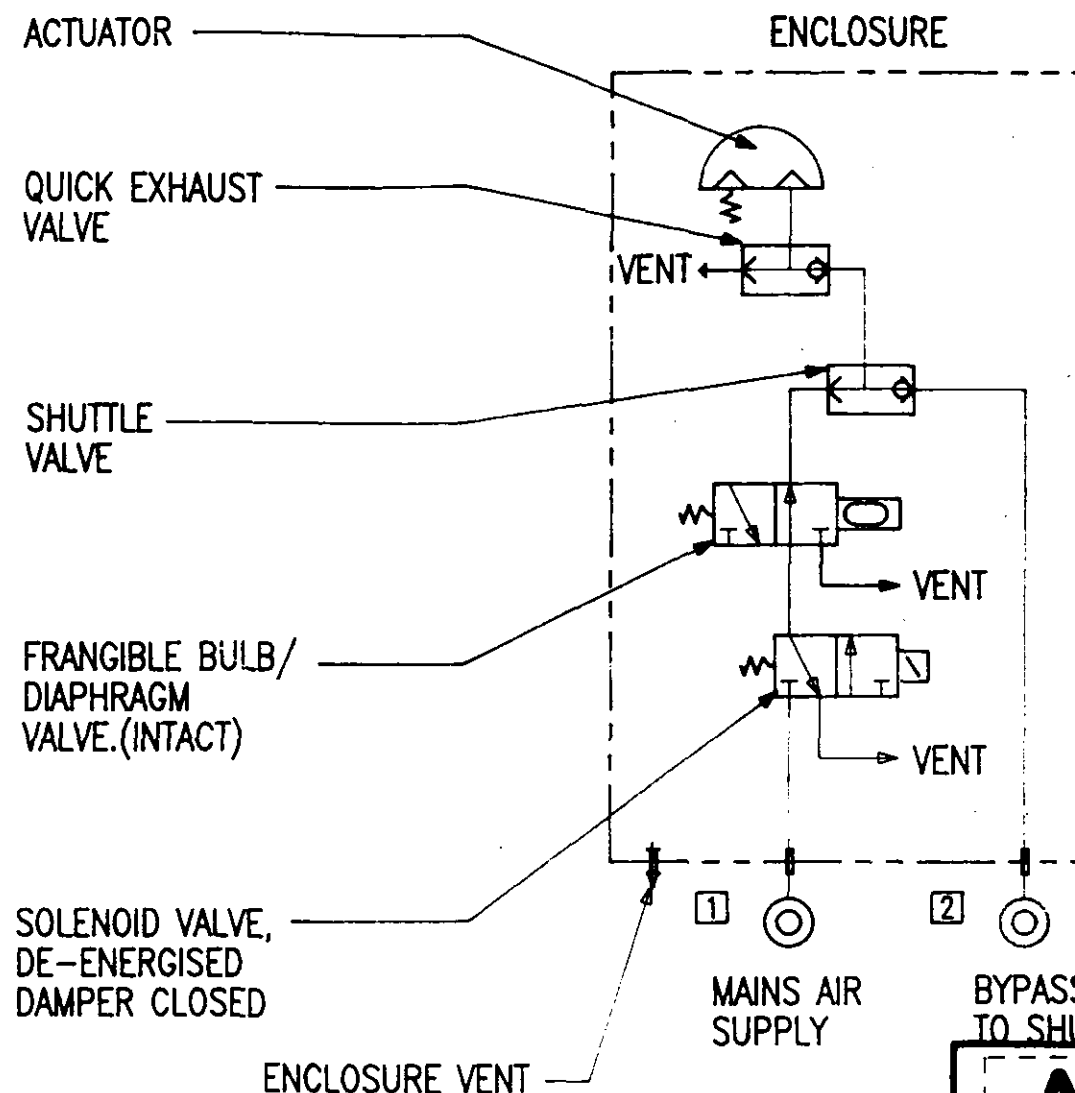


IF IN DOUBT - ASK

THIRD ANGLE PROJECTION

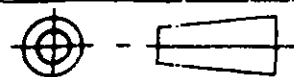

# GENERAL NOTES

- FOR A FULL ITEMS DESCRIPTION REFER TO GENERAL ARRANGEMENT DRAWING 1-2920-10
- DAMPER SHOWN IN CLOSED POSITION.
- AIR SUPPLY :- 4.5 Barg Min, 10.6 Barg Max..

**AS SUPPLIED**

**Sellers statement :**  
This document accurately represents the as supplied condition of the work

Seller's Authorized Signature: *[Signature]* Date: 11-6-92.

<b>PURCHASER RETURN CODES</b>		AMERADA HESS LIMITED	
<input type="checkbox"/> 1 ACCEPTED "AS SUPPLIED" <input checked="" type="checkbox"/> 2 ACCEPTED - NO COMMENTS <input type="checkbox"/> 3 QUALIFIED ACCEPTANCE - MINOR COMMENTS REVISE & RESUBMIT AS "AS SUPPLIED" WORK MAY PROCEED. <input type="checkbox"/> 4 QUALIFIED ACCEPTANCE - MINOR COMMENTS REVISE & RESUBMIT TO OBTAIN CODE 2 WORK MAY PROCEED. <input type="checkbox"/> 5 QUALIFIED ACCEPTANCE - MAJOR COMMENTS REVISE & RESUBMIT TO OBTAIN CODE 2 WORK MAY PROCEED. <input type="checkbox"/> 6 REJECTED - REVISE & RESUBMIT IMMEDIATELY WORK MAY NOT PROCEED IN THE AFFECTED AREAS. <input type="checkbox"/> 7 REVIEW NOT REQUIRED.		SCOTT FIELD DEVELOPMENT	
PACKAGE DESC.		HVAC DAMPERS	
EQUIP. No.'s			
SDRS CODES		D01, F02	
MODULE		ACCOMM L1 SHEET 1 of 1	
DOCUMENT No		REV	
PURCHASE ORDER/No		SHORT	SEQUENCE No
SIGNATURE: <i>[Signature]</i>		P, 0, 0, 5, 6	D, 0, 0, 0, 1, 0, 1
DATE: 11/10/92			

ALL DIMENSIONS IN MILLIMETRES UNLESS STATED

THIS DRAWING AND ANY DESCRIPTIVE MATTER SET OUT HEREON ARE THE CONFIDENTIAL AND COPYRIGHT PROPERTY OF CALIDAIR MFG LTD AND MUST NOT BE DISCLOSED, LOANED, COPIED OR USED FOR MANUFACTURING, TENDERING OR ANY OTHER PURPOSE WITHOUT THEIR WRITTEN PERMISSION © AS DATE BELOW				DRAWING MODE				DRAWN J. HARDMAN			
				PROPOSAL		NOT TO BE USED FOR CONSTRUCTIONAL PURPOSES		CHECKED <i>[Signature]</i>			
				QUOTATION				TRACED			
				ISSUED FOR APPROVAL		DATE 07.10.91		TOLERANCES UNLESS OTHERWISE STATED			
ISSUED FOR MANUFACTURE		DATE		DIMS. UP TO 499 ± 1.5							
CERTIFIED		INITIALS		DATE		500 - 999 ± 2.5					
AS BUILT		INITIALS		DATE		1000 - 1499 ± 3.5					
						1500 - ± 4.5					
DRAWN IN ACCORDANCE WITH B.S. 400											

Calidair MANUFACTURING LIMITED		TITLE PNEUMATIC DIAGRAM FOR TYPE CFD-01 FIRE/GAS DAMPER	
SAFETY TECHNOLOGY		ORIGINAL SCALE	DRAWING No
		N/A	3-2920-40
			SHEET 1/1

ISSUE	DATE	4th OCT 1991
01	ORIGINAL ISSUE	
ISSUE	DATE	
02		
ISSUE	DATE	
03		

