


REV	DATE	DESCRIPTION	DWN.	CHK.	APP.
08	03/12/13	As Bult	PPrata	SCAFUR	RUGGERO
07	25/9/13	As Bult	PPrata	SCAFUR	RUGGERO
06	12/09/13	As Bult	PPrata	SCAFUR	RUGGERO
05	19-10-12	Revised	DRAGONE	SCAFUR	RUGGERO
04	29-10-12	Revised	DRAGONE	SCAFUR	RUGGERO
03	06-08-12	Revised	SCAFURI	SAVATTERI	RUGGERO
02	30-05-12	Revised	SKRIVASAM	SAVATTERI	MLATI

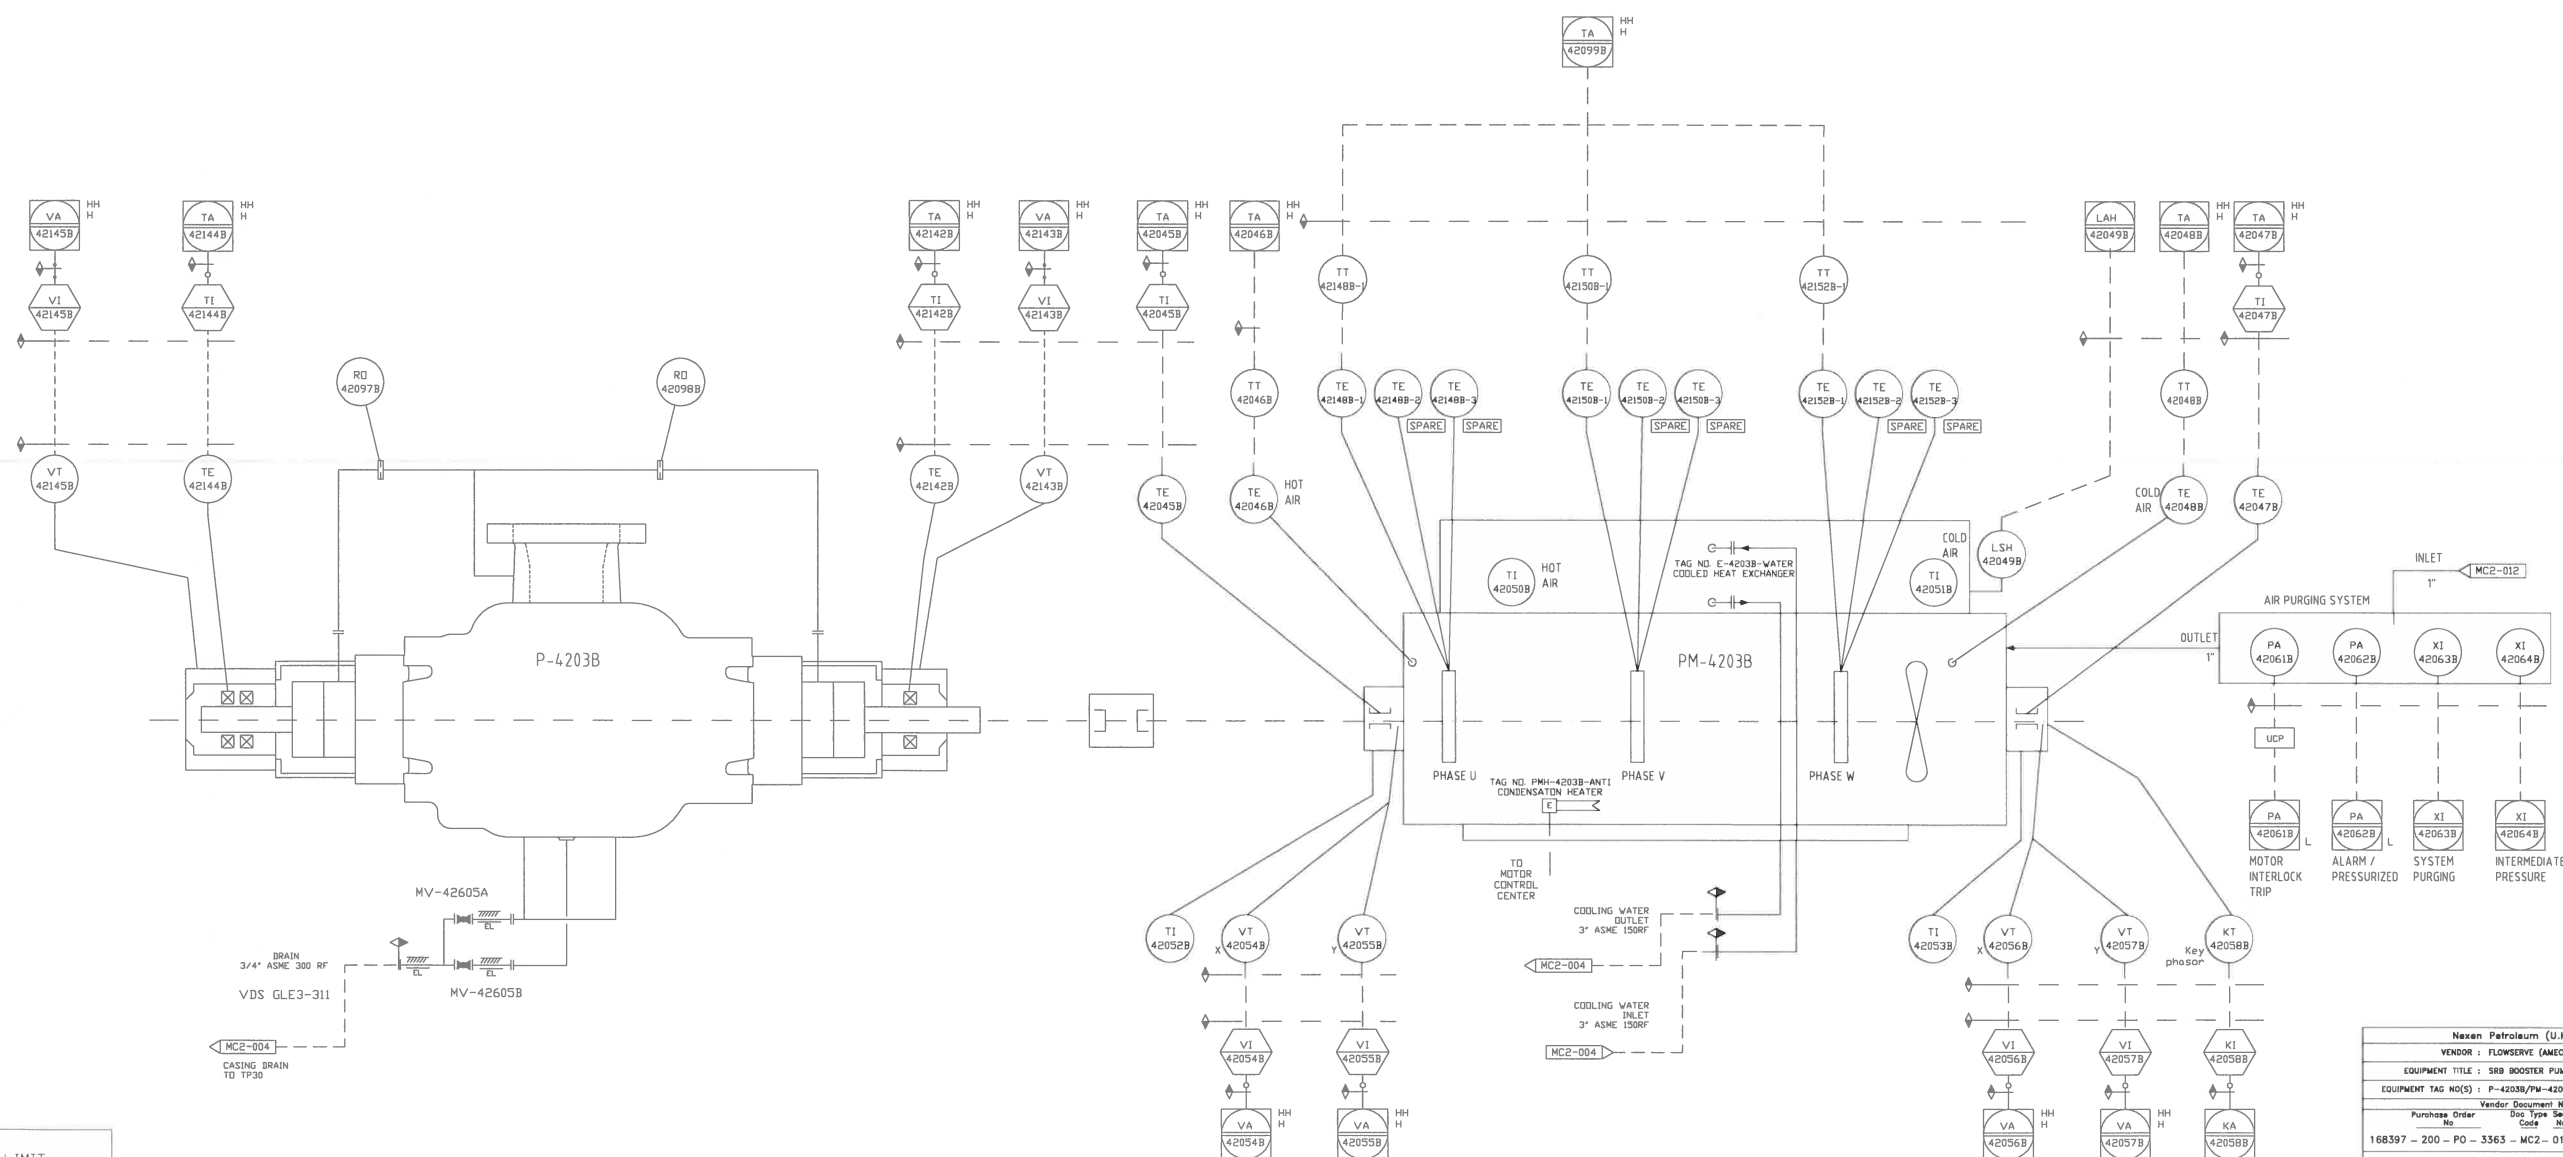

- From Bently Nevada to UCP XS-42101B common trip is SIL 1 category
- Not in Flowserve scope

Naxos Petroleum (U.K.) Limited									
VENDOR : VERBODEN (AMC) FN									
EQUIPMENT TITLE : SRB BOOSTER PUMPS									
EQUIPMENT TAG NO(S) : P-4203B/FN-4203B									
Purchase Order		Doc Type		Sheet		Rev		DATE	
No		No		No		No			
168397	200	PO	3363	MC2	01	02			24/10
SUPPLIER DOCUMENT REVIEW									
<p>Rejected (Asat Doc = REJ) - Quality control is not in conformity with Contract requirements. Documents are rejected by Supplier to expedite the necessary changes and subsequently re-submitted.</p> <p>Accepted with Comments (Asat Doc = ACC) - Generally acceptable. Comments are to be addressed. Document shall be reviewed by Supplier to ensure the necessary changes are incorporated and subsequently re-submitted.</p> <p>Accepted As Final (Asat Doc = FNO) - Documents are considered acceptable. No re-submit.</p> <p>Accepted For Information (Asat Doc = AFI) - No further action required, do not re-submit.</p>									
<p>Review of Vendor documents shall not relieve Vendor of the responsibility for correctness under the Purchase Order. Permission to proceed does not constitute acceptance of the Vendor's work or materials. Methods or materials developed or selected by the Vendor and does not relieve the Vendor from full responsibility for the Purchase Order or any other obligations, not defined in or by the Purchaser's rights.</p>									
REV	DATE		AD-NO				AS-BUILT		
1	26/10/16		DISCUSSION				DRN CHK APP		

P.O. NUMBER	4504790805		
CUSTOMER	Siemens Oil & Gas		
JOB	Golden Eagle Area Project		
PLANT	Golden Eagle Area Development		
END USER	Naxos petroleum UK Limited		
SERVICE	SRB Booster Pumps		
ITEM	P-4203B	PM-4203B	
SERIAL N.			
CUSTOMER INFORMATION			
STATUS OF APPROVAL			
REVISED			
ORDER NO. 4193371			
DRAWN BY	DATE	CHKD BY	DATE
WILLIST	05/06/12		
DESIGNED BY	DATE	CHKD BY	DATE
	05/06/12		
APPROVED BY	DATE	CHKD BY	DATE
REVIEWED BY	DATE		
Extruder			
Substitutes			
CAD FILE			
SCALE	-	UNITS	mm
SHEET	1	TOTAL SHEETS	2
10 HDX 19B		REV.	
PIPING & INSTRUMENT DIAGRAMS		REV.	
SRP BOOSTER PUMPS		REV.	
SIZE		DRAWING NO.	
A0		DEM408903	