

IF IN DOUBT ASK

THIS DRAWING CONTAINS PROPRIETARY INFORMATION BELONGING TO CONSAFE ENGINEERING (UK) LTD. AND MAY NOT WHOLLY OR PARTIALLY BE REPRODUCED NOR DISCLOSED WITHOUT PRIOR WRITTEN PERMISSION OF CONSAFE ENGINEERING (UK) LTD.

LEGEND

W/M – WASHING MACHINE

DEEP SEAL TRAP

PRESSURE REDUCING/FILTER SET

ISOLATER VALVE

A60 RATED PENETRATION

AIR ADMITTANCE VALVE


RODDING OUT POINT

T1 – DRAIN 75mm

T2 – COLD WATER INLET 3/4" BSP

FLEXIBLE CONNECTION

OUT LINE OF A60 RATED ENCLOSURE

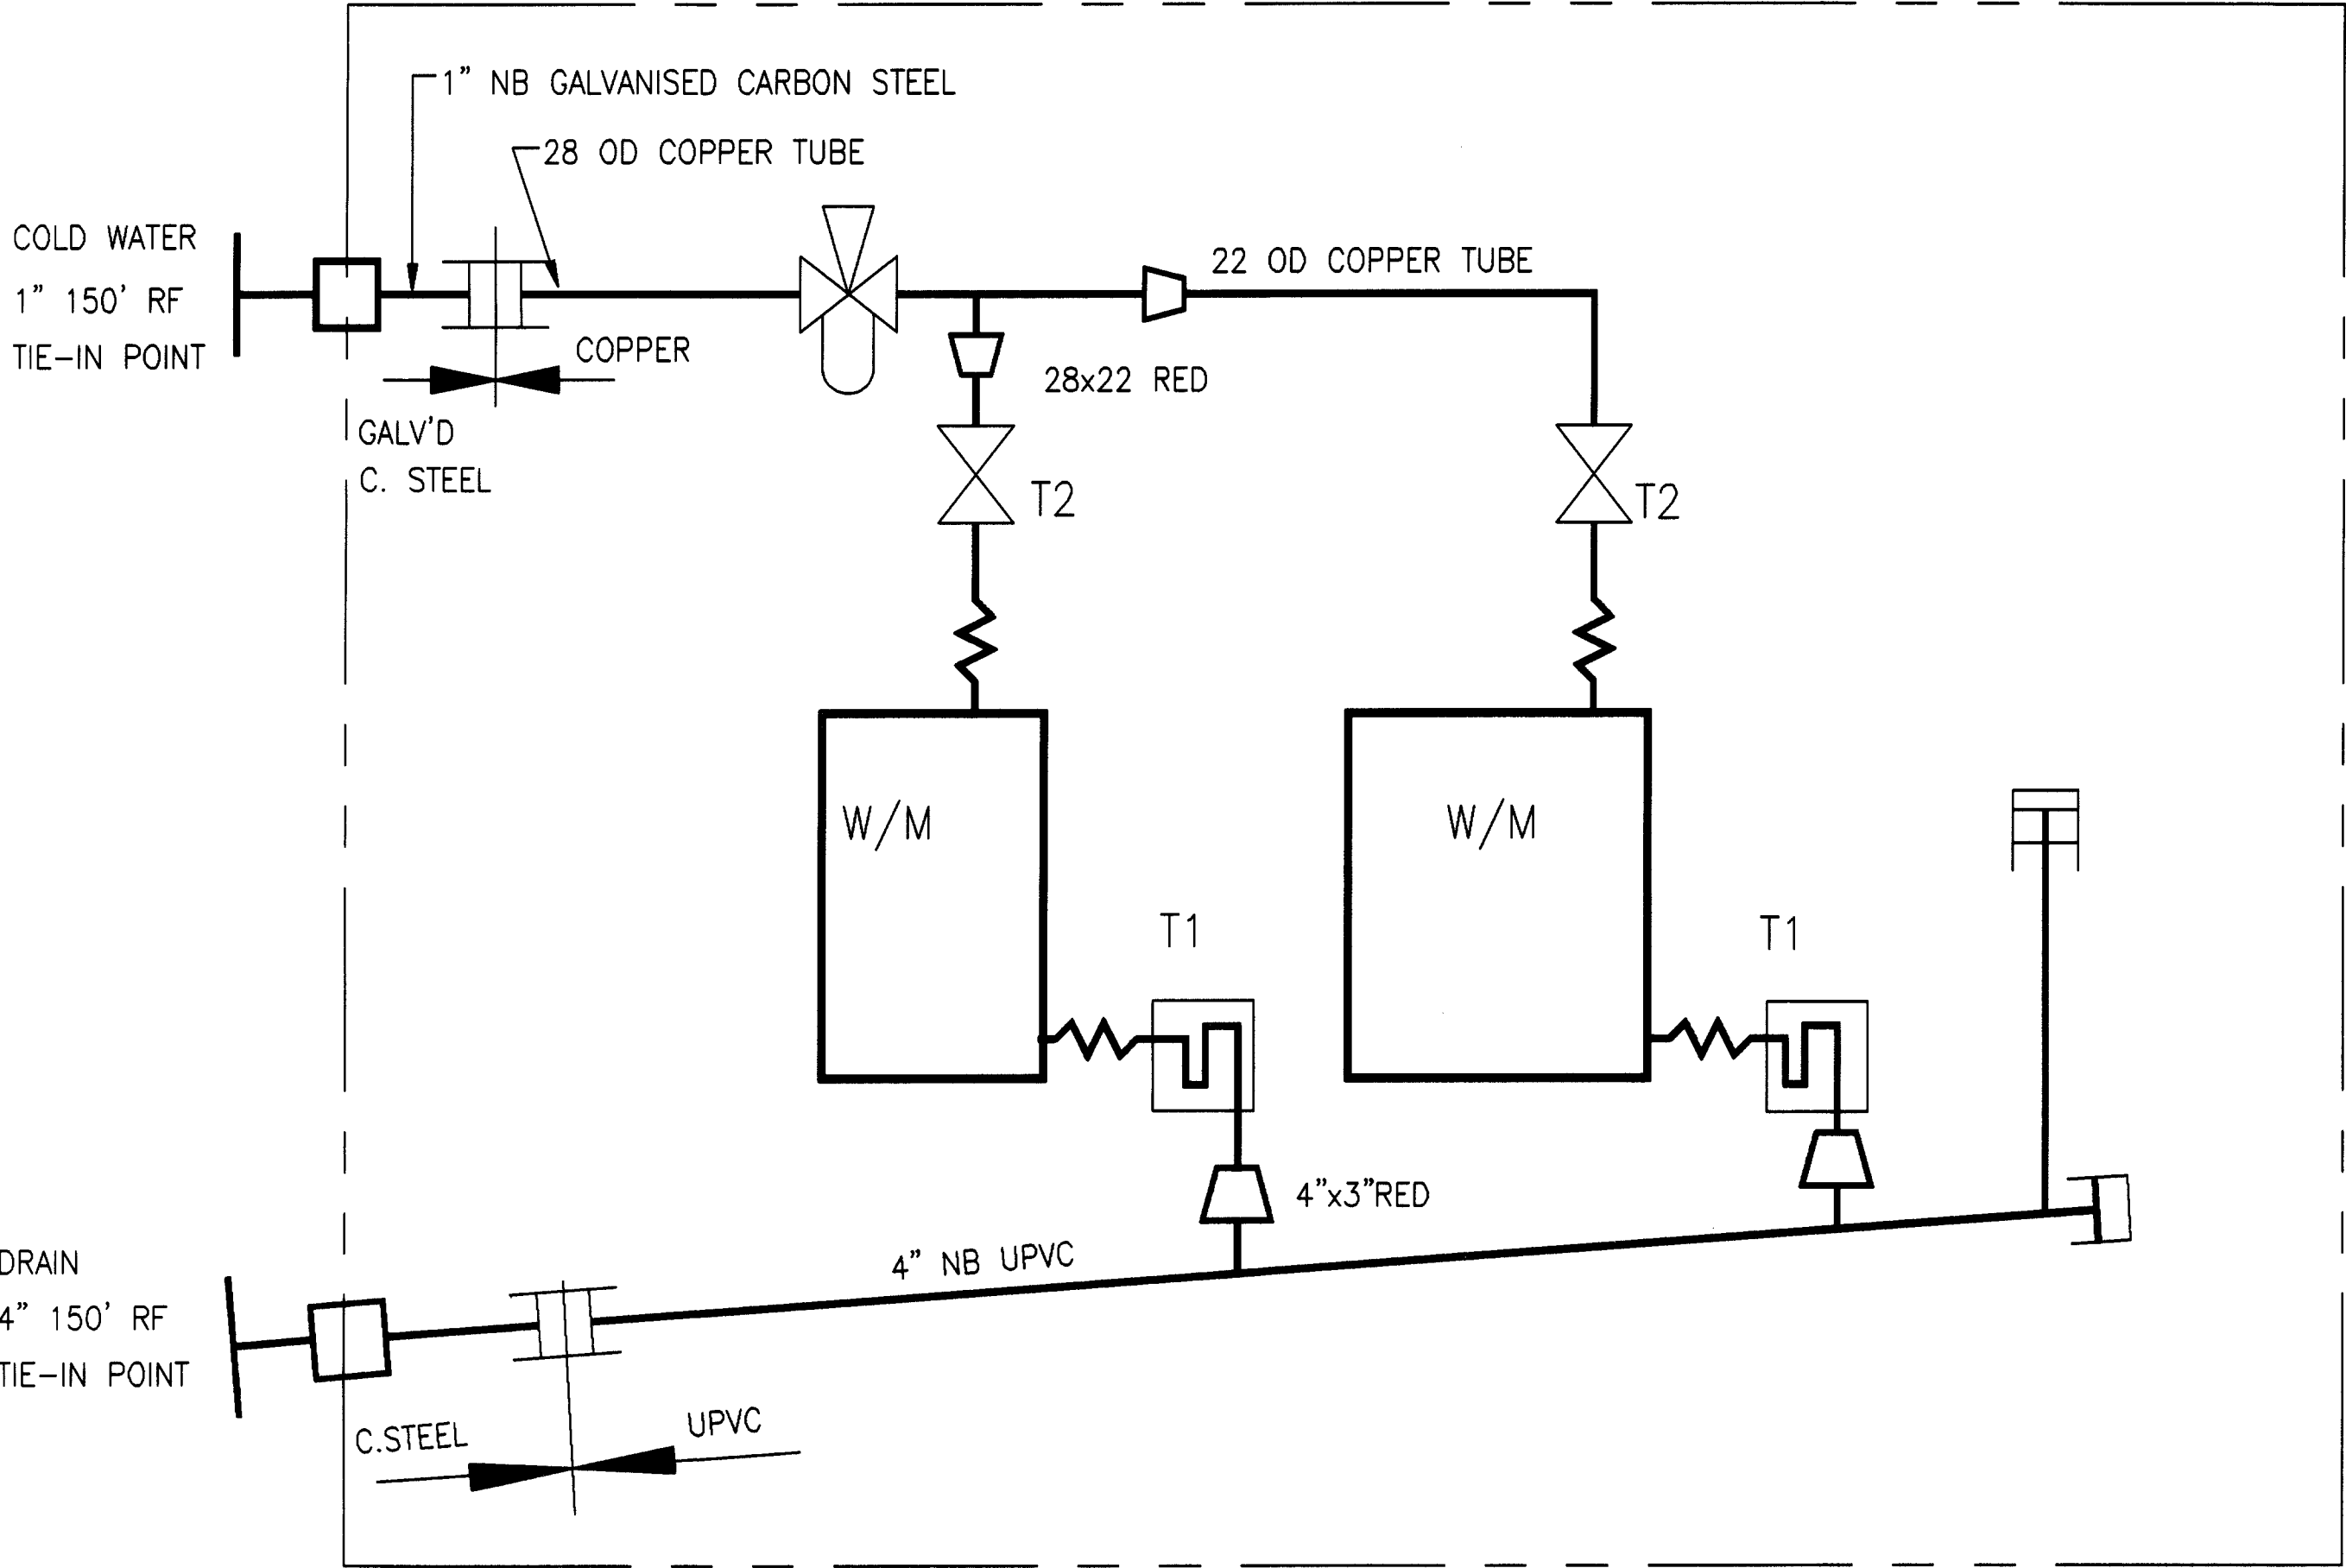

–	C	00-03	SON	AS-BUILT	15/3	JZ
–	B	24/11	LAD	ISSUED FOR CONSTRUCTION	30/11	RDS
–	Q	1/11	LAD	ISSUED FOR TENDER	4/11	RDS
ISSUE	REV	DATE	BY	DESCRIPTION	DATE	CHKD

A	APPROVAL	C	ASBUILT
B	CONSTRUCTION	Q	FOR INFORMATION

CONSAFE ENGINEERING (UK) LTD

CLIENT PROJECT	AMERADA HESS SCOTT FIELD	TITLE	PIPING SERVICES P&ID DIRTY LAUNDRY FACILITY
DRAWN BY	L.A.DYER	DATE	1/11/92
CHECKED BY	R.D-S	DATE	4/11/92
APPROVED BY	J CLARK	DATE	4/11/92
FILE NO.	2422	SCALE	A2
DRG. No.	AB/2422-4-4001		

AMERADA HESS LIMITED  
Scott Field Development

**RETURN CODE 8**  
THIS DOCUMENT HAS  
BEEN ACCEPTED BY  
COMPANY AS  
"AS SUPPLIED"  
WITHOUT ENGINEERING  
REVIEW

<b>AS SUPPLIED</b>	
Seller shall complete both Sections A & B, sign & date	
A All Company comments on previous submission have been fully incorporated <input checked="" type="checkbox"/> Yes <input type="checkbox"/> No <input type="checkbox"/> Not Applicable	
B There are no design changes, other than incorporation of Company comments, from previous submission <input checked="" type="checkbox"/> Yes <input type="checkbox"/> No	
Seller's Verifying Statement: This document accurately represents the "As Supplied" condition of the Work	
Sellers Authorised Signature:	Date: 13-3-93

COMPANY RETURN CODES

- 1. ACCEPTED "AS SUPPLIED"
- 2. ACCEPTED NO COMMENTS
- 3. QUALIFIED ACCEPTANCE MINOR COMMENTS REVISE & RESUBMIT AS "AS SUPPLIED" WORK MAY PROCEED
- 4. QUALIFIED ACCEPTANCE MINOR COMMENTS REVISE & RESUBMIT TO OBTAIN CODE 2 WORK MAY PROCEED
- 5. QUALIFIED ACCEPTANCE MAJOR COMMENTS REVISE & RESUBMIT TO OBTAIN CODE 2 WORK MAY PROCEED
- 6. REJECTED REVISE & RESUBMIT IMMEDIATELY WORK MAY NOT PROCEED IN THE AFFECTED AREAS
- 7. REVIEW NOT REQUIRED

COMPANYS  
IGNATURE \_\_\_\_\_ DATE \_\_\_\_\_

AMERADA HESS LIMITED  
SCOTT FIELD DEVELOPMENT

PACKAGE DESC	DIRTY LAUNDRY MODULE
EQUIP. Nos	MY6301
SDRS CODES	DO1
MODULE	DIRTY LAUNDRY SHEET 1 OF 1
PURCHASE ORDER No	T000 ST RM 0022 P1716
DOCUMENT No	D 0001
REV	013