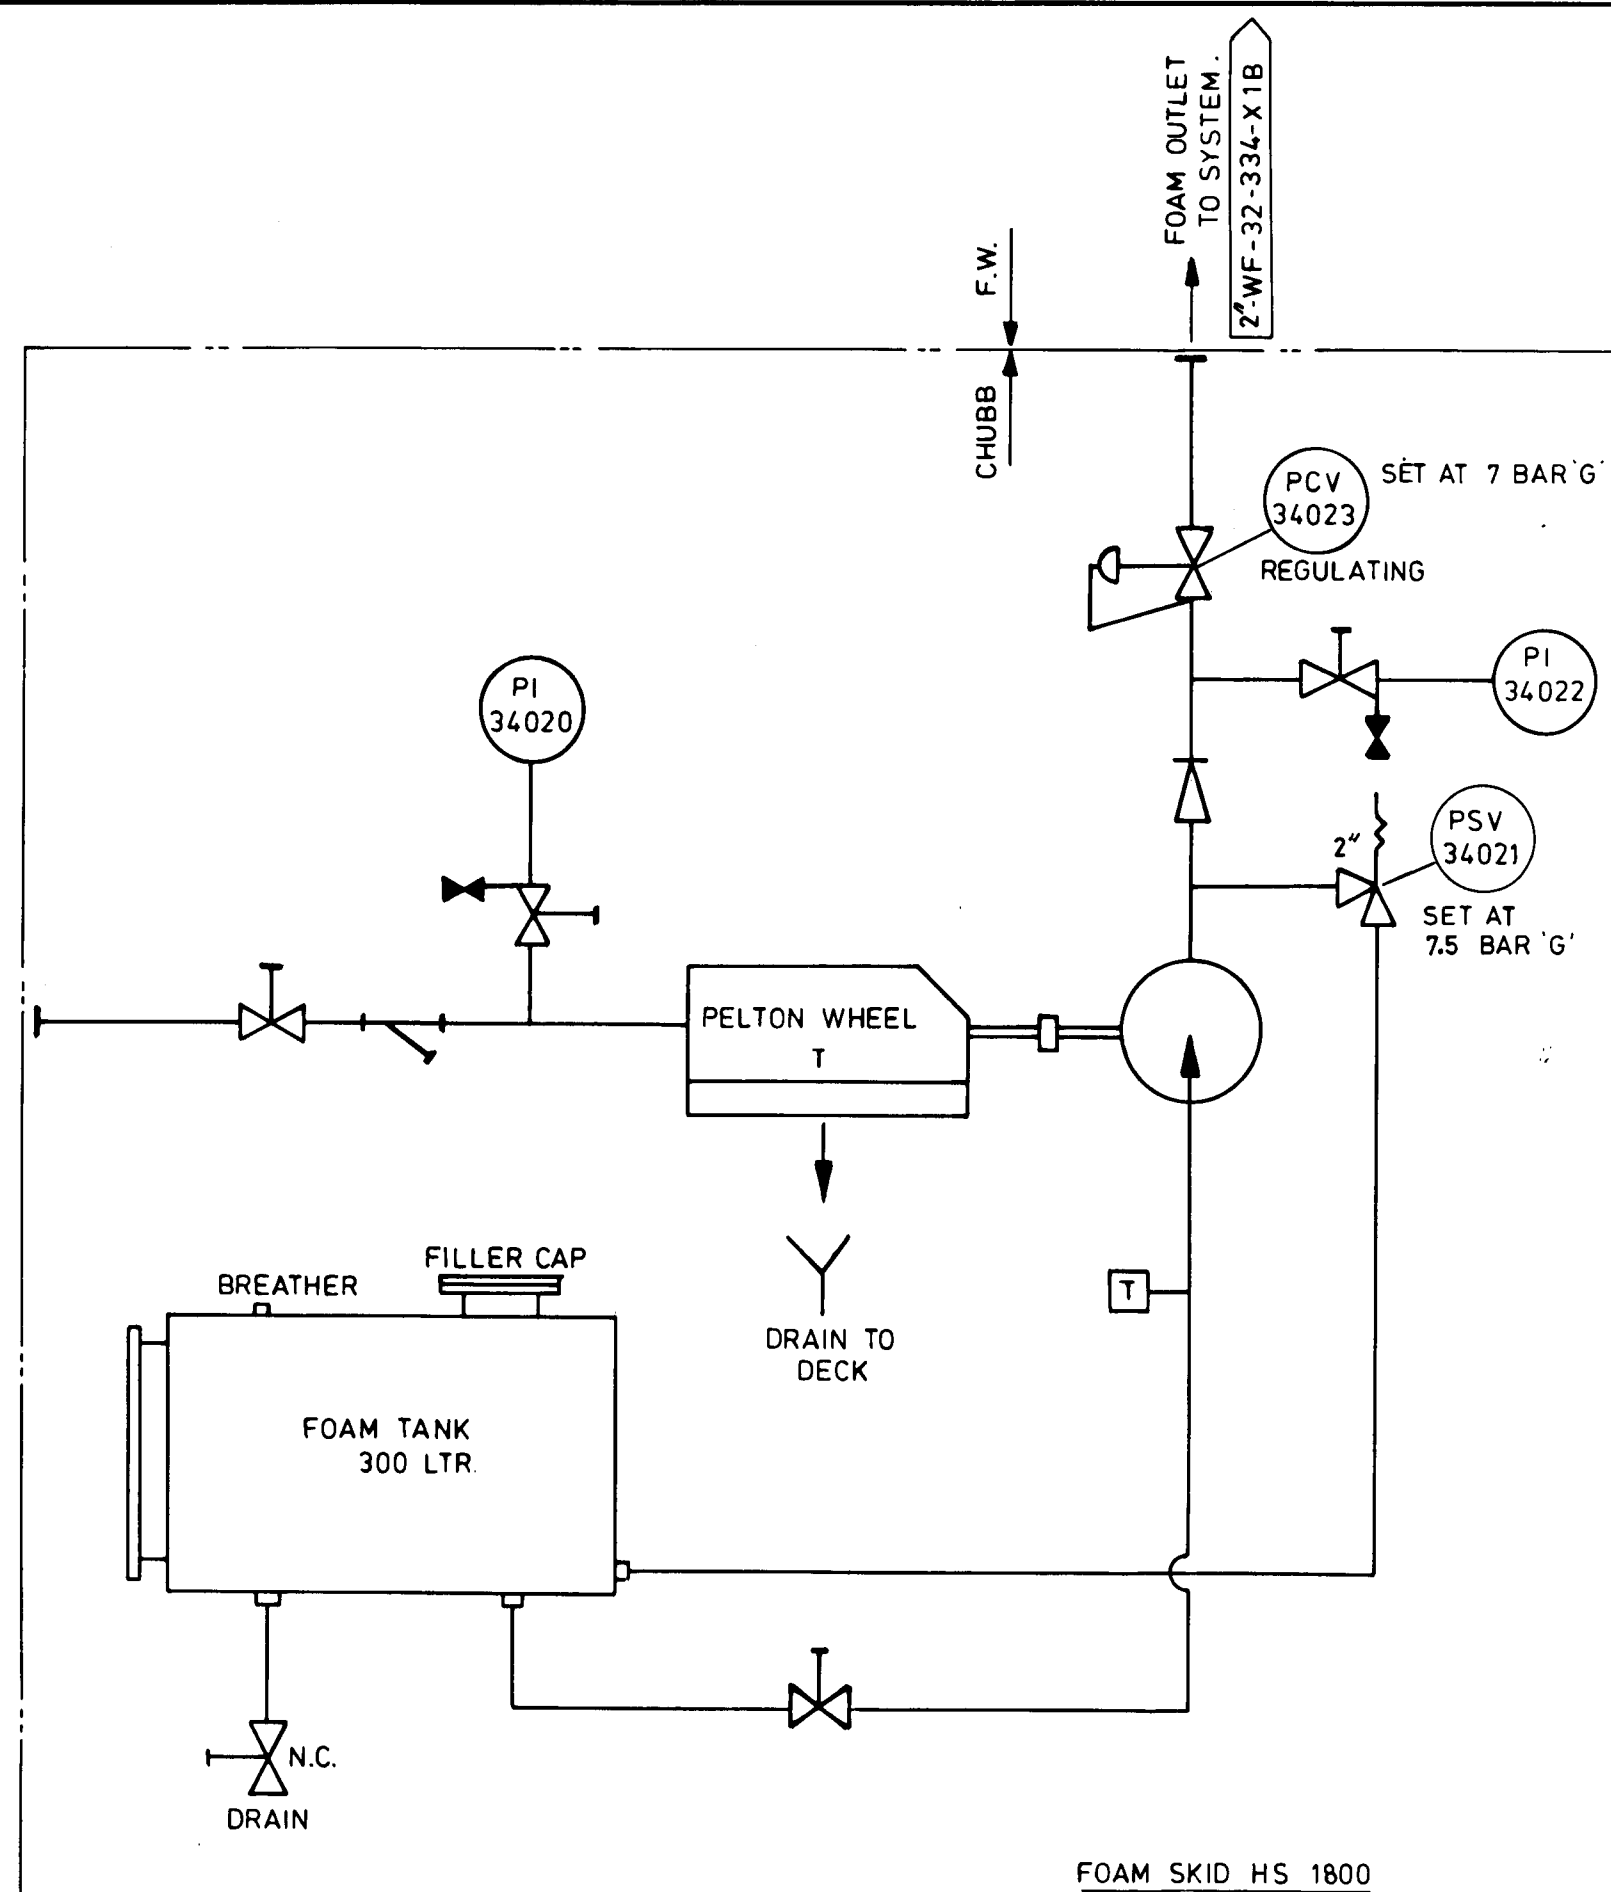
SEAWATER INLET
TO PELTON WHEEL.

2" WF-32-130-X1B

AMERADA HESS LIMITED
Scott Field Development

RETURN CODE 8

THIS DOCUMENT HAS
BEEN ACCEPTED BY
COMPANY AS
"AS SUPPLIED"
WITHOUT ENGINEERING
REVIEW

AS SUPPLIED

Seller shall complete both Sections A & B, sign & date

A All Company comments on previous submission
have been fully incorporated
☒ Yes ☐ No ☐ Not ApplicableB There are no design changes, other than
incorporation of Company comments, from
previous submission
☒ Yes ☐ NoSeller's Verifying Statement:
This document accurately represents the "As Supplied"
condition of the WorkSellers Authorised Signature: *B. Welford* Date: 10.6.92

COMPANY RETURN CODES

- ☐ 1. Accepted "As Supplied"
- ☐ 2. Accepted - No Comments
- ☐ 3. Qualified Acceptance - Minor Comments.
Revise & Resubmit as "As Supplied"
Work May Proceed
- ☐ 4. Qualified Acceptance - Minor Comments.
Revise & Resubmit To Obtain Code 2
Work May Proceed
- ☐ 5. Qualified Acceptance - Major Comments.
Revise & Resubmit To Obtain Code 2
Work May Proceed
- ☐ 6. Rejected - Revise & Resubmit Immediately
Work May Not Proceed In The Affected
Areas
- ☐ 7. Review Not Required

Company's
Signature: _____ Date: _____

AMERADA HESS LIMITED

SCOTT FIELD DEVELOPMENT

Package Desc	Foam Skid		
Equip Nos	LF3402.A		
SDRS Codes	DO.1.		
Module	L160	Sheet 1 of 1	
Purchase Order No	P0130	Document No	0000203
Rev			

REVISIONS
DETAILS SIGNATURE/DATE

ISS C/N	No.	2
ISS No.	1	
INITIAL ISSUE	14-12-90	
DATE	14-12-90	
CLIENT'S COMMENTS INCORPORATED	25-1-91	
DATE	25-1-91	
AS SUPPLIED	6-1-92	
DATE	6-1-92	

SITE

SCOTT FIELD
DEVELOPMENT

CLIENT

AMERADA HESS LIMITED

SO. No. 12259

MATERIAL

FINISH

TITLE
P&I. DIAGRAM FOR FOAM SKID (H.S.1800)
EQUIPMENT N° LF-3402.A.ALL DIMENSIONS IN M/METRES. M/C FINISH
REMOVE ALL BURRS AND SHARP EDGES GEN. TOL. ± 0.4 MM

SCALE:	N.T.S.	DRAWN	N.J.	13-12-90
ENGR.		TRACED		
APPVD.	<i>B. Welford</i>	CHKD.	<i>E</i>	<i>10-90</i>
USED ON		PRODUCT		

DRG. No. 12259-K-02 A2

ISSUE 1/2/3