


XY 14377 (B)  
XY 14378 (C) XY 14376

LOCAL INSTRUMENT

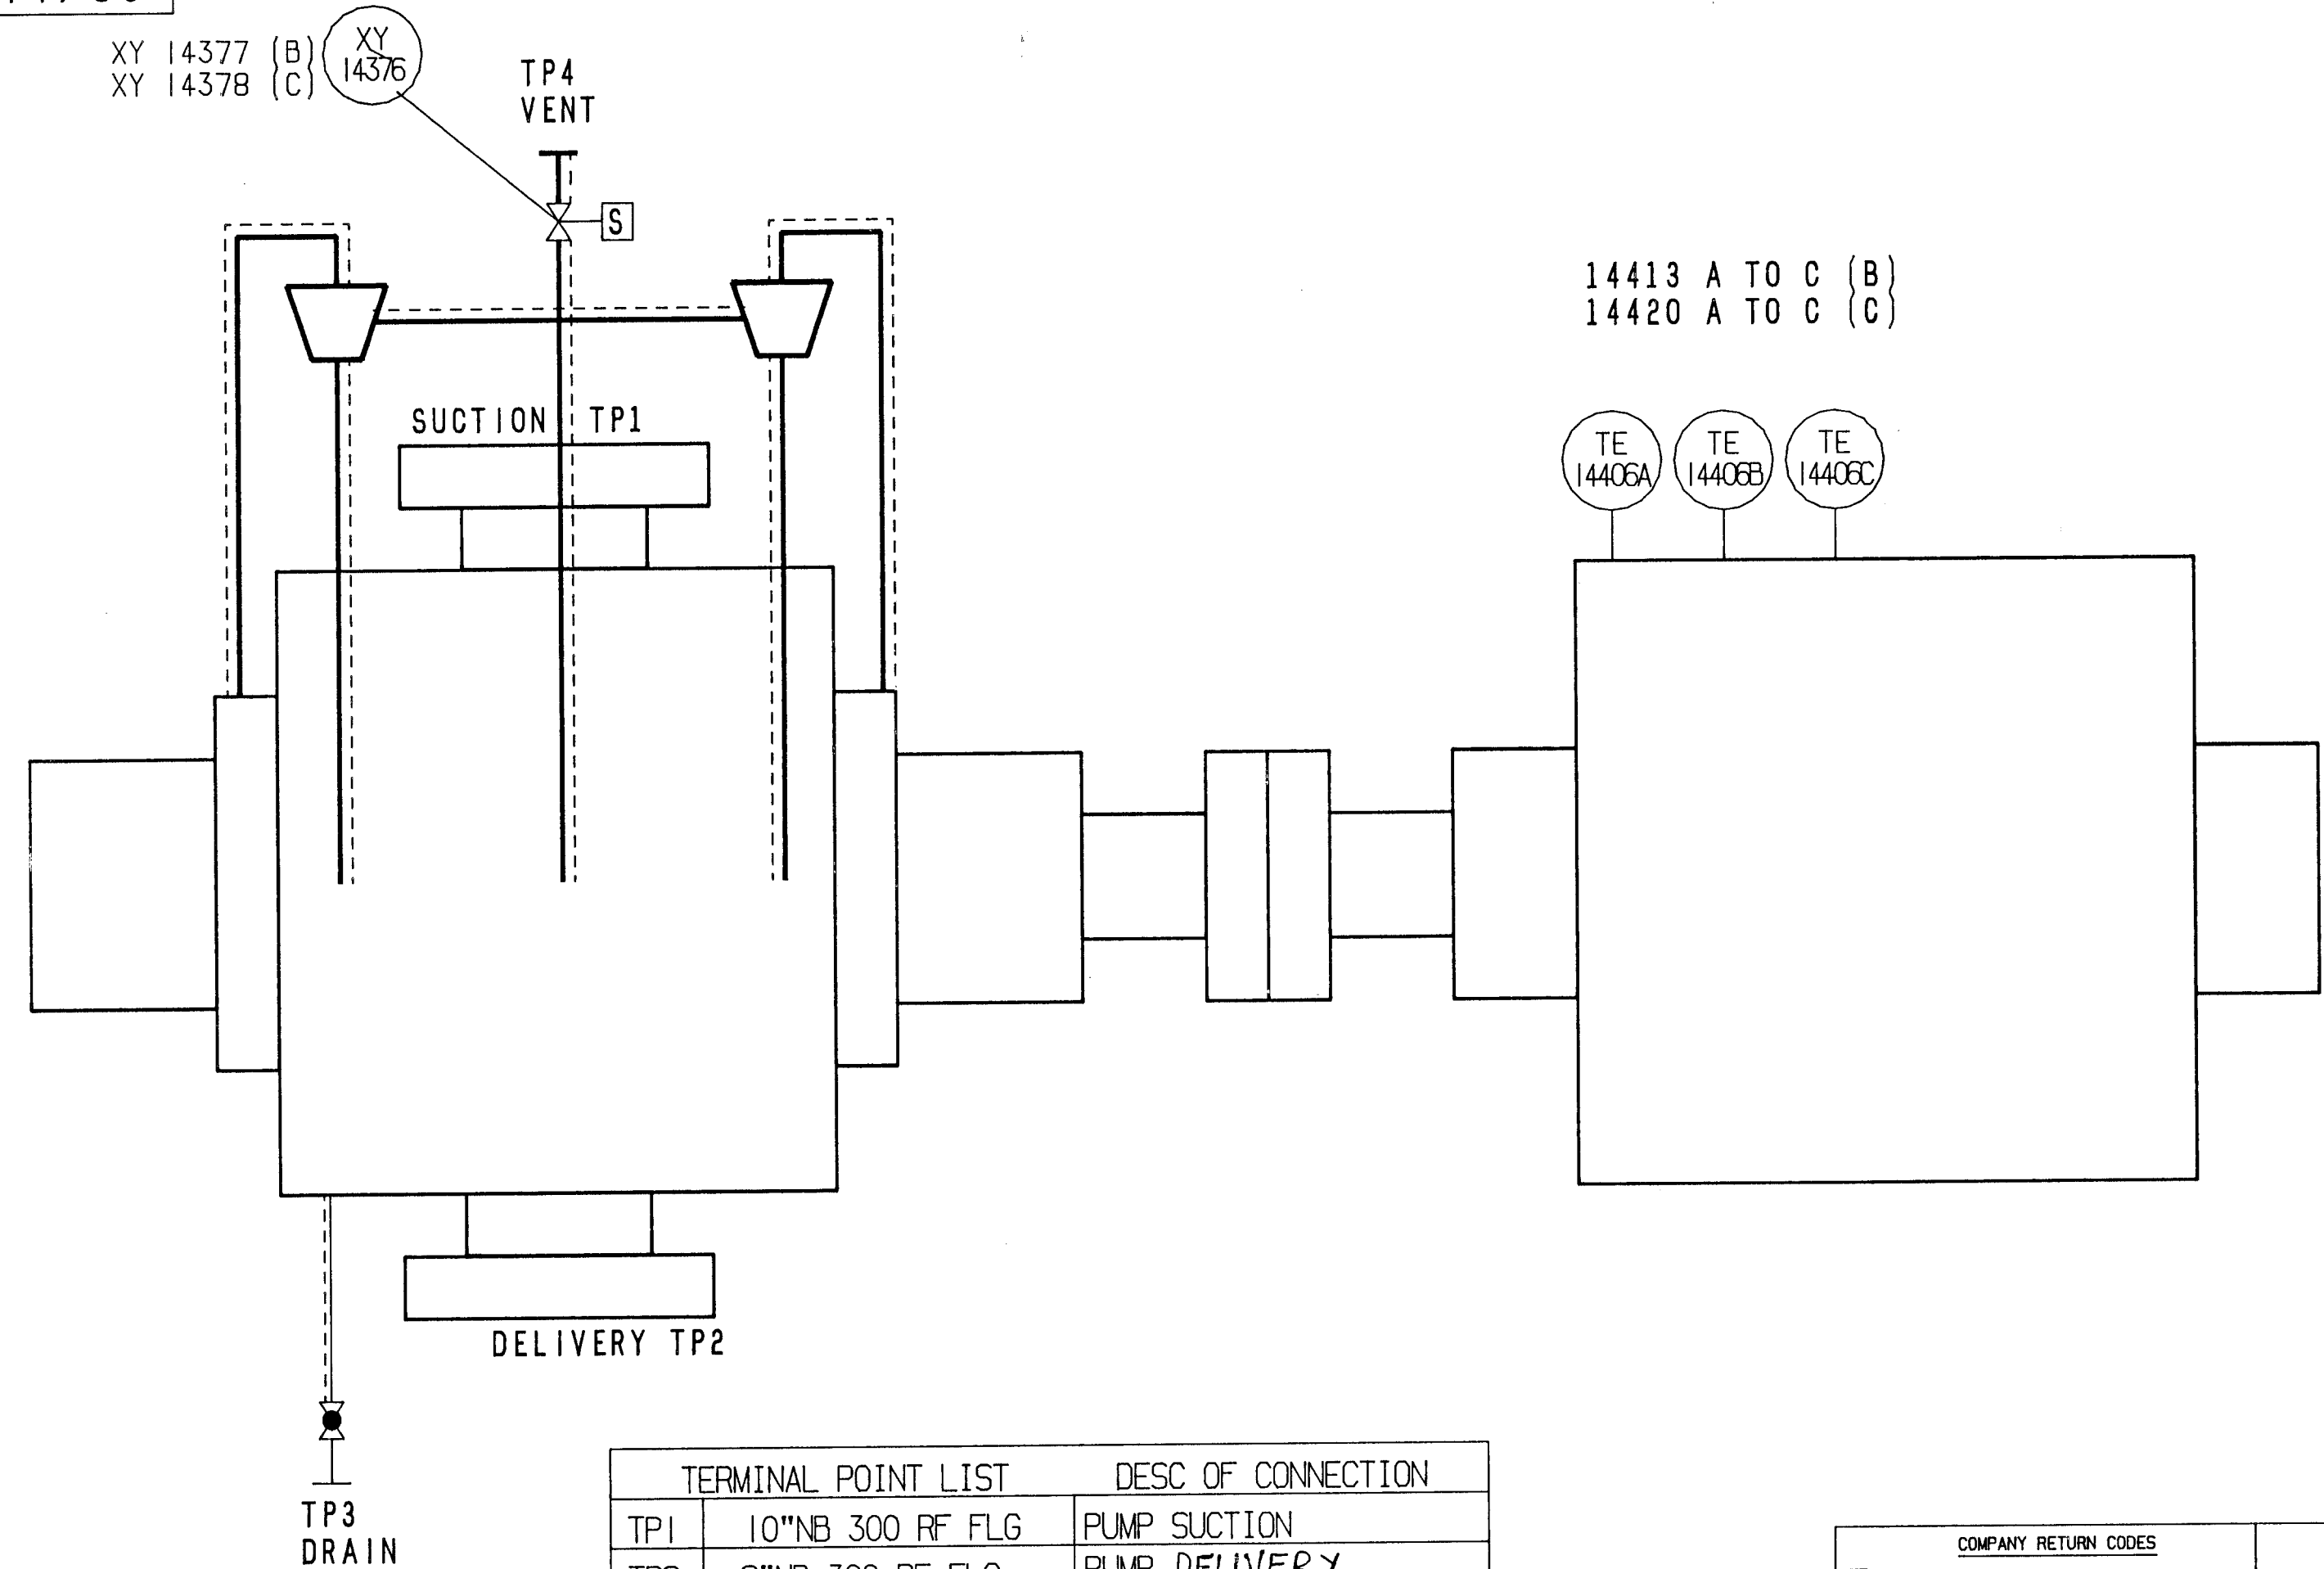

14413 A TO C (B)  
14420 A TO C (C)

TE 14406A  
TE 14406B  
TE 14406C

AS SUPPLIED	
Seller shall complete both Sections A & B, sign & date	
A	All Company comments on previous submission have been fully incorporated <input checked="" type="checkbox"/> Yes <input type="checkbox"/> No <input type="checkbox"/> Not Applicable
B	There are no design changes, other than incorporation of Company comments, from previous submission <input type="checkbox"/> Yes <input checked="" type="checkbox"/> No
Seller's Verifying Statement: This document accurately represents the "As Supplied" condition of the Work	
Sellers Authorised Signature: <i>[Signature]</i> Date: 21/8/92	

TERMINAL POINT LIST		DESC OF CONNECTION
TP1	10"NB 300 RF FLG	PUMP SUCTION
TP2	8"NB 300 RF FLG	PUMP DELIVERY
TP3	3/4"NB 300 RF FLG	PUMP DRAIN
TP4	3/4"NB 300 RF FLG	PUMP VENT
TP5	3/4"NB 150 RF FLG	BEDPLATE DRAIN

COMPANY RETURN CODES		AMERADA HESS LIMITED SCOTT FIELD DEVELOPMENT	
<input checked="" type="checkbox"/> 1. Accepted "As supplied"		Package Desc	SEAWATER INJECTION PUMPS
<input type="checkbox"/> 2. Accepted - No Comments		Equip Nos	PY 1401 A/B/C
<input type="checkbox"/> 3. Qualified Acceptance - Minor Comments. Revise & Resubmit as "As Supplied" Work May Proceed		SORS Code	D01/E10
<input type="checkbox"/> 4. Qualified Acceptance - Minor Comments. Revise & Resubmit To Obtain Code 2 Work May Proceed		Module	0110
<input type="checkbox"/> 5. Qualified Acceptance - Major Comments. Revise & Resubmit To Obtain Code 2 Work May Proceed		Purchase Order No	Document No
<input type="checkbox"/> 6. Rejected - Revise & Resubmit Immediately Work May Not Proceed In The Affected Areas			
<input type="checkbox"/> 7. Review Not Required			
Company Signature: <i>[Signature]</i> Date: 29/9/92		P0027	D 01004

----- LINE WITH TRACE HEATING (BY OTHERS)

THIS DRAWING IS OWNED BY  WEIR PUMPS  LIMITED	AND IS CONDITIONALLY LOANED TO THE RECIPIENT WHO BY RECEIVING IT HAS AGREED NOT TO REPRODUCE OR COPY IT IN WHOLE OR IN PART NOR TO FURNISH INFORMATION FROM IT TO OTHERS NOR TO MAKE ANY USE OF IT THAT IS NOT THE SUBJECT OF WRITTEN AGREEMENT BY WEIR PUMPS LIMITED AND TO RETURN IT UPON REQUEST.						DRN IR CHK JKM APP DP			DATE 16/10/90 DATE 29/10/90 DATE 30/10/90		TITLE PIPING AND INSTRUMENT DIAGRAM FOR SCOTT FIELD BOOSTER PUMPS	
	CROSS REFERENCE		INST LIST T12861P-234		UNIT 12843-705/07								
					DRG NO. A33350P-544/06								
					STATE LATEST ISSUE NO.WHEN QUOTING DRG.								
					PART DESCRIPTION CODE NO.								
ISSUE	REVISION	ORIG	ISSUE	CLIENTS COMMENTS TAG NO	CLIENTS COMMENTS IR 22/8/91	TERMINATORS DELETED IR 16/12/91	DRG ERROR IR 6/8/92						
1		2	15/1/91IR	ADDED TO SOLENOID VALVE									