


ANTI-FOAM PUMPS		
P-5226A	-	0.37kW
P-5226B	-	0.37kW

CONTINUED ON DRG. No. 440010/324

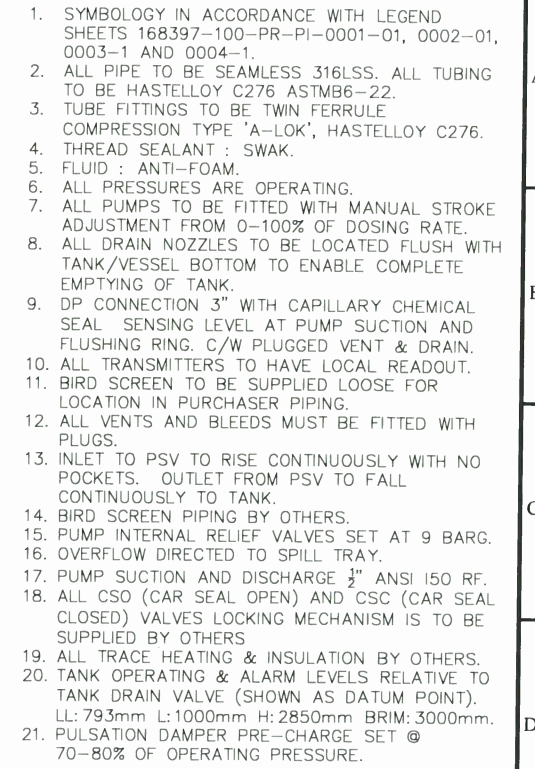

X-5201 TIE-IN SCHEDULE					
TIE-IN No	TANK No	SIZE	RATING	FLANGE	SERVICE
TP5	—	2"	150#	RF	DECANTING PLATFORM INLET
TP12	—	2"	150#	RF	ANTI FOAM VENT
TP19	—	1/2"	150#	RF	ANTI FOAM OUTLET
TP30	—	2"	150#	RF	SPILL TRAY

Nexen Petroleum (U.K.) Limited									
VENDOR :		TYCO (AS-BUILT BY AMEC FW)							
EQUIPMENT TITLE :		CHEMICAL INJECTION PACKAGE (WATER INJECTION) - ANTI FOAM							
EQUIPMENT TAG NO(S) :		X-5201							
Vendor Document Number									
Purchase Order Number		Doc Type Code		Seq. No		Rev.		DATE	
168397-100-PO-3366		MC2		015		Z2		24/5/17	
SUPPLIER DOCUMENT REVIEW									
Rejected (Assai Code = REJ) - Quality and content is out of conformity with Company requirements. Document shall be revised by Supplier to incorporate the necessary changes and subsequently re-submitted.									
Accepted with Comments (Assai Code = AWC) - Generally acceptable but elements require to be addressed. Document shall be revised by Supplier to incorporate the necessary changes and subsequently re-submitted.									
Accepted As Final (Assai Code = FIN) - Documents are considered acceptable, do not re-submit.									
Accepted For Information (Assai Code = AFI) - No further action required, do not re-submit.									
Review of Vendor documents does not relieve Vendor of the responsibility for correctness under the Purchase Order. Permission to proceed does not constitute acceptance of design, detail and calculations, test methods or materials proposed or selected by the Vendor and does not relieve the Vendor from full compliance with the Purchase Order or any other obligations, not detract from any of the Purchaser's rights.									
Z2		24/05/17		AS BUILT AS PER GIC0036				M	
REV	DATE	DESCRIPTION				DRN	CHK	APP	CLT

This drawing is confidential and copyright property of © Tyco Fire & Integrated Solutions and must not be copied or reproduced without their written permission.

~~DO NOT SCALE~~

	Sig	Date
Orig	PA	01/02/1
Chd	TC	01/02/1
App	AG	01/02/4

tyco
Fire & Integrated
Solutions

Project	NEXEN PETROLEUM UK LTD GOLDEN EAGLE AREA DEVELOPMENT CHEMICAL INJECTION PACKAGE
Drawing Title	P&I DIAGRAM - ANTI-FOAM PACKAGE X-5201 WATER INJECTION

Oil & Gas
Barnard Road, Bowthorpe, Tel: +44 (0) 1603 20120
Norwich, Norfolk www.tycofis.com
NR5 9JB England

Contract No. WN440010

Drg No 440010 / 325

4	12/03/13	RE-ISSUED AS-BUILT (CS.017)	CP	DB	TC
3	12/9/12	ISSUED AS-BUILT	PA	TC	AG
2	11/07/12	ISSUED FOR MANUFACTURE	PA	TC	AG
1	30/04/12	ISSUED FOR MANUFACTURE	KP	TC	AG
A	27/02/12	ISSUED FOR APPROVAL	PA	TC	AG
Rev	Date	Description	Orig	Ckd	App

Rev.	Date	Description	Cr.	Dr.

[illegible]

This drawing is confidential and copyright property of © Tyco Fire & Integrated Solutions and must not be copied or lent without their written permission.	Chg TC 01/02/12	Fire & Integrated Solutions
	App AG 01/02/12	Project NEXEN PETROLEUM UK LTD GOLDEN EAGLE AREA DEVELOPMENT CHEMICAL INJECTION PACKAGE
DO NOT SCALE	Drawing Title	P&I DIAGRAM - ANTI-FOAM

Contract No. WN440010