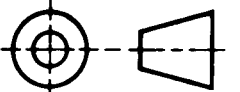
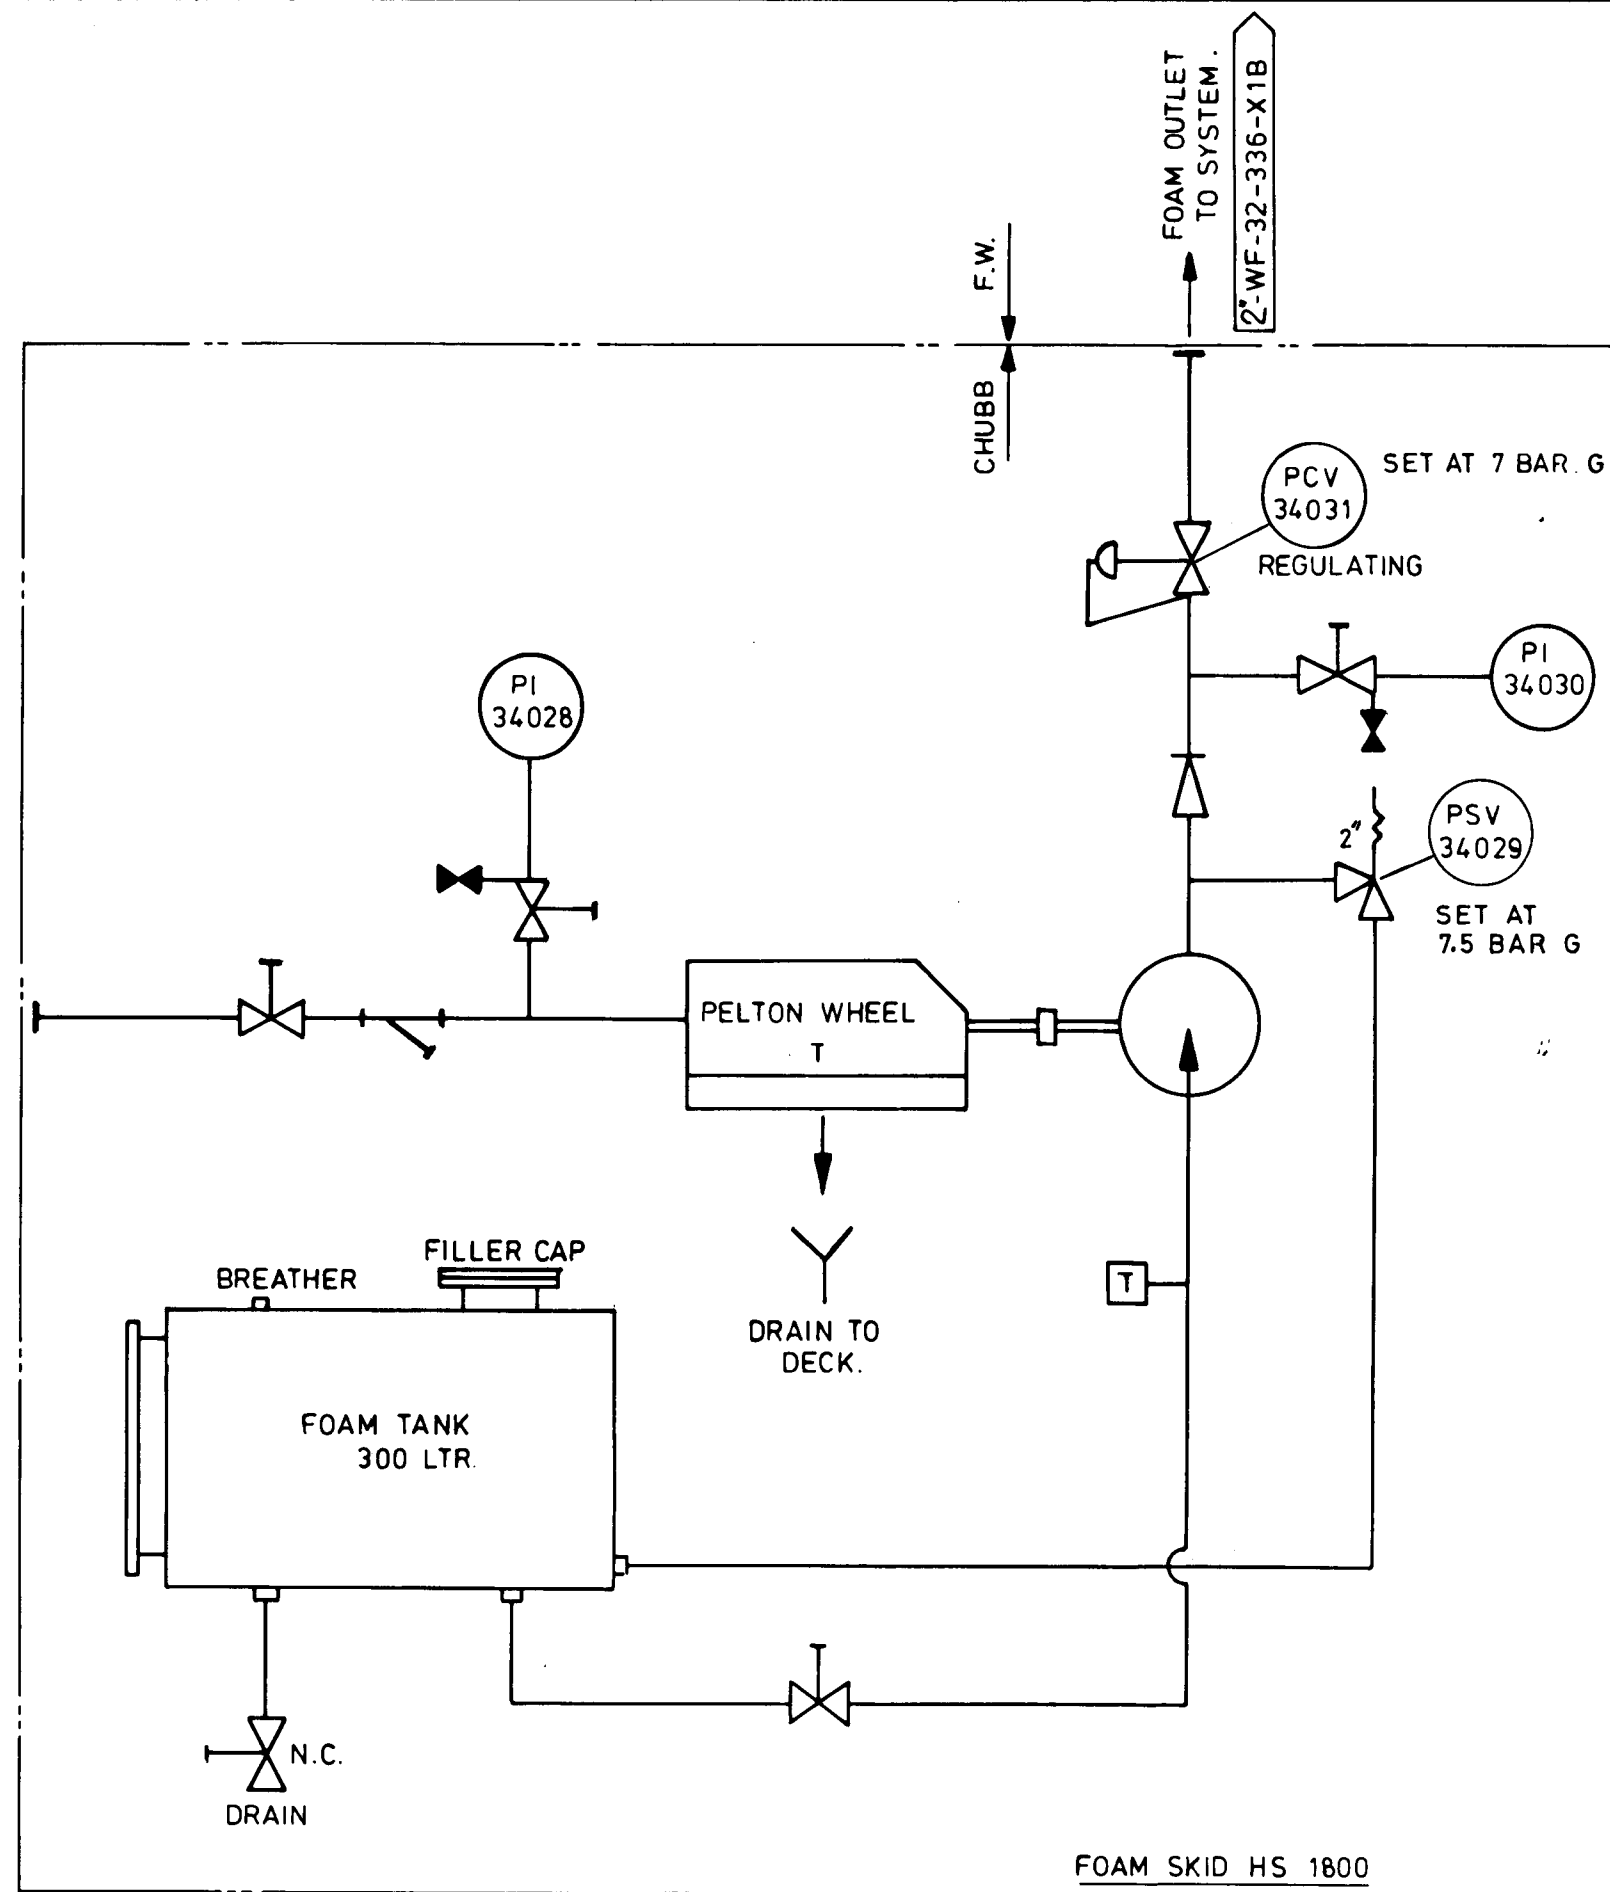


DRG. No. 12259-K-04

A2

**CHUBB FIRE ENGINEERING.**Lancaster Road, Cressex Industrial Estate,  
High Wycombe, Bucks. HP12 3QF, England.  
Tel: (0494) 441114 Telex: 83560 CNF Fax: (0494) 31710CHUBB FIRE ENGINEERING OWNS THE  
COPYRIGHT OF THIS DRAWING WHICH IS  
SUPPLIED IN CONFIDENCE AND WHICH MUST  
NOT BE USED FOR ANY PURPOSE OTHER  
THAN THAT FOR WHICH IT IS SUPPLIED AND  
MUST NOT BE REPRODUCED WITHOUT  
PERMISSION IN WRITING FROM THE OWNERS.FIRST YEAR OF  
PUBLICATION  
19THIRD ANGLE  
PROJECTIONSEAWATER INLET  
TO PELTON WHEEL.

2" WF-32-132-X1B

**AMERADA HESS LIMITED**  
Scott Field Development**RETURN CODE 8****THIS DOCUMENT HAS  
BEEN ACCEPTED BY  
COMPANY AS  
"AS SUPPLIED"  
WITHOUT ENGINEERING  
REVIEW****AS SUPPLIED**

Seller shall complete both Sections A &amp; B, sign &amp; date

**A** All Company comments on previous submission  
have been fully incorporated  
☒ Yes ☐ No ☐ Not Applicable**B** There are no design changes, other than  
incorporation of Company comments, from  
previous submission  
☒ Yes ☐ NoSeller's Verifying Statement:  
This document accurately represents the "As Supplied"  
condition of the WorkSellers Authorised Signature: *B. W. S. [Signature]* Date: 10-6-92**COMPANY RETURN CODES**

- ☐ 1. Accepted "As Supplied"
- ☐ 2. Accepted - No Comments
- ☐ 3. Qualified Acceptance - Minor Comments.  
Revise & Resubmit as "As Supplied"  
Work May Proceed
- ☐ 4. Qualified Acceptance - Minor Comments.  
Revise & Resubmit To Obtain Code 2  
Work May Proceed
- ☐ 5. Qualified Acceptance - Major Comments.  
Revise & Resubmit To Obtain Code 2  
Work May Proceed
- ☐ 6. Rejected - Revise & Resubmit Immediately  
Work May Not Proceed In The Affected  
Area
- ☐ 7. Review Not Required

Company's  
Signature: ..... Date: .....**AMERADA HESS LIMITED****SCOTT FIELD DEVELOPMENT**

Package Desc	FOAM SKID		
Equip Nos	LF-3402.C.		
SDRS Codes	D01		
Module	L160	Sheet	1 of 1
Purchase Order No	20130	Document No	01010403

REVISES DETAILS, SIGNATURE/DATE	ISS No.	DATE	BY	REASON
INITIAL ISSUE	1	14-12-90		
DRG. NO. 12259-K-04	2	20-1-91		
CLIENT COMMENTS INCORPORATED N.J. 20-1-91 (B) VAN. 91.	3	AS SUPPLIED 6-1-92		

SITE

SCOTT FIELD  
DEVELOPMENT

CLIENT

AMERADA HESS LIMITED

SO. No. 12259

MATERIAL

FINISH

TITLE

P&I. DIAGRAM FOR FOAM SKID (H.S.1800)  
EQUIPMENT N° LF-3402 C.ALL DIMENSIONS IN MM/METRES. M/C FINISH ✓ UM  
REMOVE ALL BURRS AND SHARP EDGES GEN. TOL. ± 0.4 MM

SCALE: N.T.S. DRAWN N.J. 13-12-90

ENGR. TRACED

APPVD. [Signature] CHKD. [Signature] DEC 90

USED ON PRODUCT

DRG. No. 12259-K-04

A2

ISSUE 1/2/3