


PACKAGE: X-5201 WATER INJECTION
BIOCIDE (DE-AERATOR) PUMP
P-5227 - 1.5kW

CONTINUED ON DRG. No. 440010/325

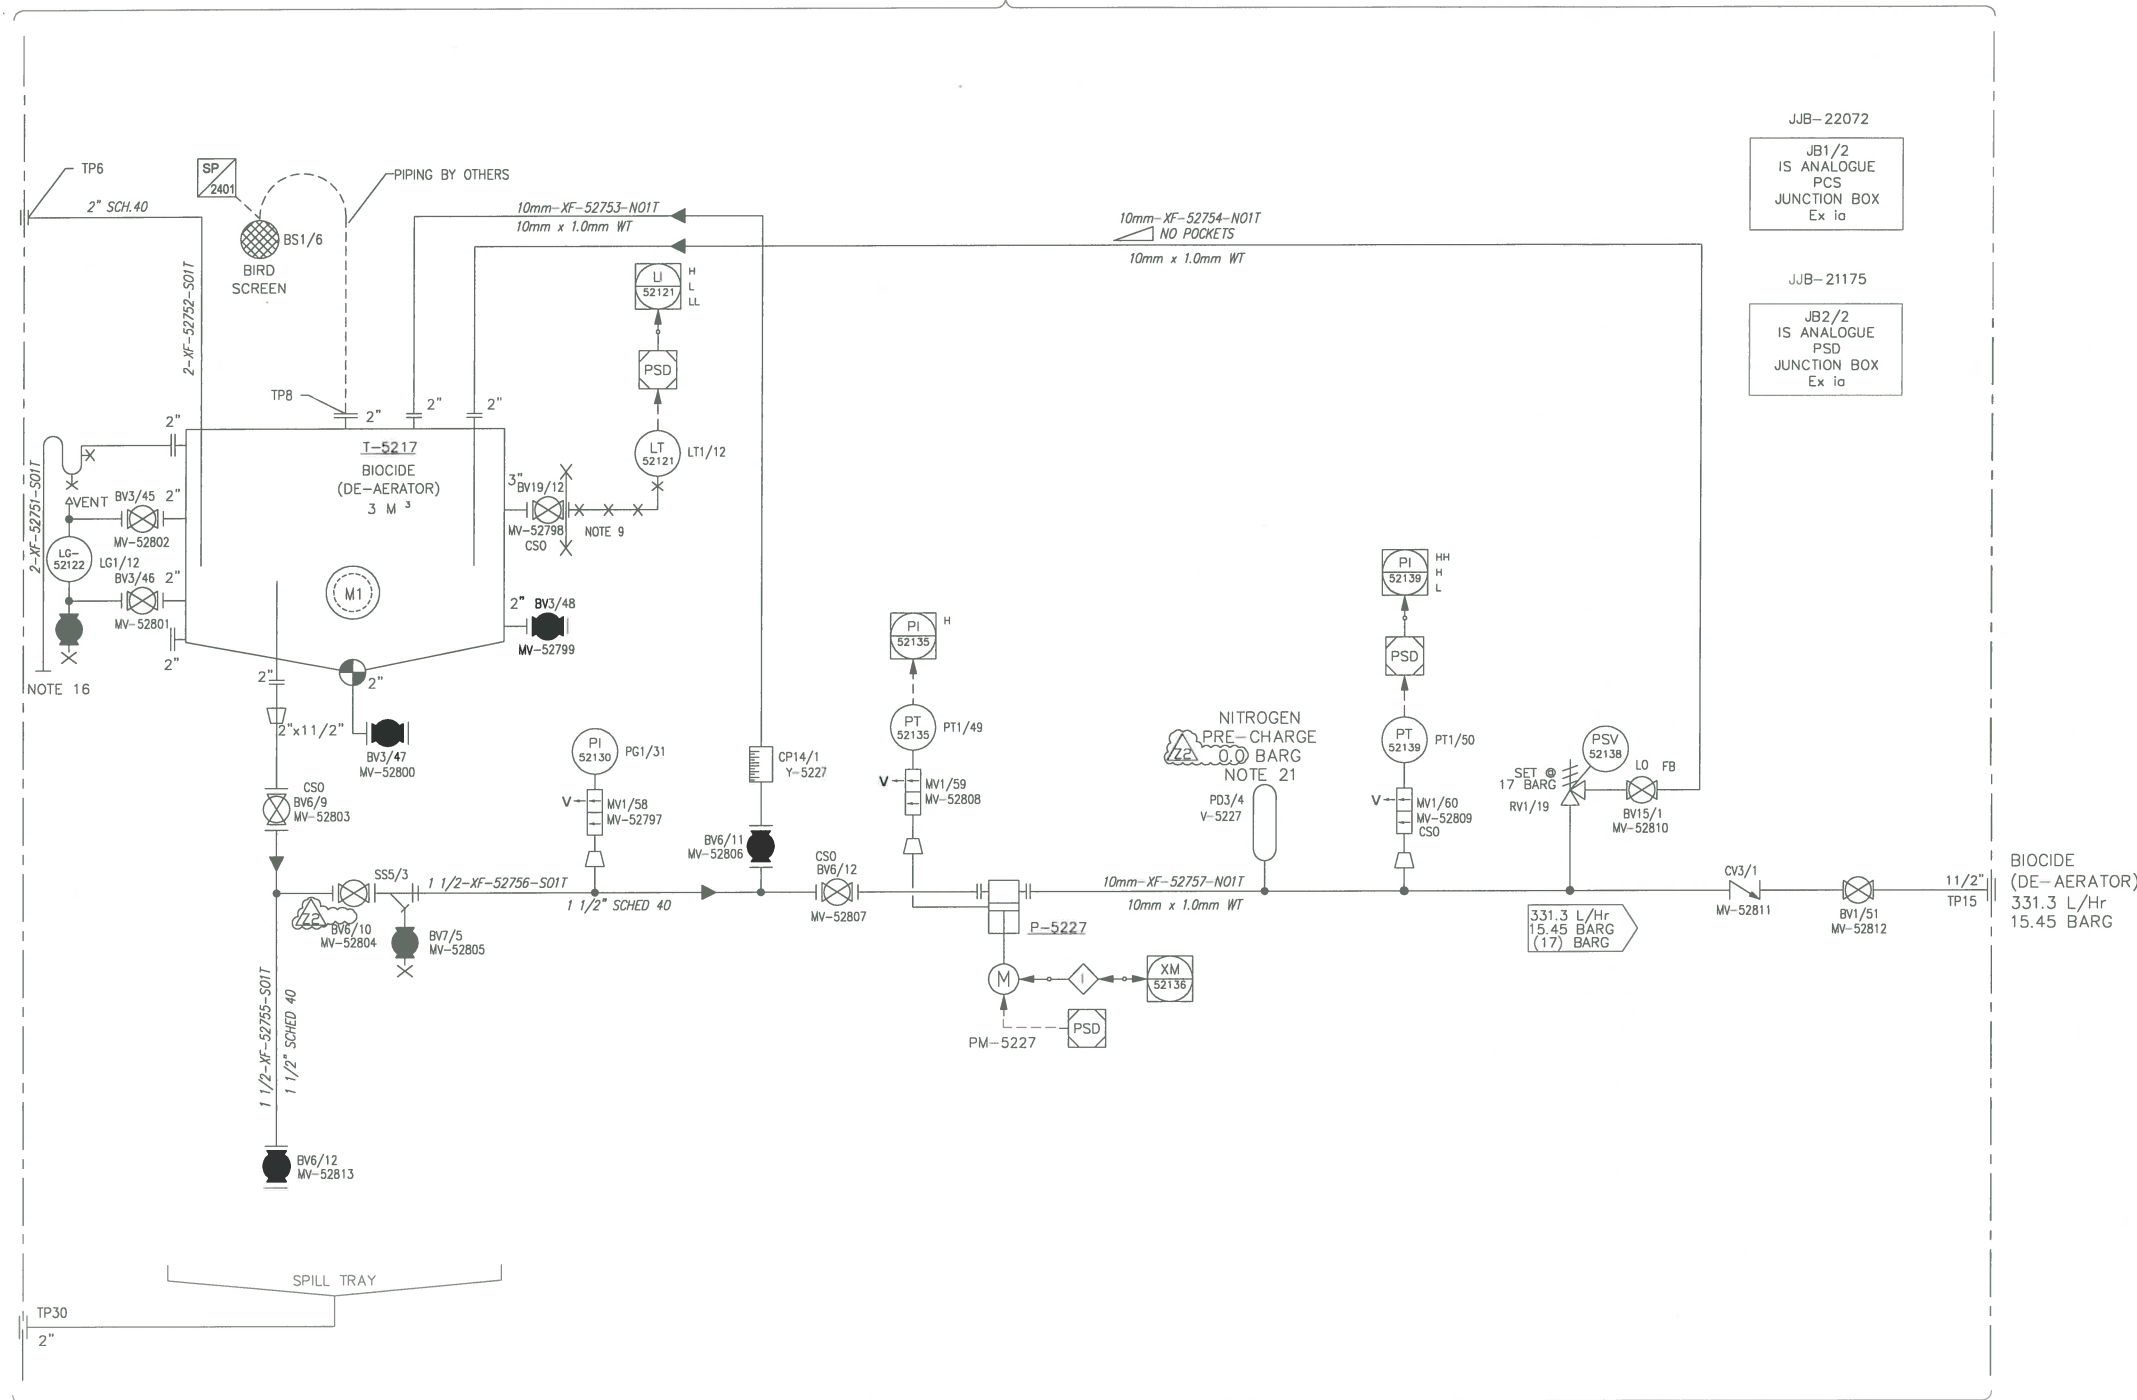

CONTINUED ON DRG. No. 440010/327

1. SYMBOLOGY IN ACCORDANCE WITH LEGEND SHEETS 168397-100-PR-PI-0001 01, 0002-01, 0003-1 AND 0004-1.
2. ALL PIPE TO BE SEAMLESS 316LSS. ALL TUBING TO BE HASTELLOY C276 ASTM B6-22.
3. TUBE FITTINGS TO BE TWIN FERRULE COMPRESSION TYPE 'A-LOK', HASTELLOY C276.
4. THREAD SEALANT : SWAK.
5. FLUID : BIOCIDE (DE-AERATOR).
6. ALL PRESSURES ARE OPERATING.
7. ALL PUMPS TO BE FITTED WITH MANUAL STROKE ADJUSTMENT FROM 0-100% OF DOSING RATE.
8. ALL DRAIN NOZZLES TO BE LOCATED FLUSH WITH TANK/VESSEL BOTTOM TO ENABLE COMPLETE EMPTYING OF TANK.
9. DP CONNECTION 3" WITH CAPILLARY CHEMICAL SEAL SENSING LEVEL AT PUMP SUCTION AND FLUSHING RING. C/W PLUGGED VENT & DRAIN.
10. ALL TRANSMITTERS TO HAVE LOCAL READOUT.
11. BIRD SCREEN TO BE SUPPLIED LOOSE FOR LOCATION IN PURCHASER PIPING.
12. ALL VENTS AND BLEEDS MUST BE FITTED WITH PLUGS.
13. INLET TO PSV TO RISE CONTINUOUSLY WITH NO POCKETS. OUTLET FROM PSV TO FALL CONTINUOUSLY TO TANK.
14. BIRD SCREEN PIPING BY OTHERS.
15. PUMP INTERNAL RELIEF VALVES SET AT 19 BARG.
16. OVERFLOW DIRECTED TO SPILL TRAY.
17. PUMP SUCTION AND DISCHARGE 1/2" ANSI 150 RF.
18. ALL 10mm TUBING AND FITTINGS TO BE FLAME RED (RAL 3000) & FITTED WITH PERMANENT WARNING LABELS.
19. ALL CSO (CAR SEAL OPEN) AND CSC (CAR SEAL CLOSED) VALVES LOCKING MECHANISM IS TO BE SUPPLIED BY OTHERS.
20. TANK OPERATING & ALARM LEVELS RELATIVE TO TANK DRAIN VALVE (SHOWN AS DATUM POINT).
LL: 793mm L: 1000mm H: 2850mm BRIM: 3000mm.
21. PULSATION DAMPER PRESSURE BASED ON OPERATIONAL EXPERIENCE.

X-5201 TIE-IN SCHEDULE

TIE-IN No	TANK No	SIZE	RATING	FLANGE	SERVICE
TP6	-	2"	150#	RF	DECANTING PLATFORM INLET
TP8	-	2"	150#	RF	BIOCIDE (DE-AERATOR) VENT
TP15	-	1 1/2"	150#	RF	BIOCIDE (DE-AERATOR) OUTLET
TP30	-	2"	150#	RF	SPILL TRAY

BIOCIDE (DE-AERATOR)
331.3 L/Hr
15.45 BARG

Nexen Petroleum (U.K.) Limited					
VENDOR : TYCO (AS-BUILT BY AMEC FW)					
EQUIPMENT TITLE : CHEMICAL INJECTION PACKAGE (WATER INJECTION) - BIOCID (DE-AERATOR)					
EQUIPMENT TAG NO(S) : X-5201					
Vendor Document Number					
Purchase Order Number	Doc Type Code	Seq. No	Rev.	DATE	
168397-100-PO-3366	MC2	016	Z2	30/05/11	
SUPPLIER DOCUMENT REVIEW					
Rejected (Assai Code - REJ) - Quality and content is out of conformity with Company requirements. Document shall be revised by Supplier to incorporate the necessary changes and subsequently re-submitted.					
Accepted With Comments (Assai Code - AWC) - Generally acceptable but elements require to be addressed. Document shall be revised by Supplier to incorporate the necessary changes and subsequently re-submitted.					
Accepted As Final (Assai Code - FIN) - Documents are considered acceptable, do not re-submit.					
Accepted For Information (Assai Code - AFI) - No further action required, do not re-submit.					
Review of Vendor documents does not relieve Vendor of the responsibility for correctness under the Purchase Order. Permission to proceed does not constitute acceptance of design, detail and calculations, test methods or materials developed or selected by the Vendor and does not relieve the Vendor from full compliance with the Purchase Order or any other obligations, not detract from any of the Purchaser's rights.					
Z2	30/05/11	AS BUILT AS PER GIC0036 & GIC0038		Wm B A M	
REV	DATE	DESCRIPTION		DRN	CHK APP CL

--	--	