


CY-1101A
LP/IP COMPRESSOR PACKAGE

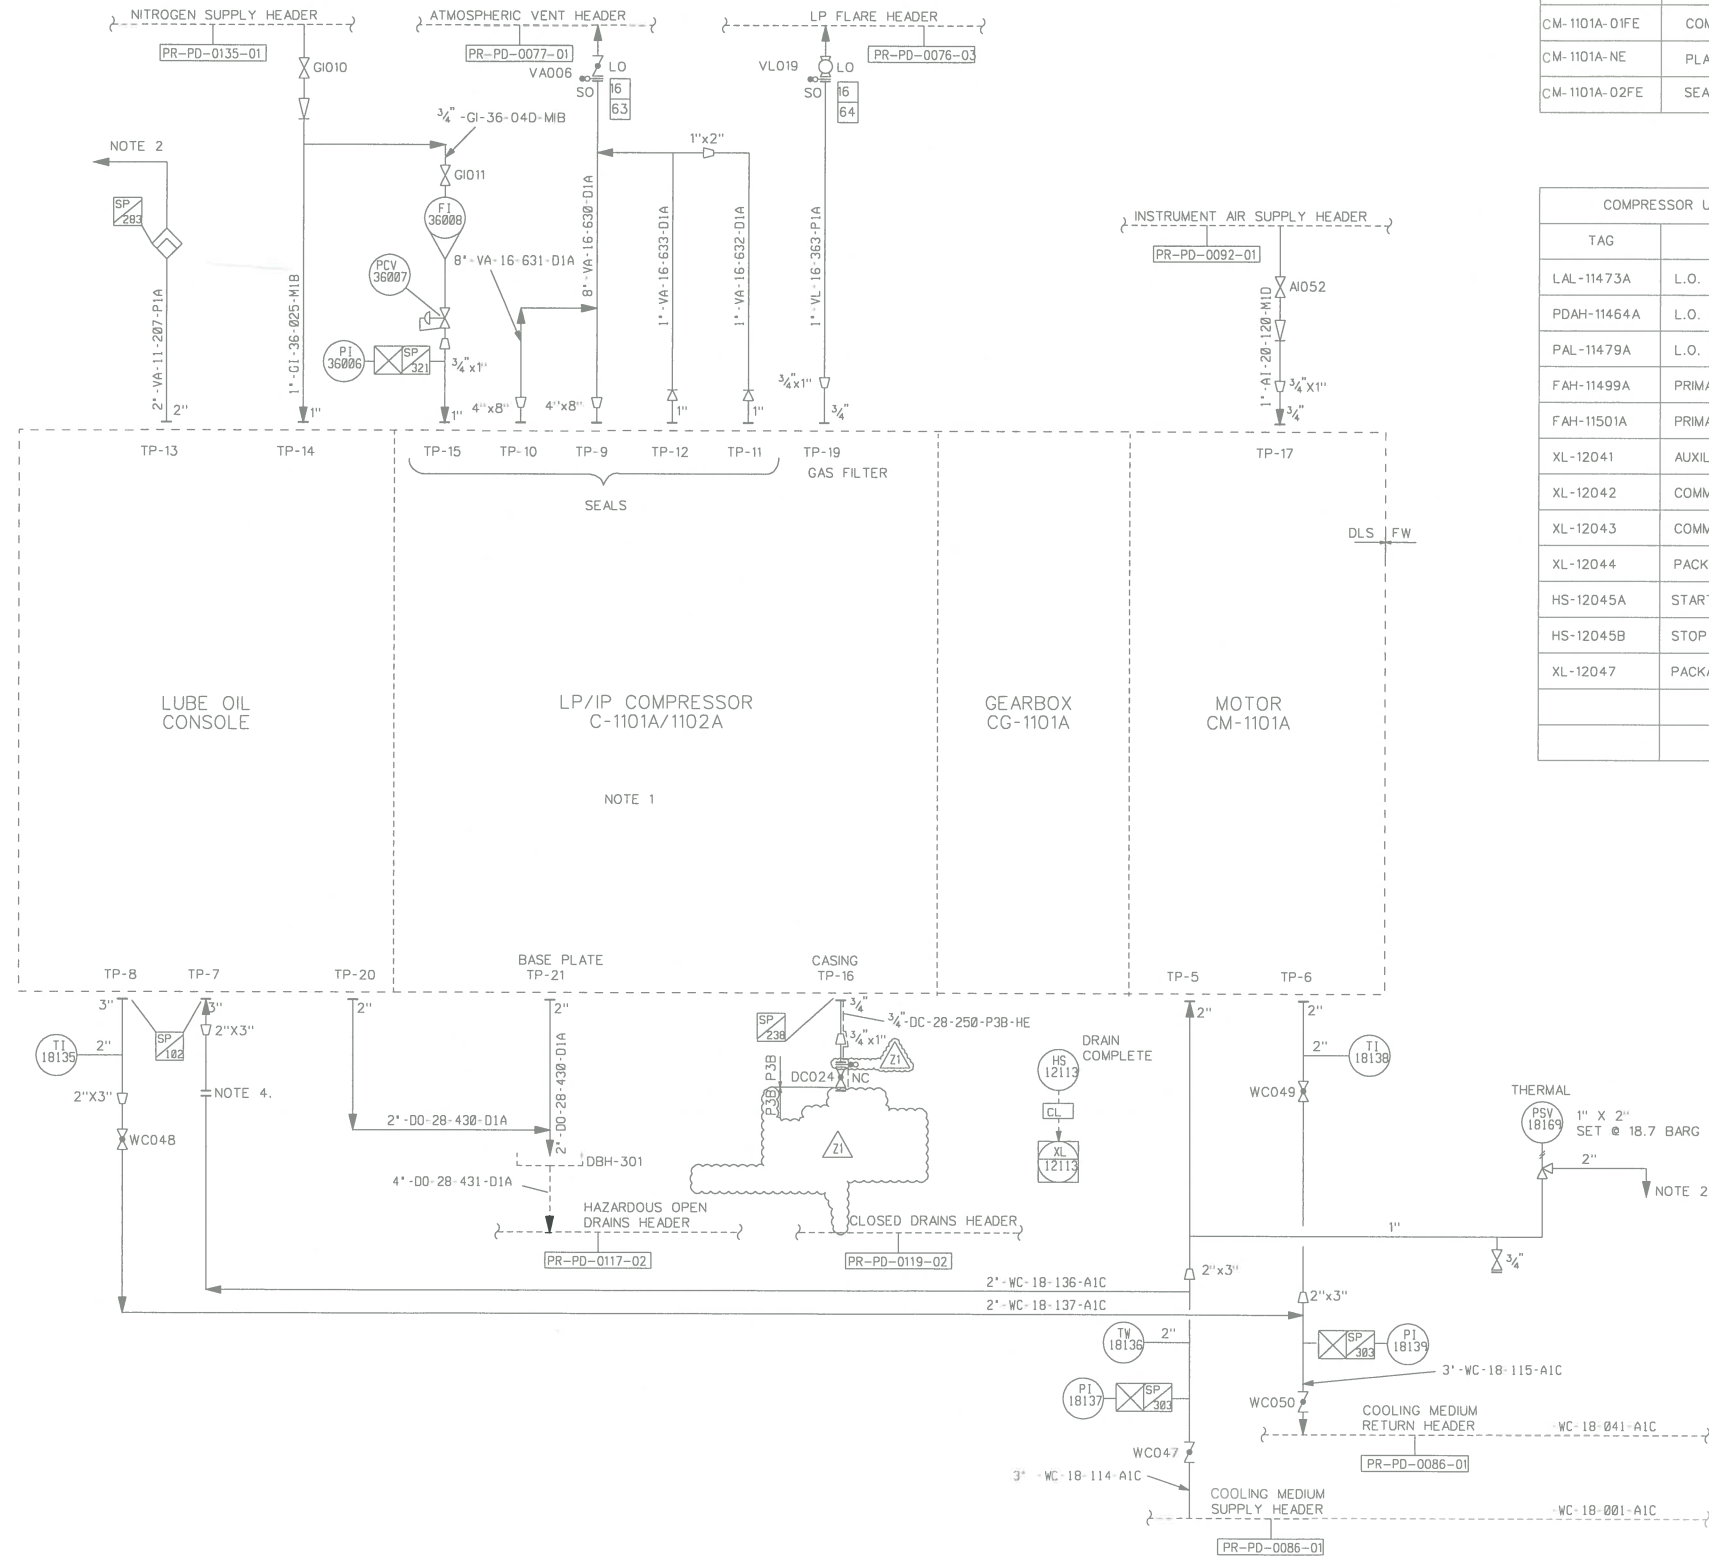

COMPRESSOR UCP SIGNALS TO/FROM ESD	
TAG	DESCRIPTION
CM-1101A-01FE	COMPRESSOR MACHINERY PROTECTION
CM-1101A-NE	PLATFORM E.S.D.
CM-1101A-02FE	SEAL FAILURE

COMPRESSOR UCP SIGNALS TO/FROM DCS	
TAG	DESCRIPTION
LAL-11473A	L.O. RESERVOIR
PD4H-11464A	L.O. FILTER
PAL-11479A	L.O. HEADER
FAH-11499A	PRIMARY SEAL FAILURE D.E.
FAH-11501A	PRIMARY SEAL FAILURE N.D.E.
XL-12041	AUXILIARIES RUNNING
XL-12042	COMMON FAULT ALARM
XL-12043	COMMON TRIP ALARM
XL-12044	PACKAGE AVAILABLE
HS-12045A	START AUXILIARIES
HS-12045B	STOP AUXILIARIES
XL-12047	PACKAGE/DCS START OF AUXILIARIES

NOTES

1. FOR DETAILS SEE DELAVAL STORK SCHEMATIC P-0002-D-1002 & 1007.
2. VENT AT SAFE LOCATION.
3. SG IN VIEW FROM DRAIN VALVE.
4. BREAK FLANGES FOR MAINTENANCE.

ONLY ACTIVATED TRACE HEATING IS SHOWN ON P & ID, ALL OTHER INSTALLED TRACE HEATING IS NOT ACTIVATED AND NOT SHOWN ON P & ID.

FOR APPROVAL SIGNATURES SEE ARCHIVED DRAWING AT REV 0

REFERENCE DRAWINGS		TITLE		DATE		BY		CHKD.		ENG.		APP'D.		NEXEN	
DRG.No.	REV	DCP5000-297	ARN2088 (EP191)	13	AS-BUILT TO REFLECT SEQ-1080	12-12-03	AF	BH	BH	MS	10-02-04			1	REVISED FOR CONSTRUCTION
		DCP5000-729	ARN3866 (EPJ128)	12	AS-BUILT TO INCLUDE DO-254	22-06-95	WN	GWM						0	APPROVED FOR CONSTRUCTION
		DCP5000-AH 1054		11	AS COMMISSIONED	03-05-94	CW	RM		KJH				DD	APPROVED FOR FINAL DESIGN
				4	REVISED TO LATEST INFO.	16-03-93	KM	JS		JS	CTL			CD	APPROVED FOR DESIGN
				3	AS BUILT									B	ISSUED FOR COMPANY REVIEW
				2	REVISED FOR CONSTRUCTION	03-02-92		RT	RT	BAR	CTL			Z1	AS-BUILT FOR SMOC1860
				REV	REASON FOR ISSUE	DATE	DRN.	CKD.	BY	ENG.	APP'D.	ENG.	APP'D.	REV	REASON FOR ISSUE

09-10-91	DB														
07-06-91	-	GC	RT	JS	BAR	CTL									
12-03-91	GM	GC	RT	JS	BAR	CTL									
02-01-91	GP	GC	PDA	JS	BAR										
16-10-90	GM	GC	PDA	JS											

nexen
Nexen Petroleum U.K. Limited
Scott House,
Hareness Road, Altness,
Aberdeen AB12 3LE
Tel: (01224) 351100
Fax: (01224) 351101

THIS IS A C.A.D. PRODUCED
DRAWING AND SHOULD NOT
BE MANUALLY MODIFIED

SCOTT	amec foster wheeler	TITLE	SCOTT-FW-0000-PR-PD-0166-01	Z1	NONE
		PIPING AND INSTRUMENT DIAGRAM AUXILIARY CONNECTIONS LP/IP COMPRESSOR TRAIN A			
		DRAWING No.			
		PROJECT	ORIG	AREA/MOD	DISC
		TYPE	SEQ. No.	SHT.	REV
		SCALE			