

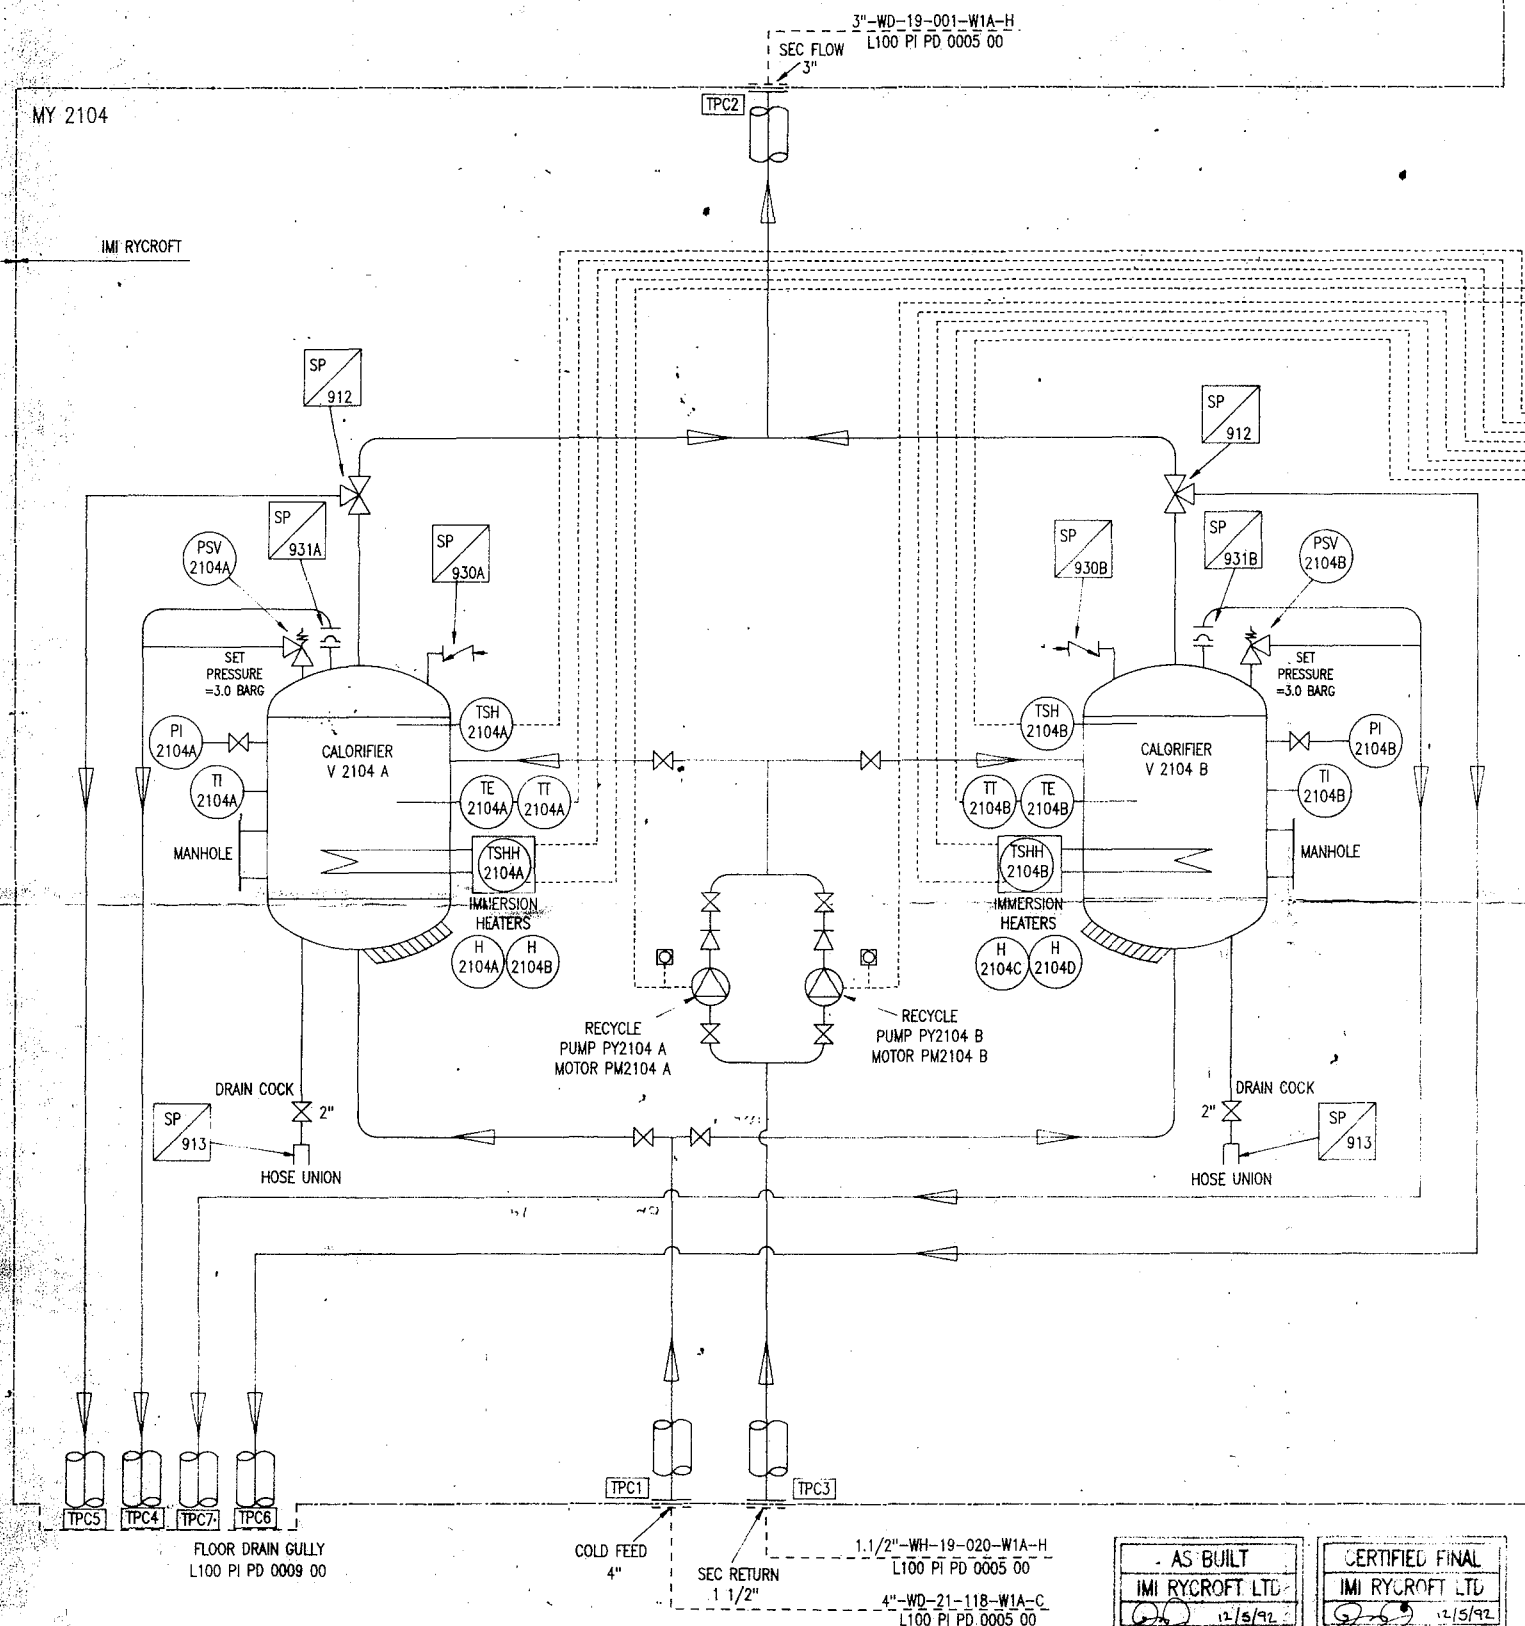
ITEM	DESCRIPTION	SIZE	DUTY
------	-------------	------	------

V 2104 A
CALORIFIER A
5.0 m3

PY 2104 A
RECIRC PUMP A
1 1/4" N.B.
0.5 L/S

PY 2104 B
RECIRC PUMP B
1 1/4" N.B.
0.5 L/S


V 2104 B
CALORIFIER B
5.0 m3



LOCAL CONTROL PANEL

- PUMP A

PUMP B

 

 
 











 

 
 

 
 SELECT SWITCH SELECT SWITCH

 

 



 




 


 
 

 
 


START STOP STOP IND

RUNNING IND AVAILABLE IND FAULT IND

CALORIFIER/HEATER A

CALORIFIER, HEATER B

		
TEMP CONTROLLER	TEMP LOW IND	TEMP NORM IND
		
EARTH LEAK. TRIP	EARTH LEAK. TRIP IND	TEMP HIGH IND
		
HTR TRIP IND	HIGH HIGH TEMP IND	SELECT SWITCH
		
STAGE 1 ON IND	STAGE 1 TEST	CALORIFIER ON IND
		
STAGE 2 ON IND	STAGE 2 TEST	CALORIFIER OFF IND
		
STAGE 3 ON IND	STAGE 3 TEST	CALORIFIER START
		
STAGE 4 ON IND	STAGE 4 TEST	CALORIFIER STOP

		
TEMP CONTROLLER	TEMP LOW IND	TEMP NORM IND
		
EARTH LEAK. TRIP	EARTH LEAK. TRIP IND	TEMP HIGH IND
		
HTR TRIP IND	HIGH HIGH TEMP IND	SELECT SWITCH
		
STAGE 1 ON IND	STAGE 1 TEST	CALORIFER ON IND
		
STAGE 2 ON IND	STAGE 2 TEST	CALORIFER OFF IND
		
STAGE 3 ON IND	STAGE 3 TEST	CALORIFER START
		
STAGE 4 ON IND	STAGE 4 TEST	CALORIFER STOP

KEY

3 WAY GLAND COCK

ANTI-VAC VALVE

SAFETY RELIEF VALVE

BURSTING DISC.

HIGH TEMP THERMOSTAT

HIGH HIGH TEMP THERMOSTAT

ISOLATING VALVE

NON RETURN VALVE

PUMP EMERGENCY STOP


PRESSURE INDICATOR

TEMPERATURE INDICATOR

TEMPERATURE ELEMENT &

AS SUPPLIED

Sellers Statement :
This document accurately
represents the as supplied
condition of the work.

Seller's Authorised Signature :	Date :
	12/5/

VERIFIED TRUE
COPY OF ORIGINAL
JIM RYCROFT LTD

More 10/24/20

<div style="display: flex; justify-content: space-between;"> <div> <input checked="" type="checkbox"/> 1 <input type="checkbox"/> 2 <input type="checkbox"/> 3 <input type="checkbox"/> 4 <input type="checkbox"/> 5 <input type="checkbox"/> 6 <input type="checkbox"/> 7 <input type="checkbox"/> 8 <input type="checkbox"/> 9 <input type="checkbox"/> 10 </div> <div> <u>PURCHASE RETURN CODES</u> 1 ACCEPTED - NO SUPPLY 2 ACCEPTED - NO COMMENTS 3 QUALIFIED ACCEPTANCE - MINOR COMMENTS 4 QUALIFIED ACCEPTANCE - NO COMMENTS 5 REJECT AND RESUBMIT - NO SUPPLY 6 REJECT AND RESUBMIT - NO SUPPLY 7 REJECT AND RESUBMIT - NO SUPPLY 8 REJECT AND RESUBMIT - NO SUPPLY 9 REJECT AND RESUBMIT - NO SUPPLY 10 REJECT AND RESUBMIT - NO SUPPLY </div> </div>	<div style="display: flex; justify-content: space-between;"> <div> AMERADA HESS LIMITED SCOTT FIELD DEVELOPMENT </div> <div> PACKAGE DESC. </div> </div>
<div style="display: flex; justify-content: space-between;"> <div> <input type="checkbox"/> 11 <input type="checkbox"/> 12 <input type="checkbox"/> 13 <input type="checkbox"/> 14 <input type="checkbox"/> 15 <input type="checkbox"/> 16 <input type="checkbox"/> 17 <input type="checkbox"/> 18 <input type="checkbox"/> 19 <input type="checkbox"/> 20 </div> <div> 11 REJECT AND RESUBMIT - NO SUPPLY 12 REJECT AND RESUBMIT - NO SUPPLY 13 REJECT AND RESUBMIT - NO SUPPLY 14 REJECT AND RESUBMIT - NO SUPPLY 15 REJECT AND RESUBMIT - NO SUPPLY 16 REJECT AND RESUBMIT - NO SUPPLY 17 REJECT AND RESUBMIT - NO SUPPLY 18 REJECT AND RESUBMIT - NO SUPPLY 19 REJECT AND RESUBMIT - NO SUPPLY 20 REJECT AND RESUBMIT - NO SUPPLY </div> </div>	<div style="display: flex; justify-content: space-between;"> <div> HWS CALORIFER PACKAGE EQUIP. NO. 5 CODE CODES D01 </div> <div> MY 2104 </div> </div>
<div style="display: flex; justify-content: space-between;"> <div> <input type="checkbox"/> 21 <input type="checkbox"/> 22 <input type="checkbox"/> 23 <input type="checkbox"/> 24 <input type="checkbox"/> 25 <input type="checkbox"/> 26 <input type="checkbox"/> 27 <input type="checkbox"/> 28 <input type="checkbox"/> 29 <input type="checkbox"/> 30 </div> <div> 21 REJECT AND RESUBMIT - NO SUPPLY 22 REJECT AND RESUBMIT - NO SUPPLY 23 REJECT AND RESUBMIT - NO SUPPLY 24 REJECT AND RESUBMIT - NO SUPPLY 25 REJECT AND RESUBMIT - NO SUPPLY 26 REJECT AND RESUBMIT - NO SUPPLY 27 REJECT AND RESUBMIT - NO SUPPLY 28 REJECT AND RESUBMIT - NO SUPPLY 29 REJECT AND RESUBMIT - NO SUPPLY 30 REJECT AND RESUBMIT - NO SUPPLY </div> </div>	<div style="display: flex; justify-content: space-between;"> <div> MODULE ACCOMMODATION L1 SHEET 1 OF 1 </div> </div>
<div style="display: flex; justify-content: space-between;"> <div> <input type="checkbox"/> 31 <input type="checkbox"/> 32 <input type="checkbox"/> 33 <input type="checkbox"/> 34 <input type="checkbox"/> 35 <input type="checkbox"/> 36 <input type="checkbox"/> 37 <input type="checkbox"/> 38 <input type="checkbox"/> 39 <input type="checkbox"/> 40 </div> <div> 31 REJECT AND RESUBMIT - NO SUPPLY 32 REJECT AND RESUBMIT - NO SUPPLY 33 REJECT AND RESUBMIT - NO SUPPLY 34 REJECT AND RESUBMIT - NO SUPPLY 35 REJECT AND RESUBMIT - NO SUPPLY 36 REJECT AND RESUBMIT - NO SUPPLY 37 REJECT AND RESUBMIT - NO SUPPLY 38 REJECT AND RESUBMIT - NO SUPPLY 39 REJECT AND RESUBMIT - NO SUPPLY 40 REJECT AND RESUBMIT - NO SUPPLY </div> </div>	<div style="display: flex; justify-content: space-between;"> <div> DOCUMENT NO. PURCHASE ORDER NO. PRIME COST SEQUENCE IN </div> <div> RE </div> </div>
<div style="display: flex; justify-content: space-between;"> <div> PURCHASER'S SIGNATURE DATE </div> <div> 14/5/92 </div> </div>	<div style="display: flex; justify-content: space-between;"> <div> P 0 0 4 1 D 0 0 0 1 1 0 </div> </div>

REVISIONS

DATE	SIG.	CHK'D.	DATE	SIG.	CHK'D.	DATE	SIG.	CHK'D.	DATE	SIG.	CHK'D.	DATE	SIG.	CHK'D.
4/1/92	N.DAWSON	CHK'D. <i>R. Jones</i>	28/2/92	N.DAWSON	CHK'D. <i>R. Jones</i>	12/5/92	N.DAWSON	CHK'D. <i>R. Jones</i>						
FOR APPROVAL			REVISED TO CUSTOMER COMMENTS			DRAIN COCK TAG NUMBERS REVISED AS BUILT CERTIFIED FINAL								

CUSTOMER NAME & PO NO.

SLP ENGINEERING LTD

TITLE	AMERALA HESS SCOTT PROJECT CALORIFIER PACKAGE P & ID
-------	--

DRAWN N.DAWSON	DATE 4/1/92	CHECKED <i>L. James</i>	DATE 12/5/92	APPROVED <i>DPI</i> <i>utah</i>	DATE 12/5/92
--------------------------	-----------------------	-----------------------------------	------------------------	---	------------------------

IMI RYCROFT LTD. DUNCOMBE ROAD. BRADFORD BD8 9TB ENGLAND TEL NO. (0274) 490911 TELEX 517101 FAX NO. 0274 498580

IF IN DOUBT ASK
DO NOT SCALE DRAWING

COPYRIGHT
THIS DRAWING AND DESIGN IS THE SOLE PROPERTY OF
IMI RYCROFT LIMITED AND MUST NOT BE LOANED COPIED
OR REPRODUCED WITHOUT THE WRITTEN PERMISSION OF
THE COMPANY

WORKS ORDER NO.	87430	
DRG. NO.	87430/0/108 SHT1 C	SCALE N.T.S.

ALL DIMENSIONS IN MM UNLESS STATED OTHERWISE