


NOTES

- 1 SPRING CLOSED ACTUATED DAMPERS AIR PRESSURE TO SINGLE EFFECT PISTON OPERATES THE DAMPER
- 2 IMPULSE LINE IS EQUIPPED WITH "LOCKED MANIFOLD" HAVING LOCKED OPEN VALVE ON MAIN PORT AND LOCKED CLOSED VALVE BLEED PORT
- 3 TUBING ROUTING INSIDE RIO COMPARTMENT IN PACKAGING CONTRACTOR SCOPE OF SUPPLY
- 4 CUSTOMER TO ADVISE IF FNFV-3 IS NECESSARY
- 5 N/A
- 6 THE F&G SYSTEM WILL TRIP THE FANS UPON GAS DETECTION THE F&G SYSTEM WILL NOT START AND STOP THE FANS
- 7 SEE DETAIL ELECTRIC MOTOR (AC) SIGNALS
- 8 EMERGENCY PUSH BUTTON SUPPLIED LOOSE
- 9 PRESSURE RELIEF DAMPER (LCC) AND GRAVITY DAMPERS (RIO ENCLOSURE) ARE SET TO MAINTAIN A POSITIVE DIFFERENTIAL PRESSURE OF 50 Pa BETWEEN THE COMPARTMENT AND THE EXTERNAL AMBIENT CONDITIONS

CONTROL LOOPS

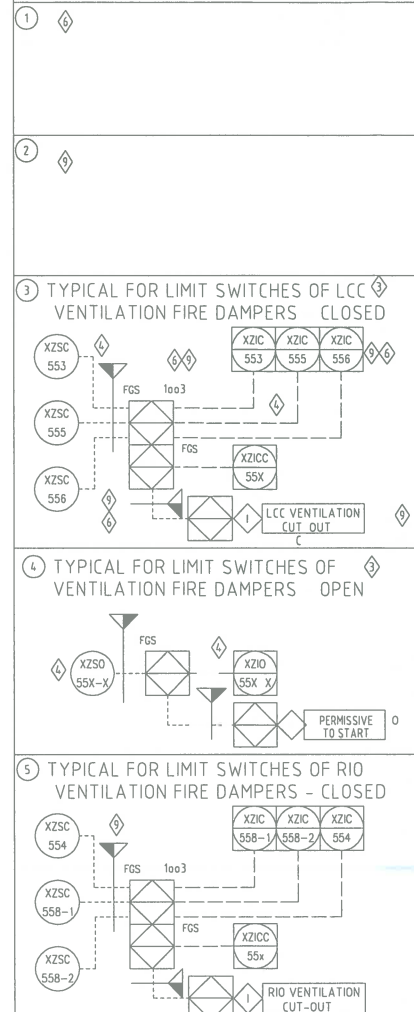

Nexen Petroleum (U.K.) Limited						
VENDOR : GE Nuova Pignone (AMEC FW)						
EQUIPMENT TITLE : PIPING & INSTRUMENT DIAGRAMS						
EQUIPMENT TAG NO(S) : X-7001A/B, X-5701A/B						
Vendor Document Number						
Purchase Order No		Doc Type		Seq. Sheet No	Rev.	DATE
168397 - 200 - PO - 3270 - MC2 - 001 - 17					Z1	29/11/16
SUPPLIER DOCUMENT REVIEW						
Rejected (Assai Code - REJ) - Quality and content is out of conformity with Company requirements. Document shall be revised by Supplier to incorporate the necessary changes and subsequently re-submitted.						
Accepted With Comments (Assai Code - AWC) - Generally acceptable but elements require to be addressed. Document shall be revised by Supplier to incorporate the necessary changes and subsequently re-submitted.						
Accepted As Final (Assai Code - FIN) - Documents are considered acceptable, do not re-submit.						
Accepted For Information (Assai Code - AFI) - No further action required, do not re-submit.						
Review of Vendor documents does not relieve Vendor of the responsibility for correctness under the Purchase Order. Permission to proceed does not constitute acceptance of design, detail and calculations, test methods or materials developed or selected by the Vendor and does not relieve the Vendor from full compliance with the Purchase Order or any other obligations, not detract from any of the Purchaser's rights.						
Z1	26/11/16	AD-HOC AS-BUILT			WAT	ATL
REV	DATE	DESCRIPTION			DRN	CHK APP CLT

EQUIPMENT TAG NUMBERS			
NP TAG n°	DESCRIPTION	CUSTOMER TAG n°	
		X-7001A	X-7001B
FNFV-3	RIO PANEL VENTILATION FAN	B-7081A-03	B-7081B-03
FNFV-4	LCC COMPARTMENT VENTILATION FAN	B-7081A-04	B-7081B-04
FNFV-5	LCC COMPARTMENT VENTILATION FAN	B-7081A-05	B-7081B-05
88BA-3	RIO PANEL VENTILATION FAN MOTOR	BM-7081A-03	BM-7081B-03
88BA-4	LCC COMPARTMENT VENTILATION FAN MOTOR	BM-7081A-04	BM-7081B-04
88BA-5	LCC COMPARTMENT VENTILATION FAN MOTOR	BM-7081A-05	BM-7081B-05

TITLE: LCC and RIO PANEL COMPARTMENT P&ID		DOCUMENT CODE: SOM5081932		REVISION: 11
DIAGRAM		PAGE MARKER: N/A		SECURITY CODE: N
REVISION DESCRIPTION: NO REVISION IS INTRODUCED IN THIS SHEET		ORIGINAL JOB: 1703636-37		LANGUAGE: A
		SIZE: 1		SHEET: 17-04-21