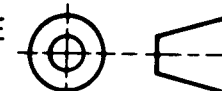
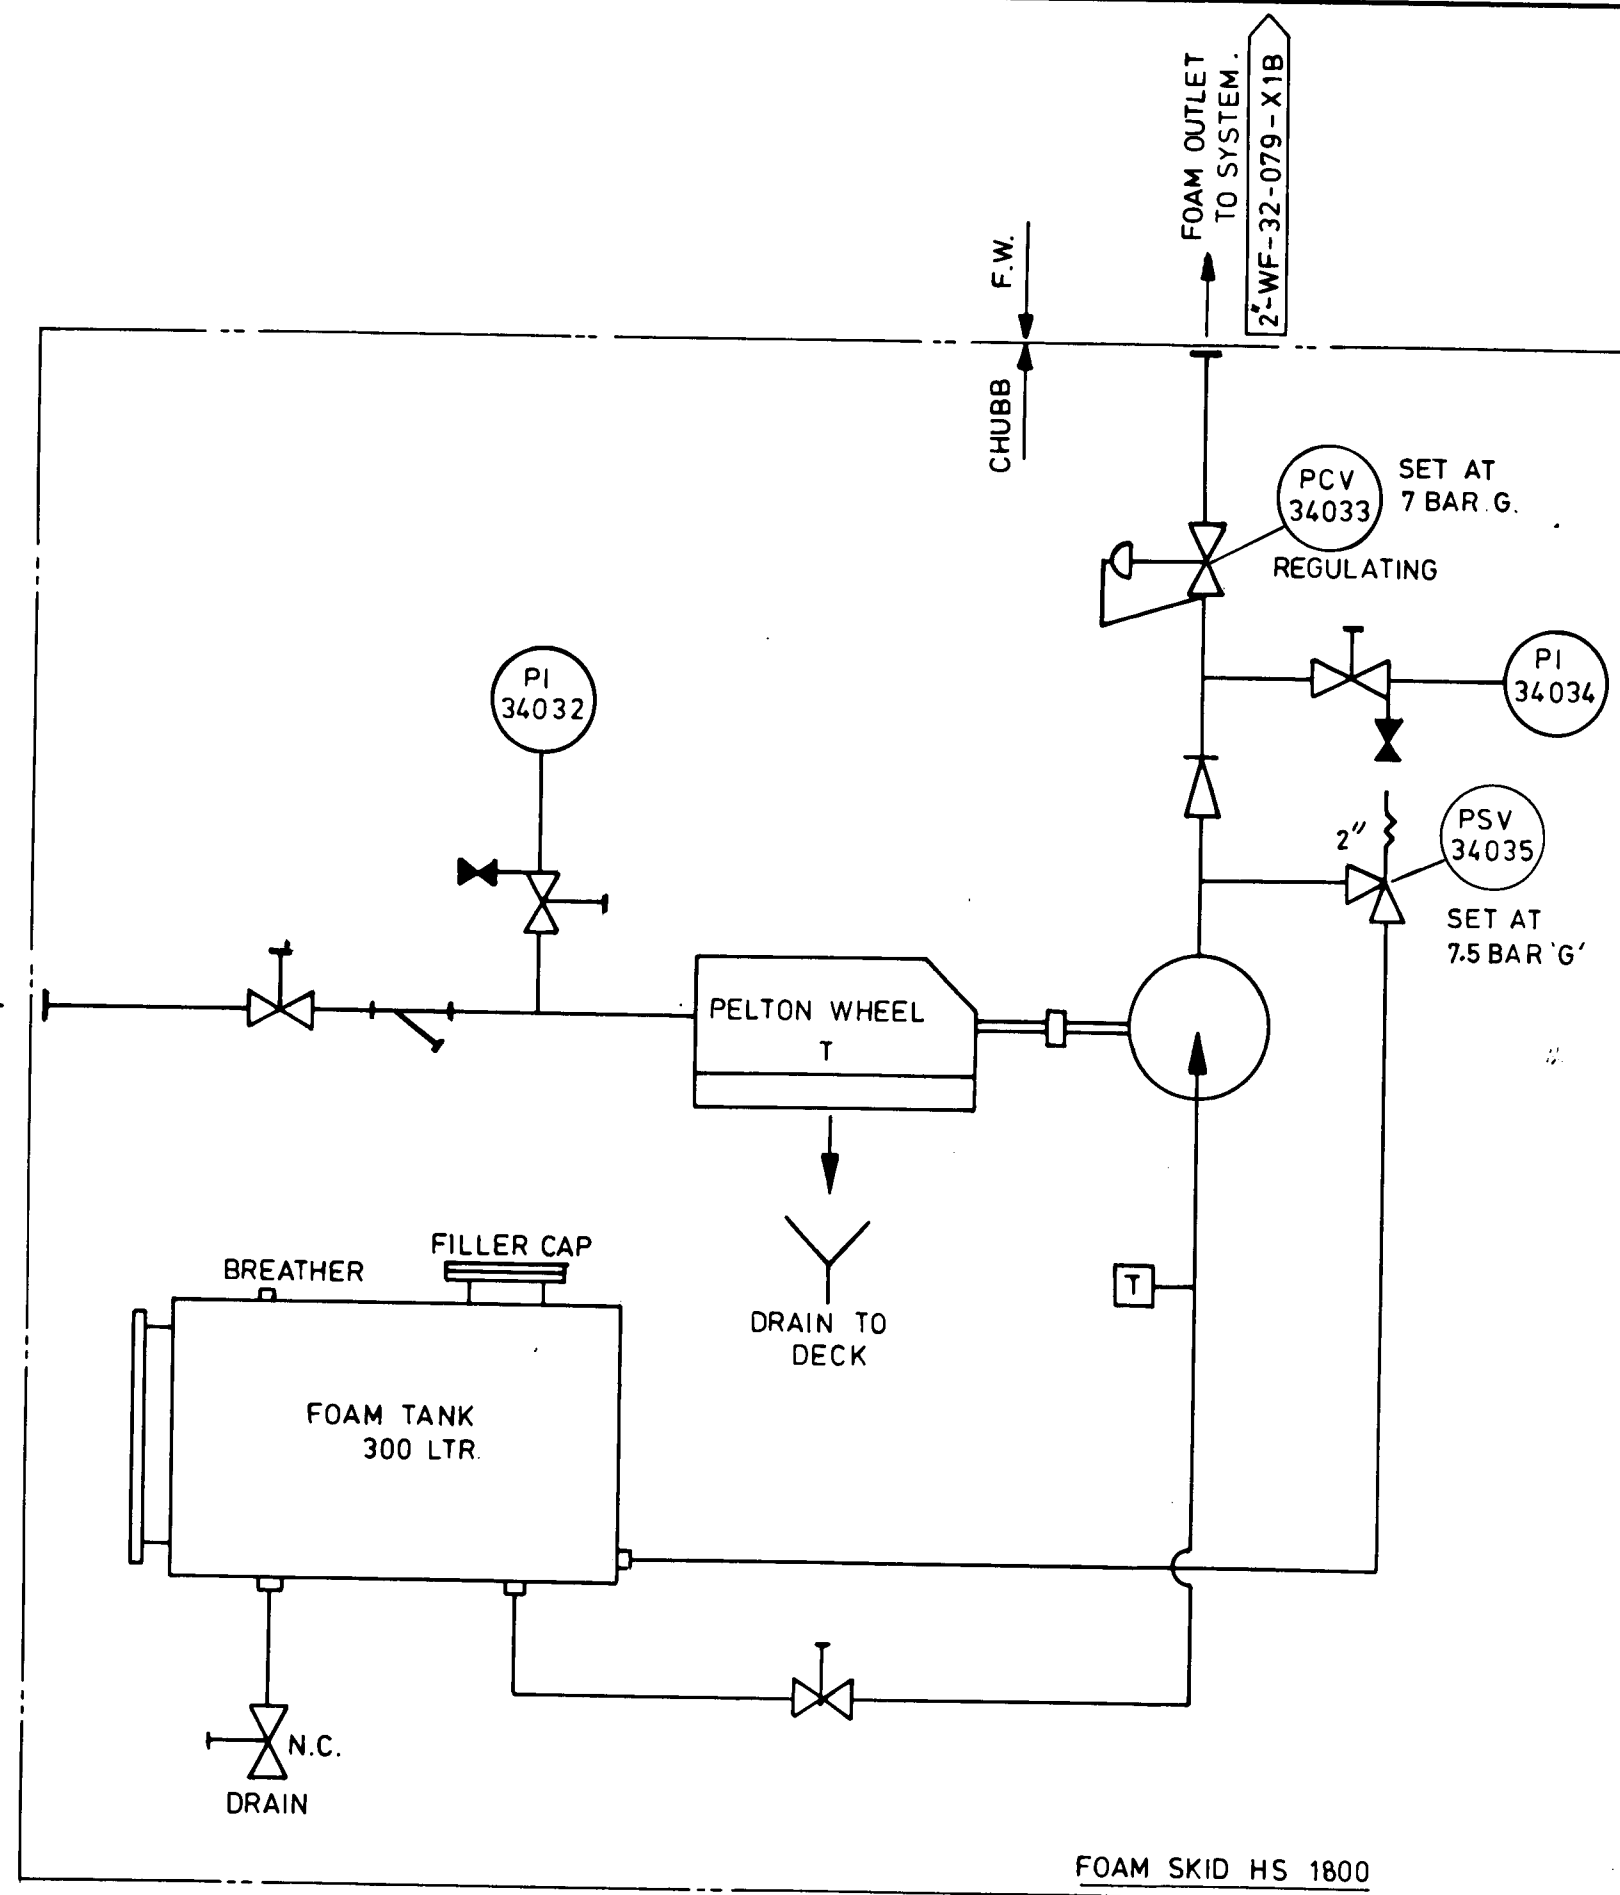


DRG. No. 12259-K-05

A2

**CHUBB FIRE ENGINEERING**Lancaster Road, Cressex Industrial Estate,  
High Wycombe, Bucks. HP12 3QF, England.  
Tel: (0494) 441114 Telex: 83560 CNF Fax: (0494) 31710CHUBB FIRE ENGINEERING OWNS THE  
COPYRIGHT OF THIS DRAWING WHICH IS  
SUPPLIED IN CONFIDENCE AND WHICH MUST  
NOT BE USED FOR ANY PURPOSE OTHER  
THAN THAT FOR WHICH IT IS SUPPLIED AND  
MUST NOT BE REPRODUCED WITHOUT  
PERMISSION IN WRITING FROM THE OWNERS.FIRST YEAR OF  
PUBLICATION  
19THIRD ANGLE  
PROJECTIONSEAWATER INLET  
TO PELTON WHEEL.  
2" WF-32-079-X1BAMERADA HESS LIMITED  
Scott Field Development**RETURN CODE 8**  
**THIS DOCUMENT HAS**  
**BEEN ACCEPTED BY**  
**COMPANY AS**  
**"AS SUPPLIED"**  
**WITHOUT ENGINEERING**  
**REVIEW****AS SUPPLIED**

Seller shall complete both Sections A &amp; B, sign &amp; date

A All Company comments on previous submission  
have been fully incorporated  
☒ Yes ☐ No ☐ Not ApplicableB There are no design changes, other than  
incorporation of Company comments, from  
previous submission  
☒ Yes ☐ NoSeller's Verifying Statement:  
This document accurately represents the "As Supplied"  
condition of the WorkSeller's Authorized Signature: *B. Welford* Date: 10-6-92

## COMPANY RETURN CODES

- ☐
1. Accepted "As Supplied"
- 
- ☐
2. Accepted - No Comments
- 
- ☐
3. Qualified Acceptance - Minor Comments.
- 
- Revise & Resubmit as "As Supplied"
- 
- Work May Proceed
- 
- ☐
4. Qualified Acceptance - Minor Comments.
- 
- Revise & Resubmit To Obtain Code 2
- 
- Work May Proceed
- 
- ☐
5. Qualified Acceptance - Major Comments.
- 
- Revise & Resubmit To Obtain Code 2
- 
- Work May Proceed
- 
- ☐
6. Rejected - Revise & Resubmit Immediately
- 
- Work May Not Proceed In The Affected
- 
- Areas
- 
- ☐
7. Review Not Required

Company's  
Signature: \_\_\_\_\_ Date: \_\_\_\_\_

## AMERADA HESS LIMITED

## SCOTT FIELD DEVELOPMENT

Package Desc	FOAM SKID		
Equip Nos	LF-3403		
SDRS Codes	D01		
Module	L160	Sheet	1 of 1
Purchase Order No	P0130	Document No	D 0100503
Rev			

REV	ISS	DETAILS	SIGNATURE	DATE
1	1	INITIAL ISSUE	14-12-90	
2	2	CLIENT'S COMMENTS INCORPORATED N.J. 25-1-91. FEB 91		
3	3	AS SUPPLIED		
4	4	6-1-92		

SITE

SCOTT FIELD  
DEVELOPMENT

CLIENT

AMERADA HESS LIMITED

SO. No. 12259

MATERIAL

FINISH

TITLE

P&I. DIAGRAM FOR FOAM SKID (H.S.1800)  
EQUIPMENT N° LF-3403ALL DIMENSIONS IN M/METRES. M/C FINISH ☒ uM  
REMOVE ALL BURRS AND SHARP EDGES GEN. TOL.  $\pm 0.4$  MM

SCALE:	N.T.S.	DRAWN	N.J.	13-12-90
ENGR.		TRACED		
APPVD.		CHKD.		
USED ON		PRODUCT		

DRG. No. 12259-K-05

A2

ISSUE 1/23