


NOTE

- 1 TYPICAL FIRE DAMPER CONTROL SCHEMATIC
 OVERRIDE OPEN SIGNAL (ZONE CONTROL) SEE NOTES
 F&G
 TEST
 TSV
 HV
 FOR TAG N°S SEE TABLE BELOW
- 2 ALL FIREDAMPERS TO BE PREFIXED UE 7371
- 3 SHORTENED FORM OF TAGGING ADOPTED TO IMPROVE READABILITY AND LIMIT CONGESTION IN ACCORDANCE TO AHL PROCEDURE E4-06 'ENGINEERING IDENTIFICATION SYSTEM,' PAGE 29, SECTION 13-1
- 4 INDICATES LOGIC INTERLOCK LOCATED MCC IN ELECTRICAL SWITCHGEAR R116
- 5 FOR OVERRIDE SIGNAL ZONE CONTROL SEE DRG. SCOTT-SE-L100-JN-DG-0009-00
- 6 FOR EQUIPMENT TAG N°S REFER TO HVAC DUCTING LAYOUT DIAGRAMS
- 7 FOR FIRE & GAS INTERLOCKS SEE F & G CAUSE & EFFECTS SCOTT-SE-L100-FG-CH-0001 TO 27

TAG NUMBERS						
F/DAMPER	CZ*	XY*	TSV*	HV*	FCV*	ZSL*
FD 701	40311	40311	40311	40311	40311	40311
FD 702	40312	40312	40312	40312	40312	40312
FD 703	40313	40313	40313	40313	40313	40313
FD 704	40314	40314	40314	40314	40314	40314
FD 705	40315	40315	40315	40315	40315	40315
FD 723	40333	40333	40333	40333	40333	40333
FD 769	40379	40379	40379	40379	40379	40379

AMERADA HESS LIMITED
SCOTT FIELD DEVELOPMENT
SITE AS BUILT
CONTRACT C1018

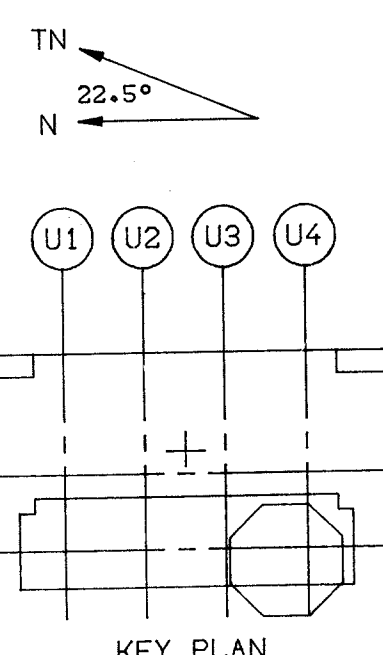

REFERENCE DRAWINGS		TITLE
DRAWING	REV	
SCOTT-SE-L100-FG-CH-0001 & 27		FIRE & GAS CAUSE & EFFECT DIAGS.
SCOTT-SE-L100-HV-SC-0002-00		HVAC DAMPER SCHEDULE
SCOTT-SE-L100-HV-DR-0030 TO 0051		HVAC DUCTING LAYOUT DIAGRAMS
SCOTT-SE-L100-JN-DG-0021-SERIES		HVAC/INST E&I BLOCK DIAGRAMS
SCOTT-SE-L100-JN-CH-0001:00 TO 0010:00		HVAC/INST E&I CAUSE AND EFFECT DIAGRAMS
SCOTT-SE-L100-HV-DR-0001 TO 0021		HVAC AIRFLOW DIAGRAMS
SCOTT-SE-L100-JN-SC-0001:00		HVAC/INST E&I LEGENDS & SYMBOLS

THIS DRAWING IS THE PROPERTY OF SLP ENGINEERING LTD AND MUST NOT BE COPIED, REPRODUCED, OR SHOWN TO A THIRD PARTY WITHOUT THE WRITTEN CONSENT OF SLP ENGINEERING LTD.

--	--	
AMERADA HESS LIMITED
SCOTT FIELD DEVELOPMENT

SLP ENGINEERING LIMITED
SLP ENGINEERING LTD.
HAMILTON ROAD,
LONESTOP,
SUFFOLK, NR32 1XF.

TEL: 0502-587322
TELEX: 975401
FAX: 0502-512589

TITLE HVAC/INSTRUMENTS E & I
DUCTING AND INSTRUMENT DIAGRAM
H+V SUPPLY SYSTEM

DRAWING NO.
NTS SCOTT-SE-L100-JN-DG-0003-00 10

ORIGINAL SCALE	PROJECT	ORIG	AREA/MOD	DISC	TYPE	SEQ. No	SHT	REV
----------------	---------	------	----------	------	------	---------	-----	-----