


P -8316B High Pressure Pump 1st Stage	PM-8316B High Pressure Pump Motor
Manufacturer : CAT	Manufacturer : LOHER
Type : CAT 3834DEx	Type : DNGW-180LB-06A
Dimensions : 770x500x1230 mm	Supply Volts : 690 Volts
Work Press. : 65 barg	Frequency : 50 Hz
Material : SS S.Duplex	Rating : 15 kW
Design pressure : 71.5 barg	Speed : 969 rpm
Design temp. : 85°C	
Capacity : 5.4 m3/hr	

Nexen Petroleum (U.K.) Limited								
VENDOR : HATENBOER-WATER (WORLEY PARSONS)								
EQUIPMENT TITLE : FRESH WATER MAKER PACKAGE								
EQUIPMENT TAG NO(S) : X-8301								
Vendor Document Number								
Purchase Order No		Doc Type Code		Seq. Sheet No		Rev.	DATE	
168397 - 200 - PO - 3372 - MC2 - 001 - 07						Z1	18/10/18	
SUPPLIER DOCUMENT REVIEW								
Rejected (Assai Code - REJ) - Quality and content is out of conformity with Company requirements. Document shall be revised by Supplier to incorporate the necessary changes and subsequently re-submitted.								
Accepted With Comments (Assai Code - AWC) - Generally acceptable but elements require to be addressed. Document shall be revised by Supplier to incorporate the necessary changes and subsequently re-submitted.								
Accepted As Final (Assai Code - FIN) - Documents are considered acceptable, do not re-submit.								
Accepted For Information (Assai Code - AFI) - No further action required, do not re-submit.								
Review of Vendor documents does not relieve Vendor of the responsibility for correctness under the Purchase Order. Permission to proceed does not constitute acceptance of design, detail and calculations, test methods or materials developed or selected by the Vendor and does not relieve the Vendor from full compliance with the Purchase Order or any other obligations, nor detract from any of the Purchaser's rights.								
Z1	18/10/18	AS-BUILT FOR GMOC0331			[Signatures]			
REV	DATE	DESCRIPTION			DRN	CHK	APP	CLT

PSV-83139B-  
CONNECTION SIZE: 1D1  
SET PRESSURE: 68 barg  
SIZING CASE: Blocked Discharge  
SIZED ACCORDING  
API 520/521  
ø 10 mm

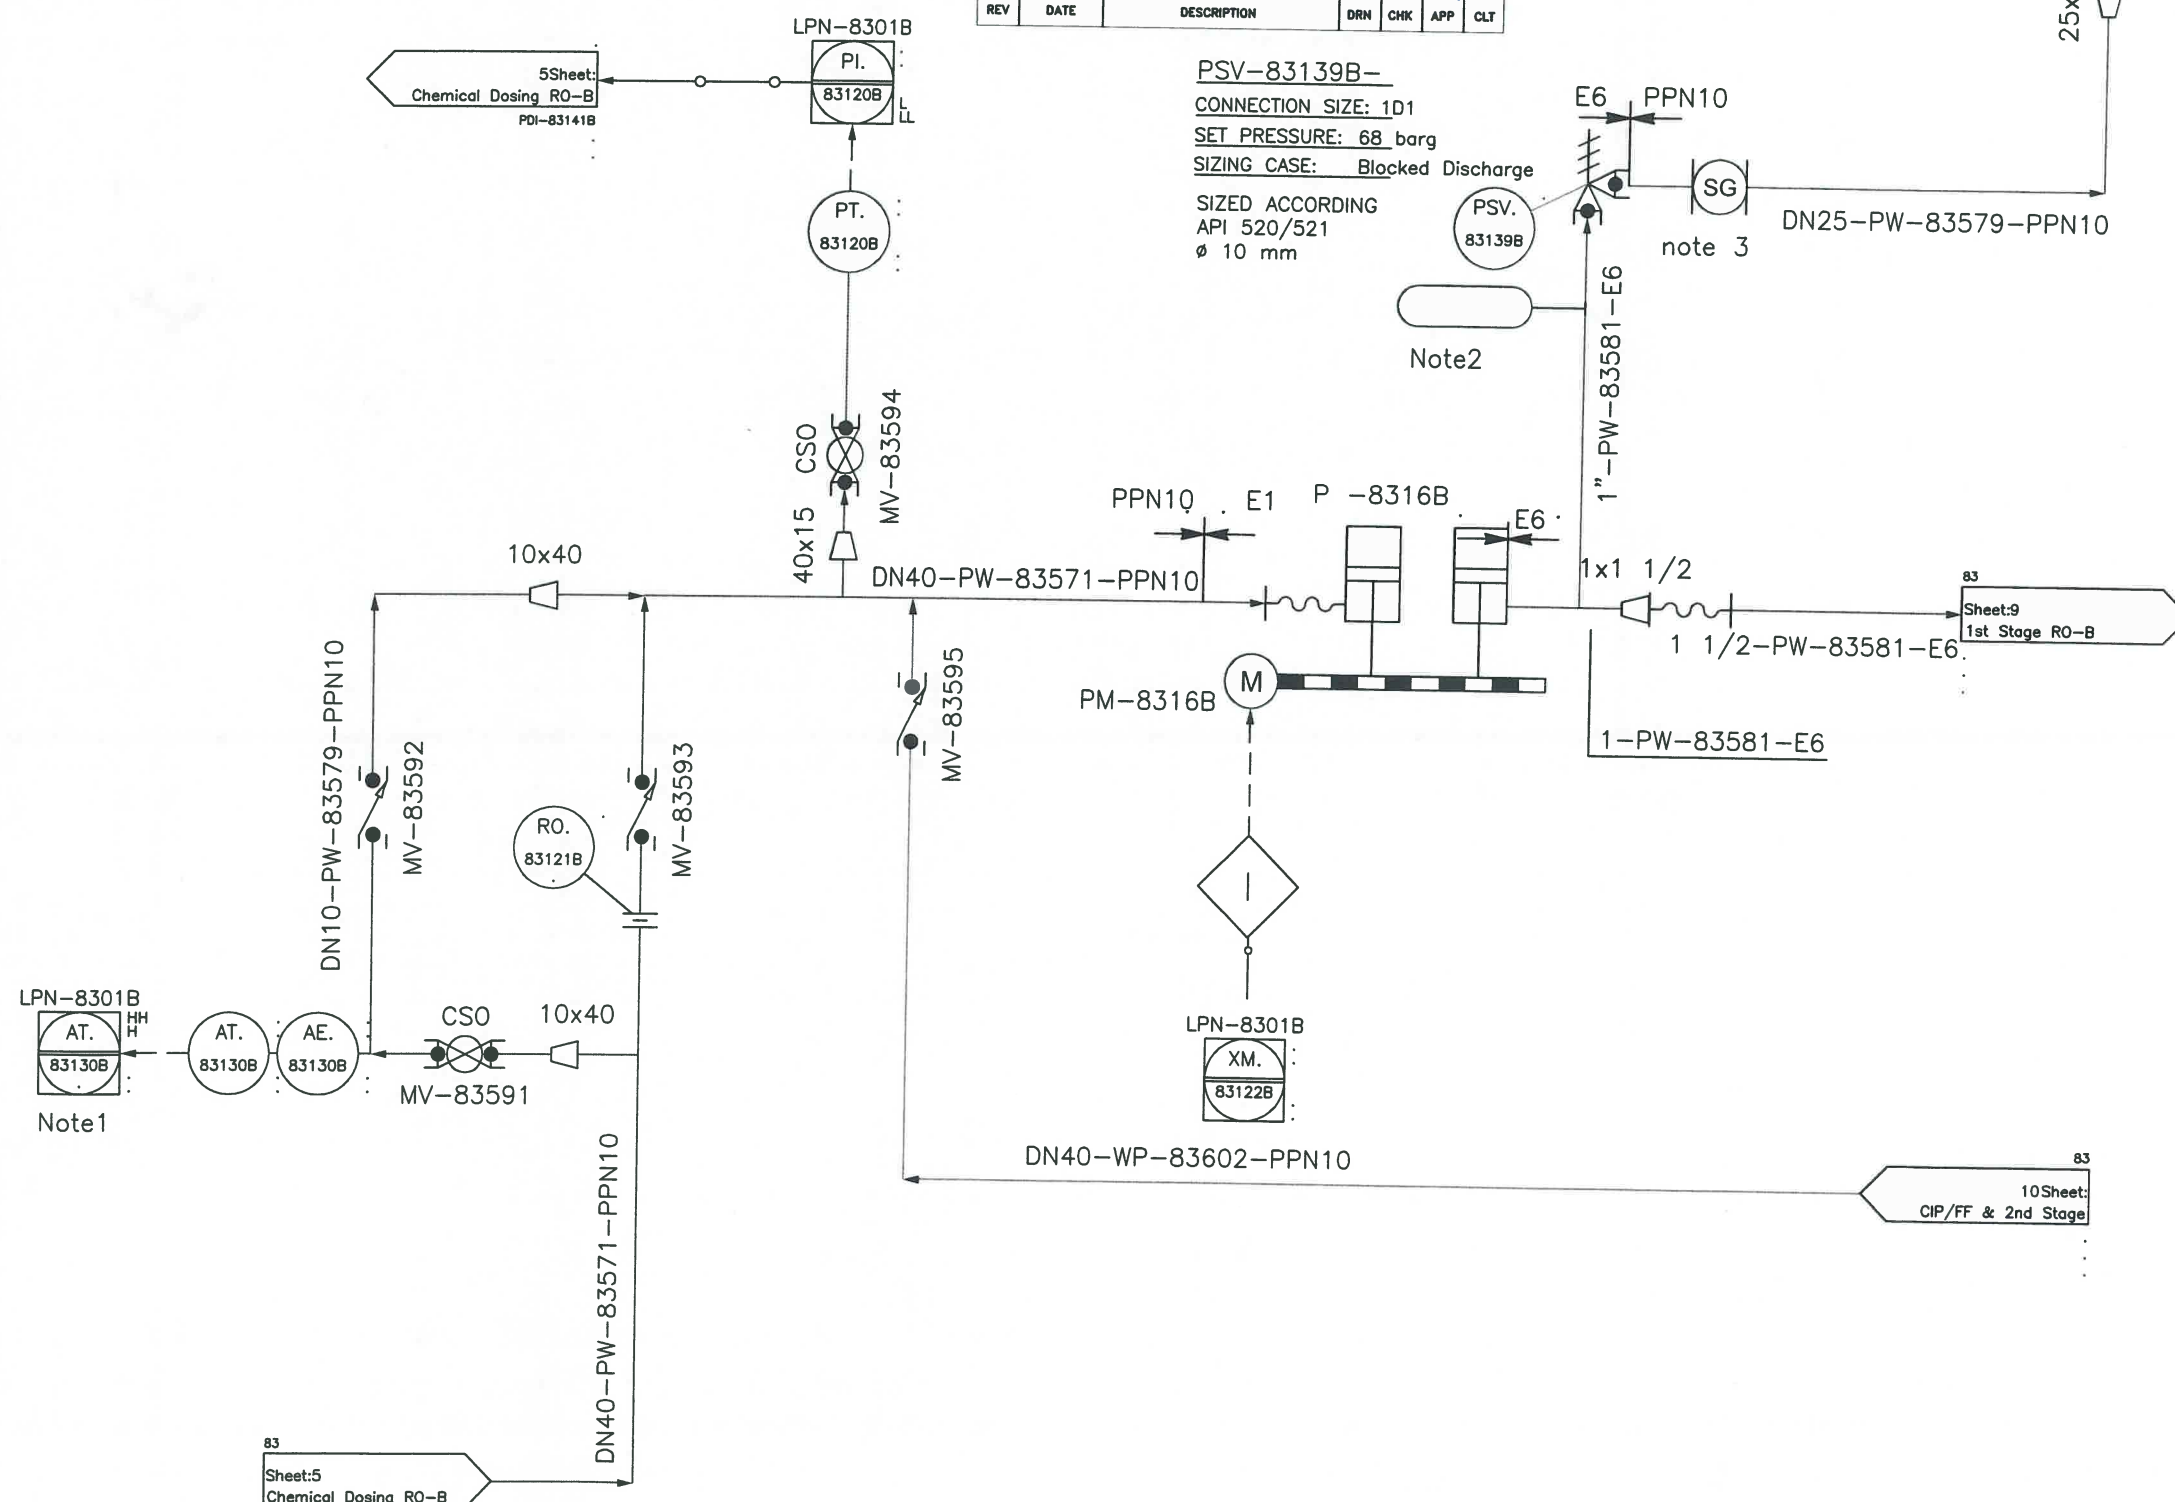

Nexen Petroleum U.K. Limited Golden Eagle Area Development				
Vendor: Hatenboer-Water BV				
Equipment title: Fresh Water Maker Package				
Equipment tag NO(S): X-8301				
GEAD Document Number				
PO Number	Doc Type Code	Seq No	Rev. Date	
168397-200-PO-3372	MC2	001	10/13/2018	
INCLUDES DOC CODES:			TOTAL SHEETS: 16	
F	Final (accepted)-Manufacturing may proceed.			
A	Qualified Release- review and re-submit. Manufacturing may proceed subject to incorporation of comments			
R	Rejected-revise and re-submit. Manufacturing may not proceed.			
I	Accepted for information only			

Review of Vendor documents does not relieve Vendor of the responsibility for correctness under the Purchase Order. Permission to proceed does not constitute acceptance of design, detail and calculations, test methods or materials developed or selected by the Vendor and does not relieve the Vendor from full compliance with the Purchase Order or any other obligations, nor detract from any of the Purchaser's rights.

Engineer: \_\_\_\_\_ Date: \_\_\_\_\_

#### NOTES

- Note1: Chlorine Measurement  
Note2: Pulsation Damper  
Note3: Sight Glass

9	27-06-13	ASBUILD	PR	LDG	PJ
8	06-05-13	ASBUILD	PR	LDG	PJ
7	06-02-13	ASBUILD	PR	LdG	PJ
6	14-11-12	ASBUILD	PR	LdG	PJ
5	24-10-12	AFTER COMMENTS	PR	LdG	PJ
4	06-07-12	AFTER COMMENTS	MdV	RU	LdG
3	03-05-12	AFTER COMMENTS	MdV	RU	LdG
2	18-01-12	AFTER COMMENTS	AO	RU	LDG
1	16-11-11	REV 1	RM	RU	LDG
0	14-09-11	FIRST ISSUE	AK	RU	LDG
REV	DATE	DESCRIPTION	DRN	CHK	APP

DRAWING INFORMATION:  
P&ID: 7  
Description: HPP 1st Stage RO-B  
Drawn by: renmic  
Date: 27/09/2018



PROJECT INFORMATION:  
Project: 458058  
Client: Nexen  
Client Ref: Package Golden Eagle  
Description: PO 3372

Drawing number: \_\_\_\_\_ Sheet: 7/16 Rev: 9