


IF IN DOUBT-ASK

NOTE:
1. STATED OPERATING CONDITIONS ARE MAXIMUM.
THE NORMAL OPERATING PRESSURE ACROSS THE PACKAGE
WILL BE APPROXIMATELY 2 BARG.

ITEM No/TAG No. DESCRIPTION SIZE/CAPACITY OPERATING CONDITIONS MAX DESIGN CONDITIONS DUTY	P-8355A & P-8355B SECONDARY HW CIRCULATING RETURN PUMPS 0.8 L/S 0.5 BARG DIFFERENTIAL HEAD 25 BARG / 120°C 0.37 kW	P-8365A & P-8365B CALORIFIER LEGIONELLA PUMPS 0.5 L/S 0.50 BARG 25 BARG / 120°C 0.37 kW	H-8355A & H-8355B HW STORAGE CALORIFIERS 2800 LITRE 3 BARG COLD FEED PRESSURE 4 BARG / 80°C 60 kW	V-8355 HW CALORIFIER EXPANSION VESSEL 750 LITRE 3.50 BARG 10 BARG / 99°C N/A	X-8303A/B UV STERILISER 41.5 m3/hr 3 BAR 10 BARG / 50°C 1.3 kW
----------------------------------------------------------------------------------------------------------	-----------------------------------------------------------------------------------------------------------------------------------	--------------------------------------------------------------------------------------------------------	------------------------------------------------------------------------------------------------------------------	---------------------------------------------------------------------------------------------	-------------------------------------------------------------------------------

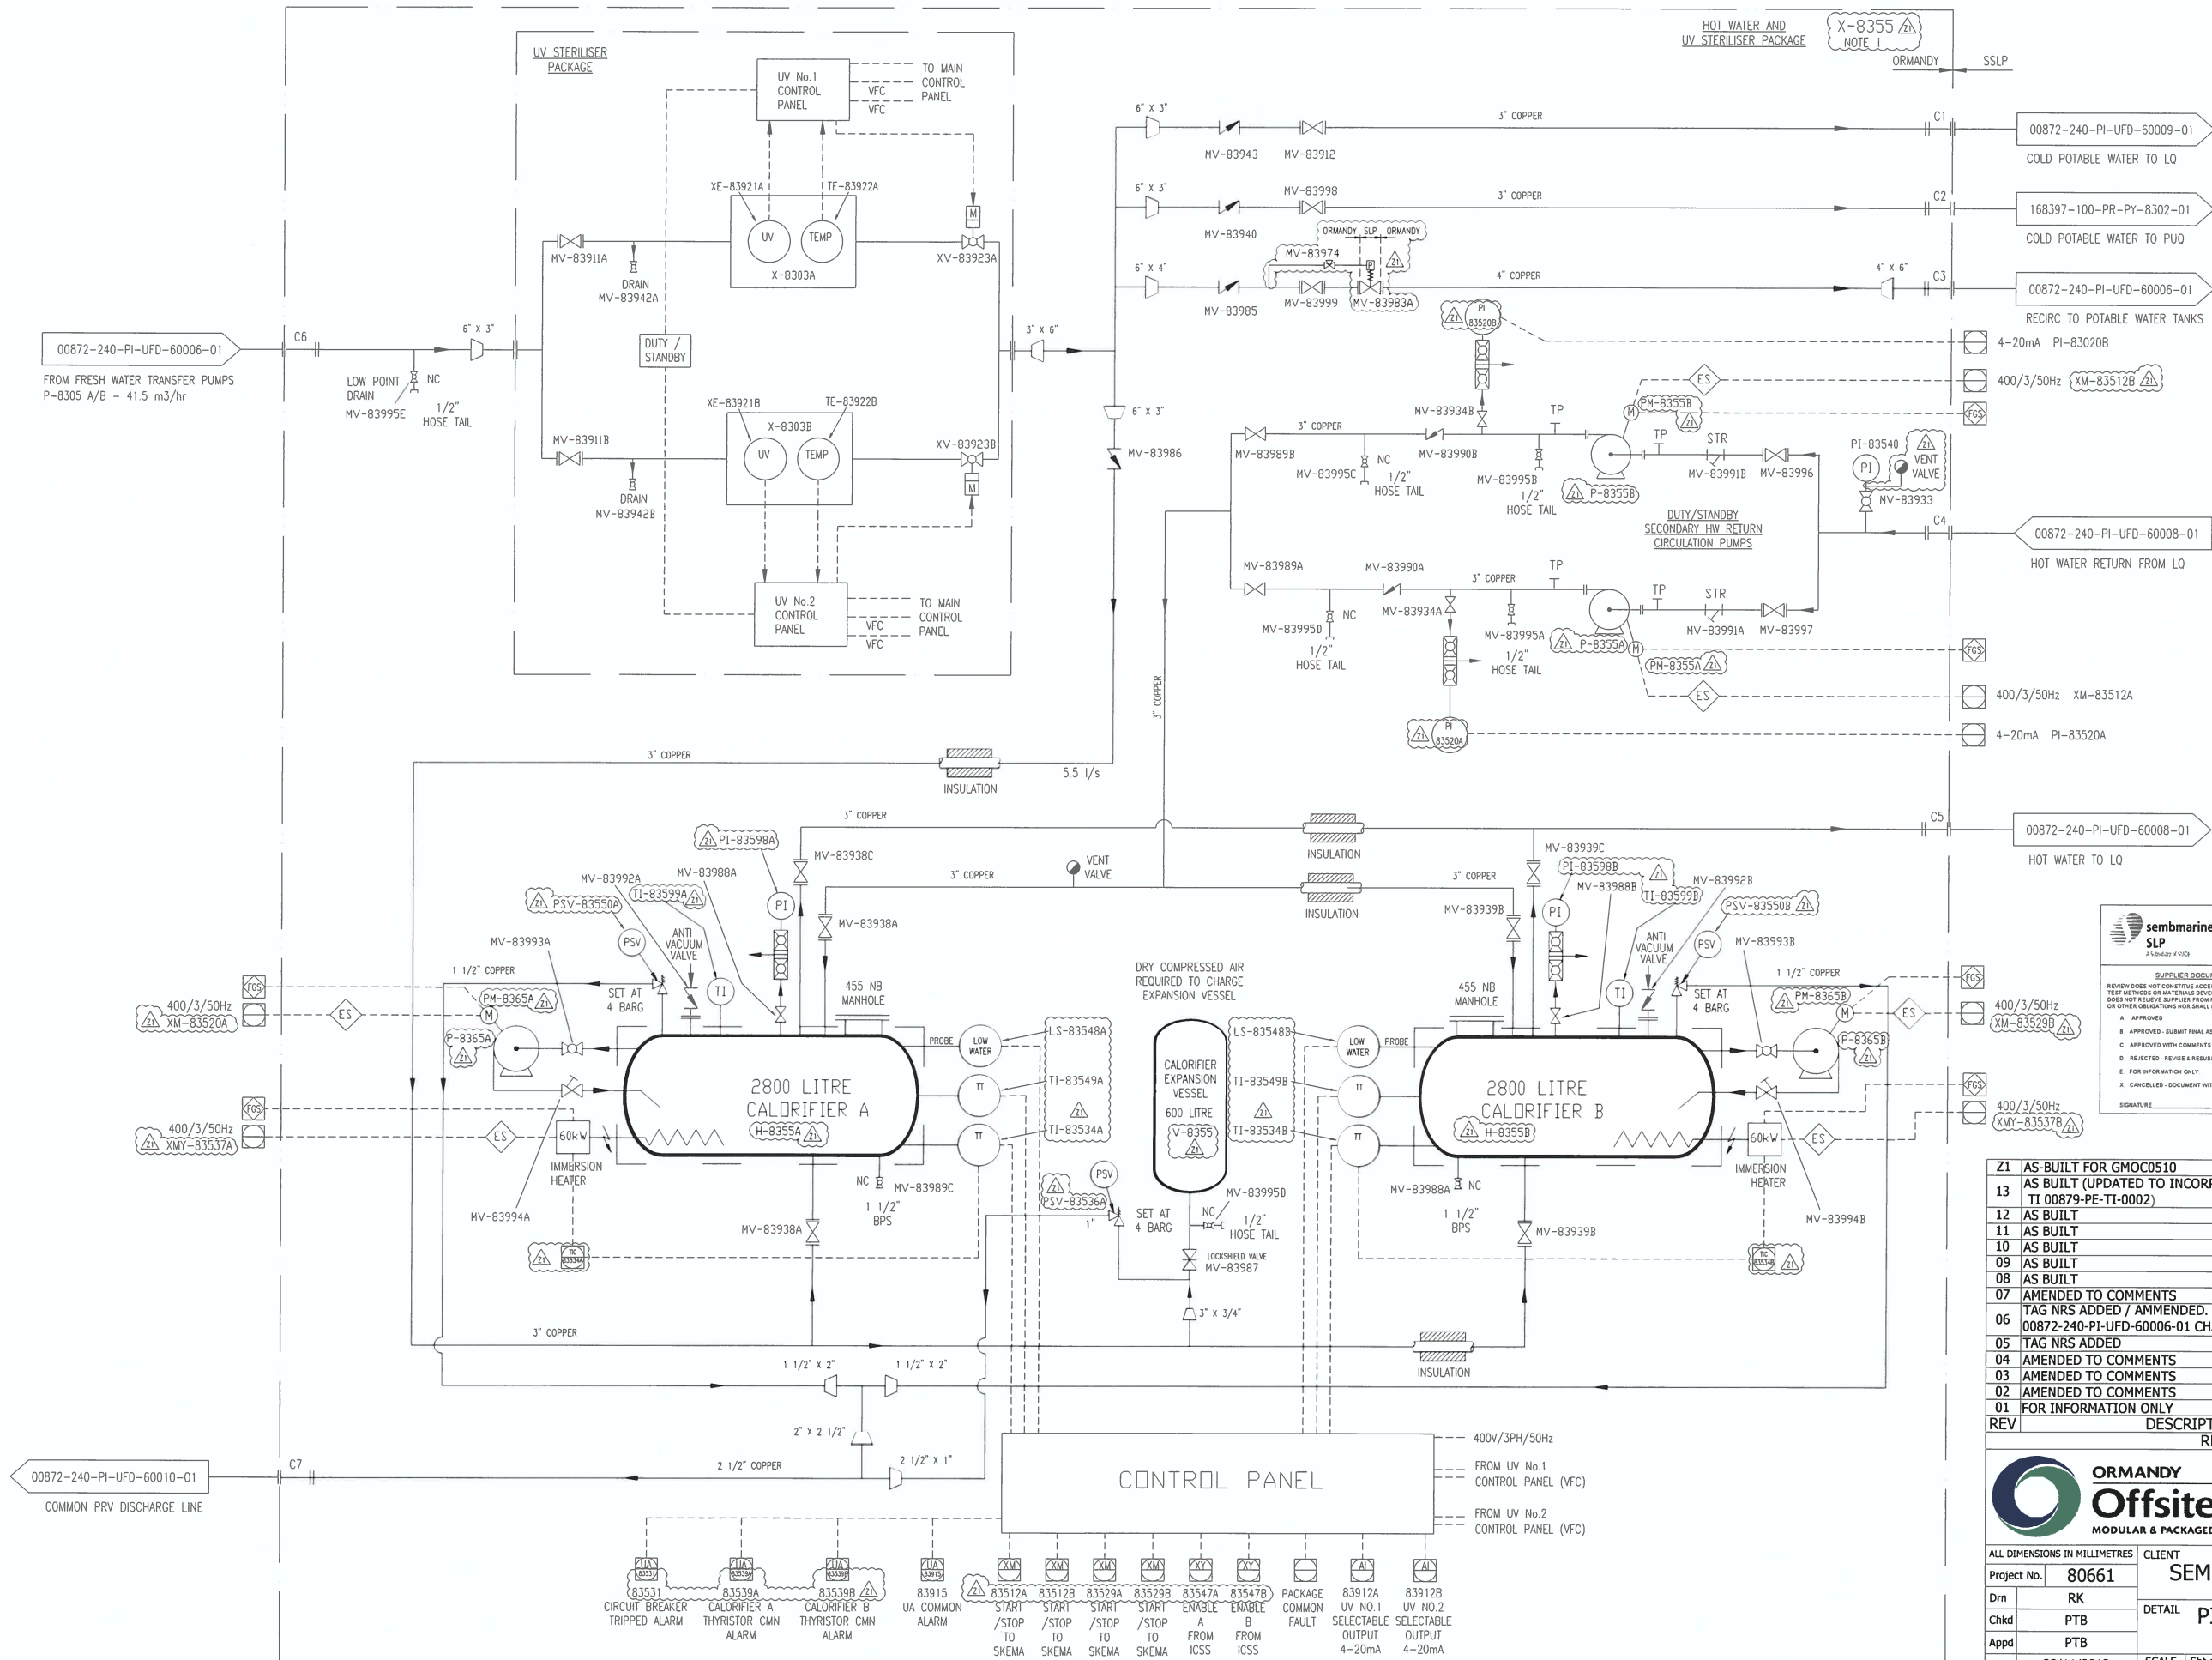

SEMBMARINE SLP		NEXEN PETROLEUM U.K. LIMITED GOLDEN EAGLE AREA DEVELOPMENT LIVING QUARTERS	
SUPPLIER DOCUMENT REVIEW		EQUIPMENT DESCRIPTION	
REVIEW DOES NOT CONSTITUTE ACCEPTANCE OF DESIGN DETAILS. CALCULATIONS TEST METHODS OR MATERIALS DEVELOPED OR SELECTED BY SUPPLIER AND DOES NOT RELIEVE SUPPLIER FROM FULL COMPLIANCE WITH CONTRACTUAL OR OTHER OBLIGATIONS NOR SHALL IT DETRACT FROM ANY PURCHASER RIGHTS.		CALORIFIER HOUSE PACKAGE	
A. APPROVED - SUBMIT FINAL AS-BUILT B. APPROVED WITH COMMENTS - RESUBMIT C. APPROVED WITH COMMENTS - RESUBMIT D. REJECTED - REVISE & RESUBMIT E. FOR INFORMATION ONLY F. CANCELLED - DOCUMENT WITHDRAWN OR SUPERSEDED		TAG NO. 5	
SIGNATURE _____ DATE _____		DOCUMENT NO.	
		PROJECT NO. 1113	
		DISC. CODE ME	
		PURCHASE ORDER NO. 0588	
		SHEET CODE G07	
		SEQUENCE NO. 001	
		REV. Z1	

REV	DESCRIPTION	DATE	DRN	APP'D	CLT
Z1	AS-BUILT FOR GMOC0510	17/11/2022	TPK	TF	
13	AS BUILT (UPDATED TO INCORPORATE TI 00879-PE-TI-0002)	19/09/2014			
12	AS BUILT	16/05/2014	PTB	PTB	
11	AS BUILT	08/01/2014	PTB	PTB	
10	AS BUILT	03/01/2014	PTB	PTB	
09	AS BUILT	28/10/2013	PTB	PTB	
08	AS BUILT	20/08/2013	PTB	PTB	
07	AMENDED TO COMMENTS	17/07/2013	PTB	PTB	
06	TAG NRS ADDED / AMENDED. LINE 00872-240-PI-UF0-60006-01 CHANGED TO 6"	28/05/2013	PTB	PTB	
05	TAG NRS ADDED	08/03/2013	PTB	PTB	
04	AMENDED TO COMMENTS	11/02/2012	PTB	PTB	
03	AMENDED TO COMMENTS	30/01/2013	PTB	PTB	
02	AMENDED TO COMMENTS	15/01/2013	PTB	PTB	
01	FOR INFORMATION ONLY	22/11/2012	PTB	PTB	

ORMANDY Offsite		REVISION HISTORY	
MODULAR & PACKAGED SOLUTIONS		ATLAS WORKS, GIBBY STREET, HALIFAX HX1 4DB, ENGLAND. TEL: 01422 350111 - FAX: 01422 350066 SALES@ORMANDYLTD.COM - WWW ORMANDYLTD.COM ORMANDY OFFSITE IS A TRADING NAME OF ORMANDY LTD.	
THIS DRAWING IS THE PROPERTY OF ORMANDY OFFSITE AND MUST NOT BE COPIED, REPRODUCED OR CIRCULATED FOR ANY PURPOSE WHATSOEVER WITHOUT FIRST OBTAINING THEIR WRITTEN CONSENT NOR MAY THE DESIGN OR ANY INFORMATION SHOWN THEREON BE DISCLOSED TO ANY THIRD PARTY.			

ALL DIMENSIONS IN MILLIMETRES		CLIENT	
Project No.	80661	SEMBMARINE SLP - GOLDEN EAGLE	
Drn	RK	DETAIL	
Chkd	PTB	PIPING & INSTRUMENTATION DIAGRAM	
Appd	PTB		
Date	22/11/2012	SCALE	Sht size
1ST ANGLE PROJECTION		-	A1
		Drg No.	Sht OF ISSUE
		80661-PID-01	1 1 Z1