


AIR SUPPLY
10 BAR
(BY OTHERS)

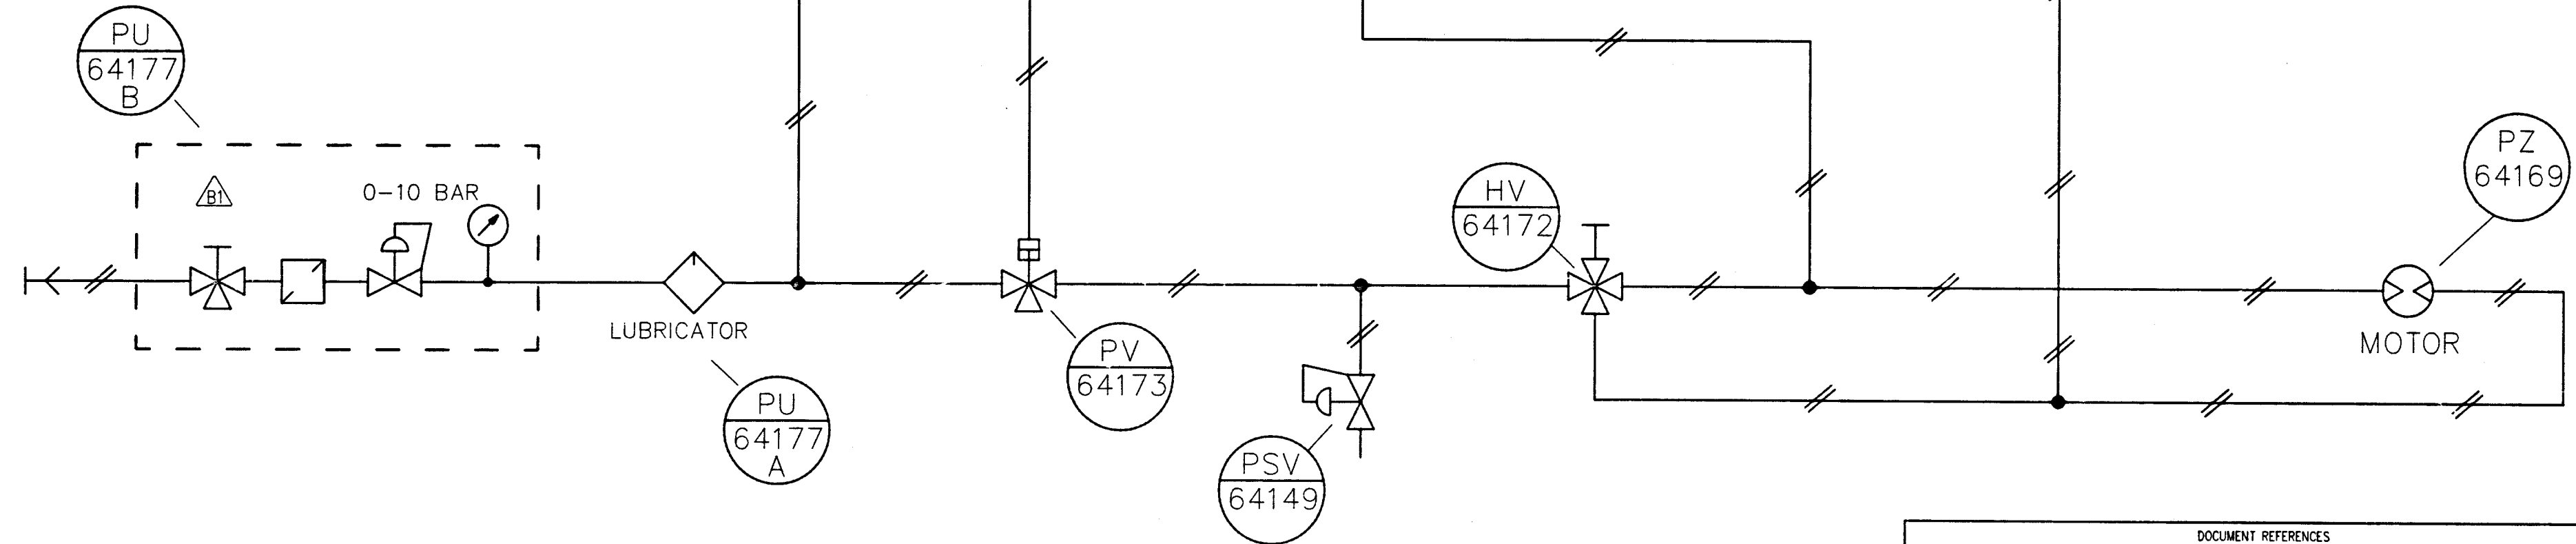

PNEUMATIC SYSTEM

AMERADA HESS LIMITED
Scott Field Development

RETURN CODE 8

**THIS DOCUMENT HAS
BEEN ACCEPTED BY
COMPANY AS
"AS SUPPLIED"
WITHOUT ENGINEERING
REVIEW**

AS SUPPLIED

Seller shall complete both Sections A & B, sign & date

A All Company comments on previous submission have been fully incorporated
☐ Yes ☐ No ☒ Not Applicable

B There are no design changes, other than incorporation of Company comments, from previous submission
☒ Yes ☐ No

Seller's Verifying Statement:
 This document accurately represents the "As Supplied" condition of the Work

Sellers Authorised Signature: *ESR* Date: *18/03/93*

DOCUMENT REFERENCES			
Ref. No.	Description	AHL Doc. No.	COT Doc. No.
1	BOM REEL NO. 1	C0040	223030-03-00-00
2	ELE. INTERFACE DIAGRAM REEL 1	F0003	SK-66030-03-08-00
3	G.A. REEL NO. 1	C0009	SK-66030-03-00-00
4	FD REEL NO. 1	F0010	SK-66030-03-01-00

COMPANY RETURN CODES		AMERADA HESS LIMITED SCOTT FIELD DEVELOPMENT	
<input type="checkbox"/> 1	Accepted "As Supplied"	Package Desc	WORKOVER CONTROL SYST.
<input type="checkbox"/> 2	Accepted-No Comments	Equip. Nos	SU 6401B
<input type="checkbox"/> 3	Qualified Acceptance - Minor Comments Revise & Resubmit as "As Supplied" Work May Proceed	SDRS Codes	D01
<input type="checkbox"/> 4	Qualified Acceptance - Minor Comments Revise & Resubmit To Obtain Code 2 Work May Proceed	Module	Sheet 2 of 2
<input type="checkbox"/> 5	Qualified Acceptance - Major Comments. Revise & Resubmit To Obtain Code 2 Work May Proceed	Purchase Order No	Document No
<input type="checkbox"/> 6	Rejected - Revise & Resubmit Immediately Work May Not Proceed In The Affected Areas	Rev	
<input type="checkbox"/> 7	Review Not Required		

Company's Signature		Date	

Supersedes		Dated	

Graphic symbols according to DIN ISO 1219 Tolerances according to DIN 7168 m		Copyright according to DIN 34 Copying of this document, and giving it to others and the use or communication of the contents thereof, are forbidden without express authority.	
Rev.	Date	Appr.	Remarks
B1	9.2.93	K.S.	MID KUE AS BUILT
A1	23.7.92	K.S.	MID KUE INITIAL RELEASE

Partlist:		Scale	
223030-03-00-00		7	
DWG No.: SK-66030-03-02-00		Sheet 2 of 2	