


PACKAGE : X-5103  
SPARE TANK

CONTINUED FROM DRG. No. 440010/335

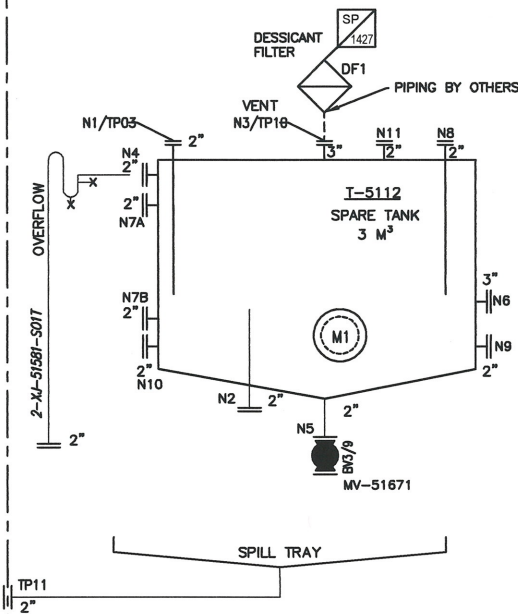

1. SYMBOLOGY IN ACCORDANCE WITH LEGEND SHEETS 168397-100-PR-PI-0001-01, 0002-01, 0003-1 AND 0004-1.
2. DELETED
3. DELETED
4. THREAD SEALANT : SWAK.
5. FLUID : N/A.
6. ALL DRAIN NOZZLES TO BE LOCATED FLUSH WITH TANK/VESSEL BOTTOM TO ENABLE COMPLETE EMPTYING OF TANK.
7. ALL VENTS AND BLEEDS MUST BE FITTED WITH PLUGS.
8. DESSICANT FILTER TO BE SUPPLIED LOOSE FOR LOCATION IN PURCHASERS PIPEWORK.
9. OVERFLOW DIRECTED TO SPILL TRAY

NOZZLE	TANK QTY	SIZE	DESCRIPTION	RATING	INTERFACE
N2	1	2"	LIQUID OUTLET	150#	RF
N4	1	2"	OVERFLOW CONNECTION	150#	RF
N5	1	2"	DRAIN CONNECTION	150#	RF
N6	1	3"	DP LEVEL TRANSMITTER	150#	RF
N7A/B	2	2"	LEVEL GAUGE	150#	RF
N8	1	2"	PSV RETURN TO TANK	150#	RF
N9	1	2"	UTILITY CONNECTION	150#	RF
N10	1	2"	TEMP. TRANSMITTER (FUTURE)	150#	RF
M1	1	24"	MANWAY		
TP3/N1	1	2"	SPARE SUPPLY	150#	RF
TP10/N3	1	3"	SPARE VENT	150#	RF
TP11	1	2"	SPILL TRAY	150#	RF
N11	1	2"	CALIBRATION POT RETURN	150#	RF

As-Built No  
Change

Revision 07 - Issued As-Built by CB&I as  
per Nexen Site Red Line Mark-Up.

Nexen Petroleum (U.K.) Limited Golden Eagle Area Development			
VENDOR : TYCO			
EQUIPMENT TITLE : CHEMICAL INJECTION PACKAGE (WELL HEAD) SPARE			
EQUIPMENT TAG NO(S) : X-5103			
GEAD Vendor Document Number			
Purchase Order Number	Doc Type	Seq. No	Rev. DATE
168397-100-PO-3366	MC2	026	07 17/11/14
INCLUDES DOCUMENT CODES :		TOTAL SHEETS :	
F Final (accepted) - manufacturing may proceed.			
A Qualified Release - revise and re-submit. Manufacturing may proceed subject to incorporation of comments.			
R Rejected - revise and re-submit. Manufacturing may not proceed.			
I Accepted for information only.			
Review of Vendor documents does not relieve Vendor of the responsibility for correctness under the Purchase Order. Permission to proceed does not constitute acceptance of design, detail and calculations, test methods or materials developed or selected by the Vendor and does not relieve the Vendor from full compliance with the Purchase Order or any other obligations, nor detract from any of the Purchaser's rights.			
Engineer : B.h		Date : 17/11/14	

IF IN DOUBT ASK				tyco Fire & Integrated Solutions				Oil & Gas Barnard Road, Bowthorpe, Norwich, Norfolk NR5 9JB England Tel: +44 (0) 1603 201201 www.tycofis.com			
This drawing is confidential and copyright property of Tyco Fire & Integrated Solutions and must not be copied or lent without their written permission.				Orig	JF	03/02/12		NEXEN PETROLEUM UK LTD GOLDEN EAGLE AREA DEVELOPMENT CHEMICAL INJECTION PACKAGE			
				Chd	TC	03/02/12		Contract No. WN440010			
				App	AG	03/02/12		Drg No 440010/336			
DO NOT SCALE				Drawing Title				Rev 5			
				P&I DIAGRAM - SPARE TANK PACKAGE X-5103 WELLHEAD							

Rev	Date	Description	Orig	Ckd	App	Rev	Date	Description	Orig	Ckd	App
5	12/03/13	RE-ISSUED AS-BUILT (CS.017)	CP								
4	19/09/12	ISSUED AS-BUILT	PA	TC	AG						
3	11/07/12	ISSUED FOR MANUFACTURE	PA	TC	AG						
2	30/04/12	ISSUED FOR MANUFACTURE	PA	TC	AG						
1	19/03/12	ISSUED FOR MANUFACTURE	PA	TC	AG						
A	03/02/12	ISSUED FOR APPROVAL	JF	TC	AG						