

Seller shall complete both Sections A & B, sign & date

<b>A</b>	All Company comments on previous submission have been fully incorporated <input checked="" type="checkbox"/> Yes <input type="checkbox"/> No <input type="checkbox"/> Not Applicable
<b>B</b>	There are no design changes, other than incorporation of Company comments, from previous submission <input type="checkbox"/> Yes <input checked="" type="checkbox"/> No

**Seller's Verifying Statement:**  
This document accurately represents the "As Supplied" condition of the Work


Sellers Authorised Signature: <i>[Signature]</i>	Date: 21/8/16
--	---------------

FINAL CERTIFIED  
SIG. *T. Kelly*  
DATE 13/7/92  
WEIR PUMPS LTD.

TERMINAL POINT LIST		DESC OF CONNECTION
TP1	10"NB "GRAYLOCK"	MAIN PUMP SUCTION
TP2	8"NB "GRAYLOK"	MAIN PUMP <i>DELIVERY</i>
TP3	1"NB 2500 RTJ FLANGE	PUMP DRAIN
TP4	1"NB ANSI 150FF FLANGE	BEDPLATE DRAIN
TP5	3"NB ANSI 150FF FLANGE	COOLING WATER SUPPLY
TP6	3"NB ANSI 150FF FLANGE	COOLING WATER RETURN

NOTE:- TP 1 & TP2 SUPPLIED WITH MATING HUBS TO SUIT  
SCH160 PIPE COMPLETE WITH SEAL RINGS CLAMPS AND BOLTS


FIRST ANGLE  
PROJECTION

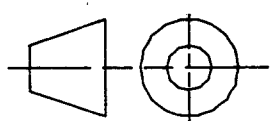

<b>COMPANY RETURN CODES</b> <input type="checkbox"/> 1. Accepted "As supplied" <input type="checkbox"/> 2. Accepted - No Comments <input type="checkbox"/> 3. Qualified Acceptance - Minor Comments. Revise & Resubmit as "As Supplied" Work May Proceed <input type="checkbox"/> 4. Qualified Acceptance - Minor Comments. Revise & Resubmit To Obtain Code 2 Work May Proceed <input type="checkbox"/> 5. Qualified Acceptance - Major Comments. Revise & Resubmit To Obtain Code 2 Work May Proceed <input type="checkbox"/> 6. Rejected - Revise & Resubmit Immediately Work May Not Proceed In The Affected Area <input type="checkbox"/> 7. Review Not Required		<b>AMERADA HESS LIMITED</b>  SCOTT FIELD DEVELOPMENT	
Package Desc SEAWATER INJECTION PUMPS		Equip Nos PY1402 A/B/C	
SPS Code D01/E10		Module U110	
Purchase Order No P0027		Document No D 000001	
Companies Signature: <i>[Signature]</i> Date: <i>2/1/92</i>		R <i>[Signature]</i>	

LOCAL INSTRUMENT

FRONT OF PANEL  
MOUNTED INSTRUMENT

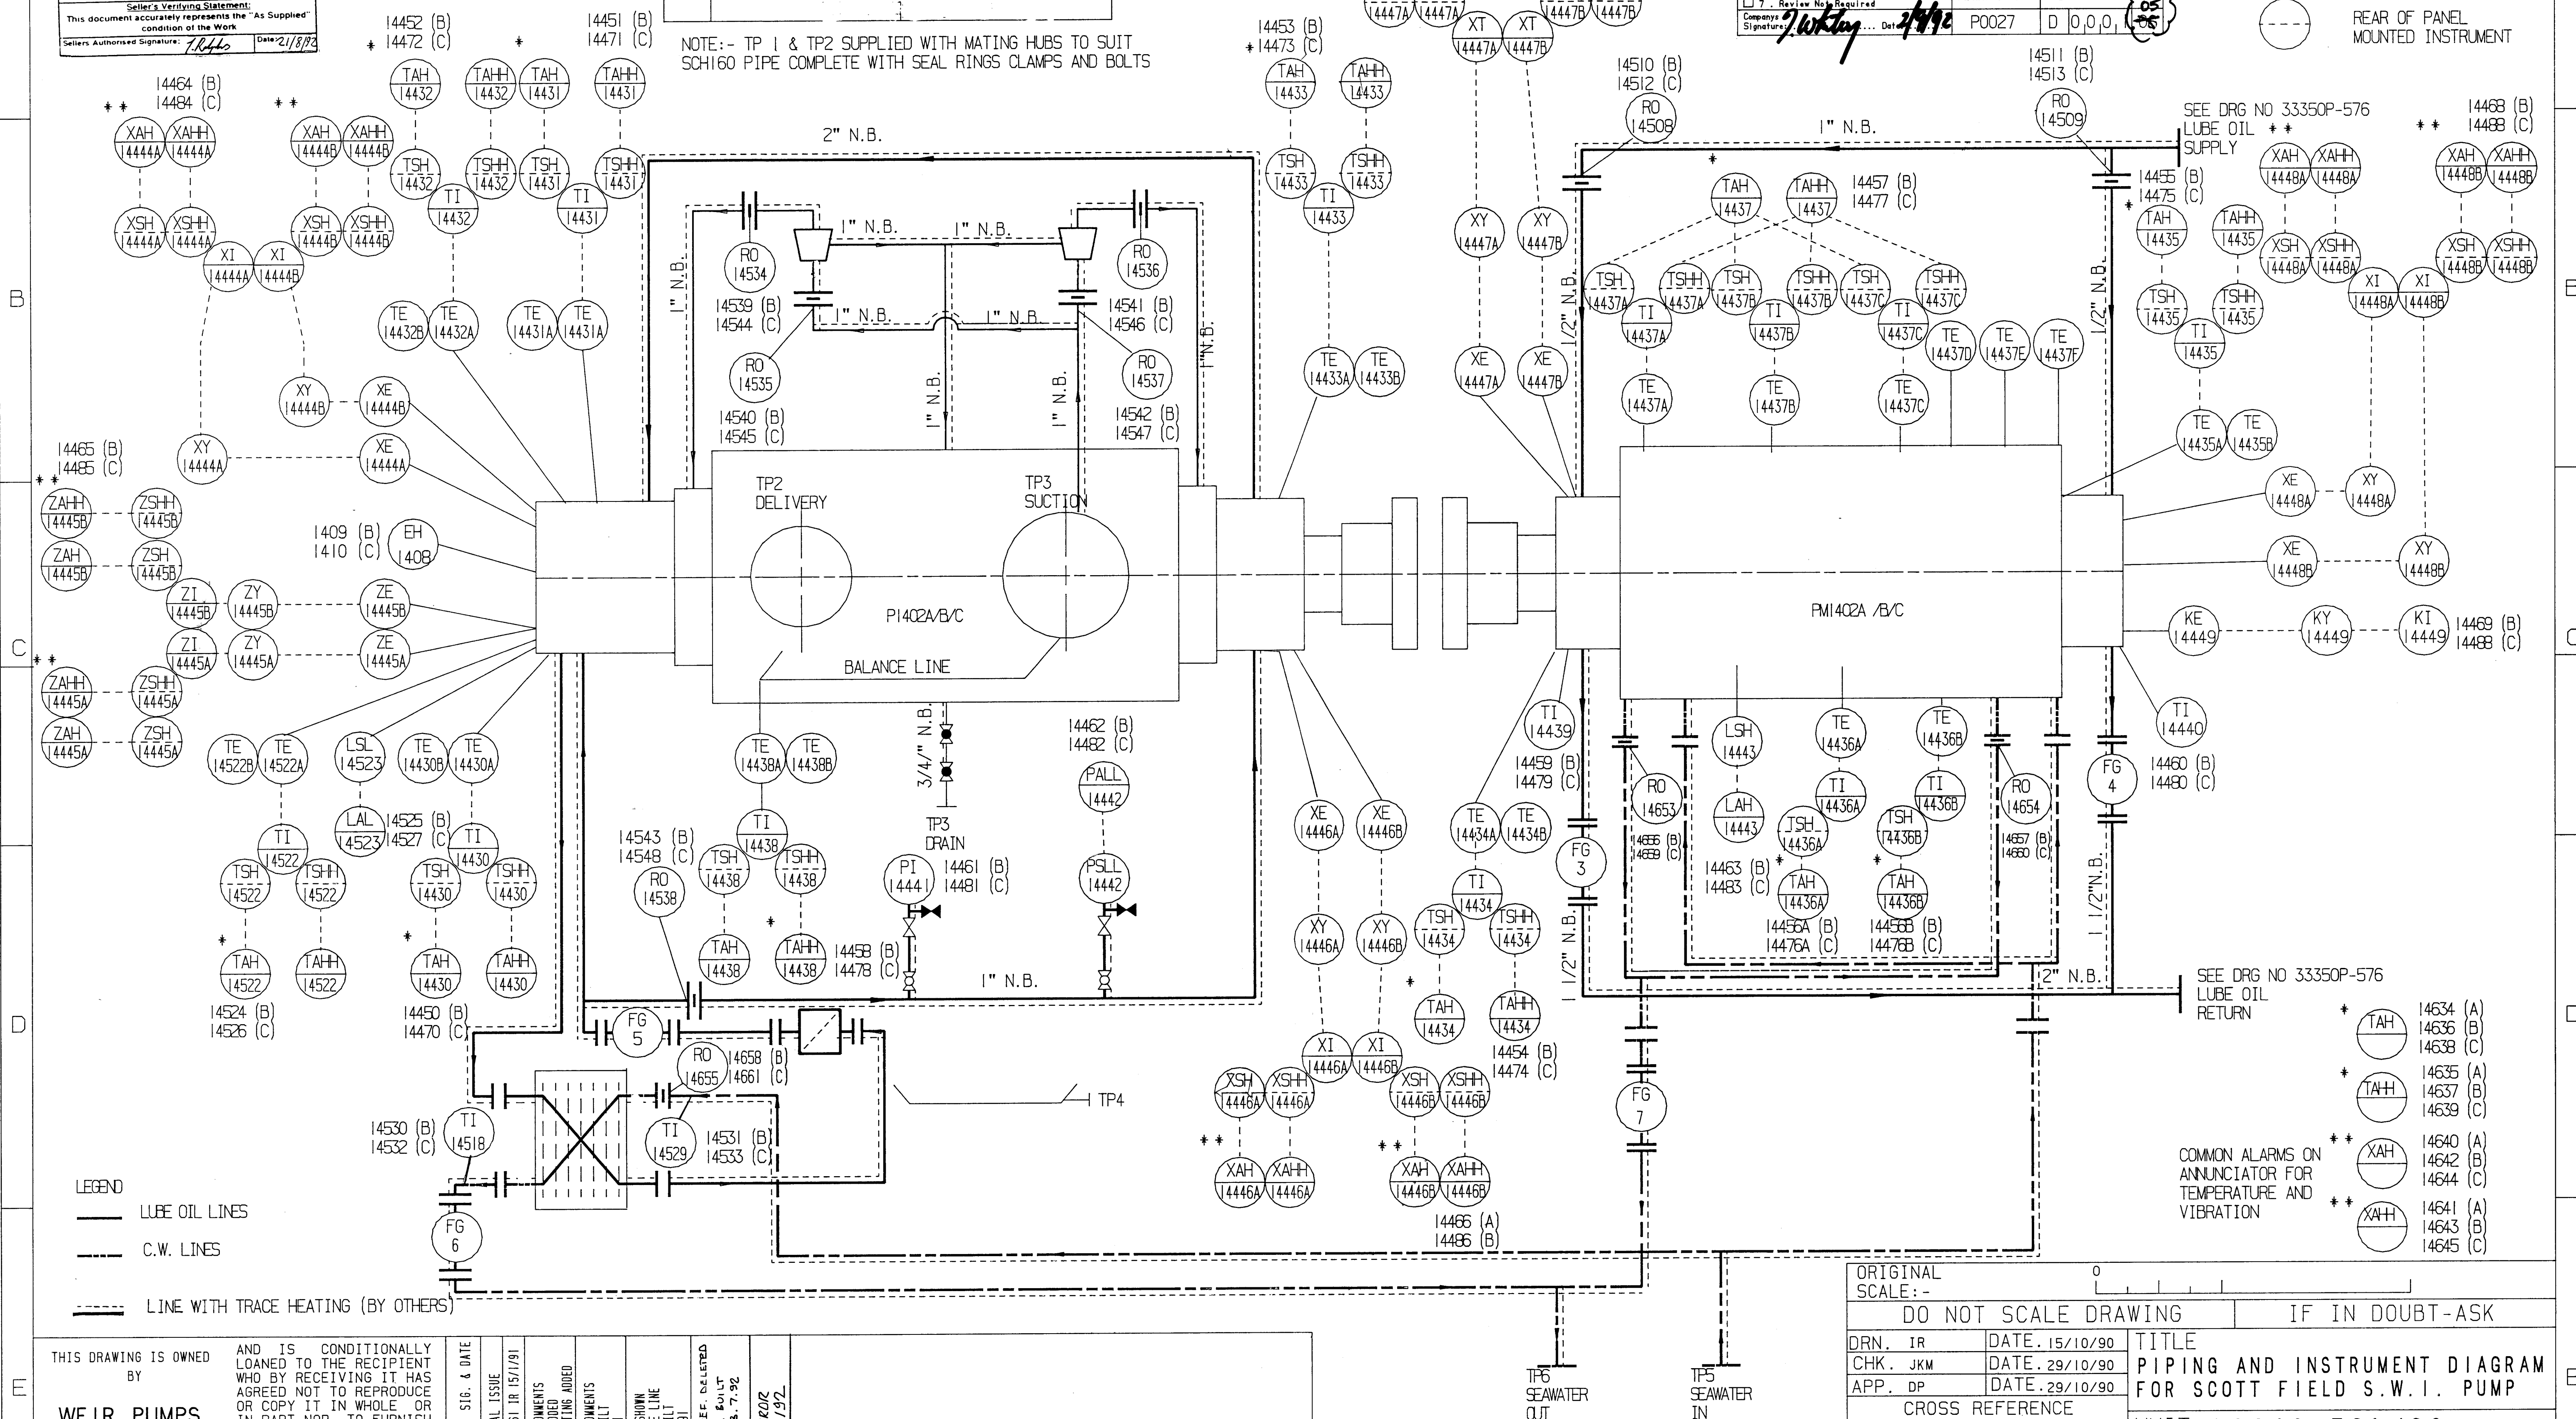REAR OF PANEL  
MOUNTED INSTRUMENT

THIS DRAWING IS OWNED  
BY  
WEIR PUMPS  
LIMITED

THIS DRAWING IS OWNED  
BY

WEIR PUMPS  
LIMITED

AND IS CONDITIONALLY  
LOANED TO THE RECIPIENT  
WHO BY RECEIVING IT HAS  
AGREED NOT TO REPRODUCE  
OR COPY IT IN WHOLE OR  
IN PART NOR TO FURNISH  
INFORMATION FROM IT TO  
OTHERS NOR TO MAKE ANY  
USE OF IT THAT IS NOT  
THE SUBJECT OF WRITTEN  
AGREEMENT BY WEIR  
PUMPS LIMITED AND TO  
RETURN IT UPON REQUEST.

LINE	ZONE	REVISION, SIG. & DATE
1	—	— ORIGINAL ISSUE
2	—	— SEE EN6861 IR 15/1/91
3	—	— CLIENTS COMMENTS TAP NOIS ADDED TRACE HEATING ADDED
4	—	— CLIENTS COMMENTS DRG AS BUILT IR 22/8/91
5	—	— CASE LTD SHOWN ON BALANCE LINE DRG AS BUILT IR 23/10/91
2A	—	T.P. REF. DELETED DRG. AS. BUILT <i>Sh</i> 13. 7.92
7	—	DRG ERROR 12.6/19.192

ORIGINAL  
SCALE: -

DO NOT SCALE DRAWING

IF IN DOUBT-ASK

DRN.	IR	DATE.	15/10/90	TITLE
CHK.	JKM	DATE.	29/10/90	PIPING AND INSTRUMENT DIAGRAM
APP.	DP	DATE.	29/10/90	FOR SCOTT FIELD S.W.I. PUMP
CROSS REFERENCE				UNIT 12843-701/03
INSTRUMENT LIST 11286IP-228				DRG NO. A45130P-323/07
				STATE LATEST ISSUE NO. WHEN QUOTING DRG
				PART DESCRIPTION CODE NO.