

IF IN DOUBT PLEASE ASK

TAG NUMBER	-	V-2707
DESCRIPTION	-	GLYCOL FLASH DRUM
I.D./ LENGTH	M	0.894 / 2.21 (T/F)
OP/DES PRESSURE	BARG	4.0 / 10 & FV
OP/DES TEMPERATURE	Deg C	56.6 / 100
TOTAL VOLUME	M3	1.4

TAG NUMBER	-	F-2714A/B
DESCRIPTION	-	2x100% RICH GLYCOL SOLIDS FILTERS
DIAMETER/ LENGTH	M	8" NB / 1.008 (T/F)
OP/DES PRESSURE	BARG	4.0 / 10 & FV
OP/DES TEMPERATURE	Deg C	56.6 / 100
TOTAL VOLUME	M3	0.025


NOTES:

- HEAT TRACING AND INSULATION BY OTHERS.
- FILTERS TO HAVE QUICK OPENING CLOSURES.
- CONTROL VALVE TO BE PROVIDED WITH A HANDWHEEL.
- DELETED.
- DELETED.
- LEVEL TRANSMITTERS ON GLYCOL FLASH DRUM ARE NUCLEONIC TYPE (SUPPLIED BY OTHERS).
- GLYCOL FLASH DRUM OFF GAS IS NORMALLY ROUTED TO LP GAS COMPRESSOR. IN CASE LP GAS COMPRESSOR IS UNAVAILABLE, THEN OFF GAS IS ROUTED TO THE HP FLARE.
- DASHED GLYCOL FLASH DRUM OFF GAS LINE TO LP GAS COMPRESSOR ARE OUTSIDE EXTERNAN SCOPE AND SHOWN FOR CLARITY. FOR DETAILS OF THIS LINE, INCLUDING VALVES AND INSTRUMENTATION REFER TO P&ID NUMBER 168397-100-PR-PI-2704-01.
- RICH GLYCOL SAMPLE POINT TO BE SIDE TAKE OFF CONNECTION WITH MODULAR VALVE MV-27196 MOUNTED IN THE HORIZONTAL POSITION.
- DELETED.
- DRIP TRAY UNDER 2 x 100% RICH GLYCOL SOLIDS FILTERS, F-2714A/B.
- DIGITAL PSD SIGNALS, LSHH-27699, LSHH-27697 AND LSHL-27698 ARE DERIVED IN THE NUCLEONIC PANEL FROM 4-20mA FIELD SIGNALS & SENT TO PSD.

13. Instrument tubing to direct flow into sample bottle.

HOLD

- DELETED.
- DELETED.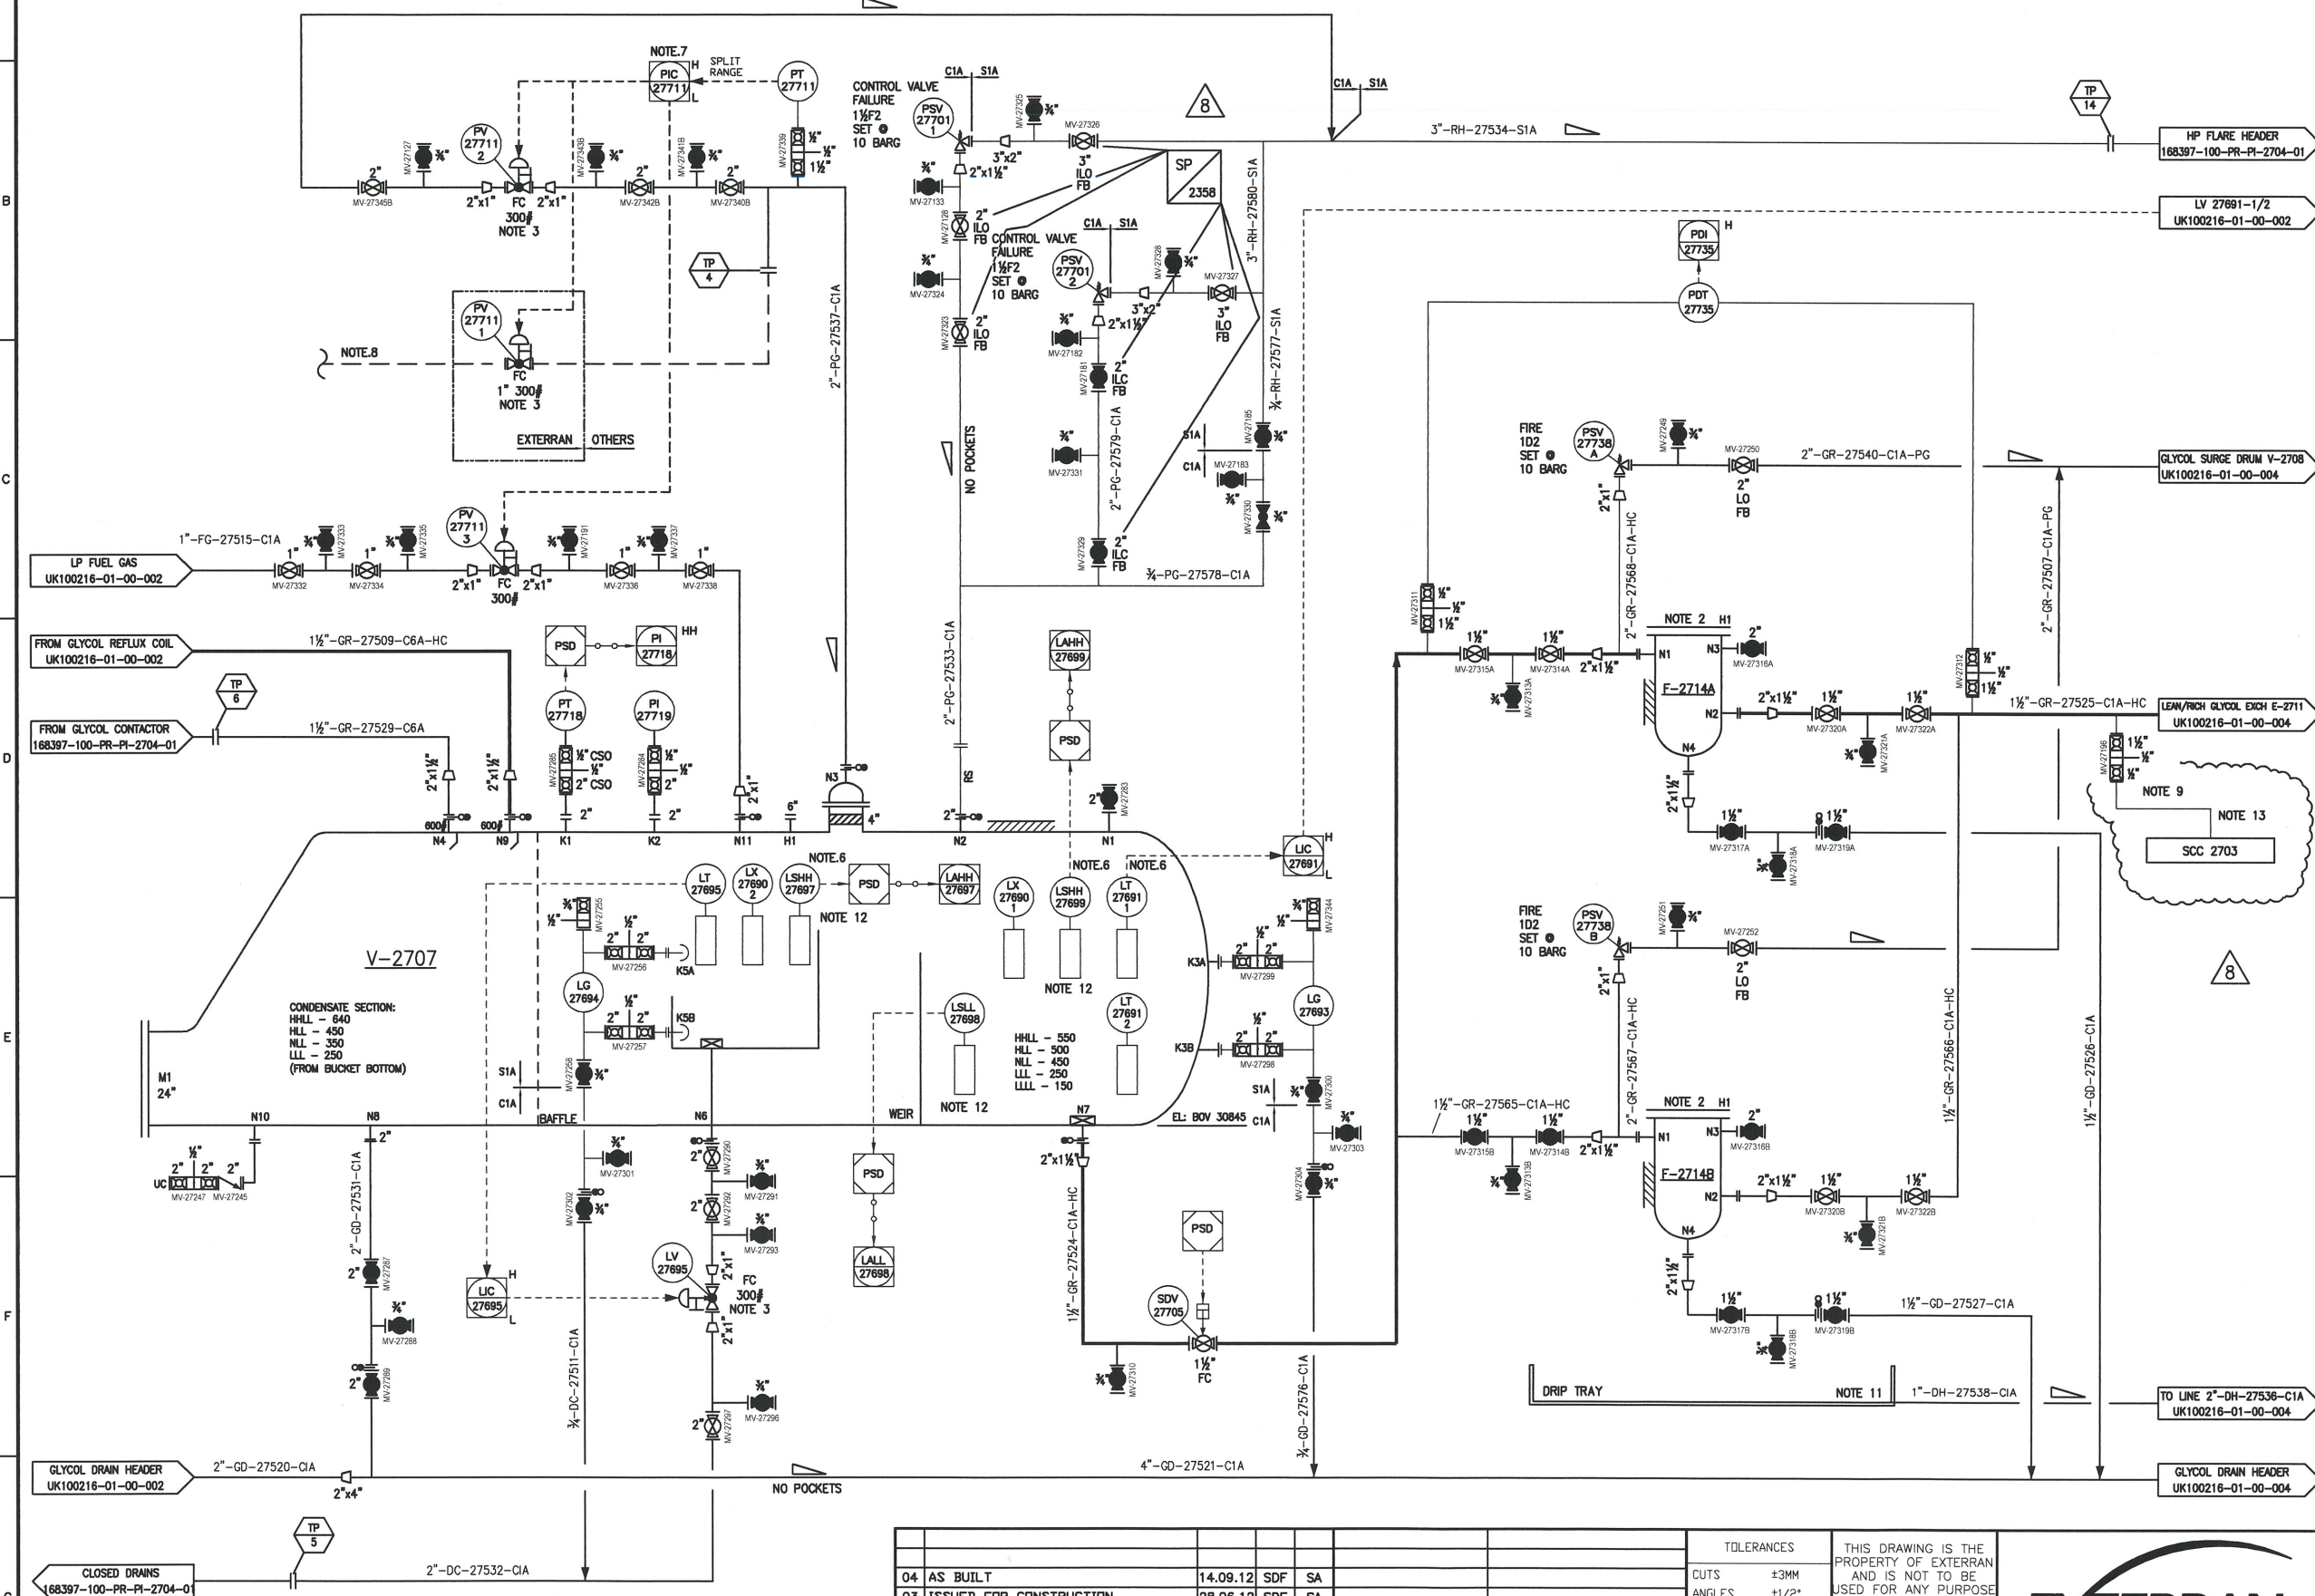
Revision 08 - Issued As-Built by CB&I as per Nexen Site Red Line Mark-Up.

Nexen Petroleum (U.K.) Limited Golden Eagle Area Development			
VENDOR : EXTERNAN (UK) LTD			
EQUIPMENT TITLE : GAS DEHYDRATION PACKAGE			
EQUIPMENT TAG NO(S) : X-2701			
GEAD Vendor Document Number			
Purchase Order Number	Doc Type	Seq. No.	Rev.
168397-200-PO-3362	MC2	003	08
TOTAL SHEETS :			DATE
168397-200-PO-3362			19.11.14
INCLUDES DOCUMENT CODES :			
F Final (accepted) - manufacturing may proceed.			
A Qualified Release - revise and re-submit. Manufacturing may proceed subject to incorporation of comments.			
R Rejected - revise and re-submit. Manufacturing may not proceed.			
I Accepted for information only.			
Review of Vendor documents does not relieve Vendor of the responsibility for correctness under the Purchase Order. Permission to proceed does not constitute acceptance of design, detail and calculations, test methods or materials developed or selected by the Vendor and does not relieve the Vendor from full compliance with the Purchase Order or any other obligations, nor detract from any of the Purchaser's rights.			
Engineer : Bhan			Date : 19.11.14

CUSTOMER NEXEN PETROLEUM (U.K.) LIMITED				
TITLE GLYCOL FLASH DRUM & RICH GLYCOL FILTERS				
DRAWN KEH	DATE 14.07.11	APPROVED PW	SCALE NTS	PROJECT NO. UK100216
NO. REQ'D DRAWING NO./WIP ORDER NO. UK100216-01-00-003				SHT. NO. 1 REV 04

04	AS BUILT	14.09.12	SDF	SA	
03	ISSUED FOR CONSTRUCTION	28.06.12	SDF	SA	
02	ISSUED FOR HAZOP WITH CLIENTS COMMENTS	18.10.11	SH	SA	
01	CLIENTS COMMENTS INCORPORATED	14.09.11	SH	SA	
0	FIRST ISSUE	14.07.11	KEH	SA	
REV	DESCRIPTION	DATE	BY	CK	
DWG NUMBER					
DESCRIPTION					
REVISIONS					
REFERENCE DRAWINGS					

TOLERANCES	THIS DRAWING IS THE PROPERTY OF EXTERNAN AND IS NOT TO BE USED FOR ANY PURPOSE OTHER THAN THAT FOR WHICH IT IS SPECIFICALLY FURNISHED.
CUTS	±3MM
ANGLES	±1/2°
WELD ASS'Y	±6MM
Edited by: BHANNAN	DRG SIZE : A1
Nov 19, 2014 - 3:57pm	
File: 168397-200-PO-3362-02-01.dwg	

Westgate, Aldridge, Walsall
B73 7SS, United Kingdom