


W2001 A/B  
INLET FILTERS


V2005 A,B,C,D  
DRYER VESSELS

W2003  
CARBON FILTER

W2002 A/B  
OUTLET FILTERS

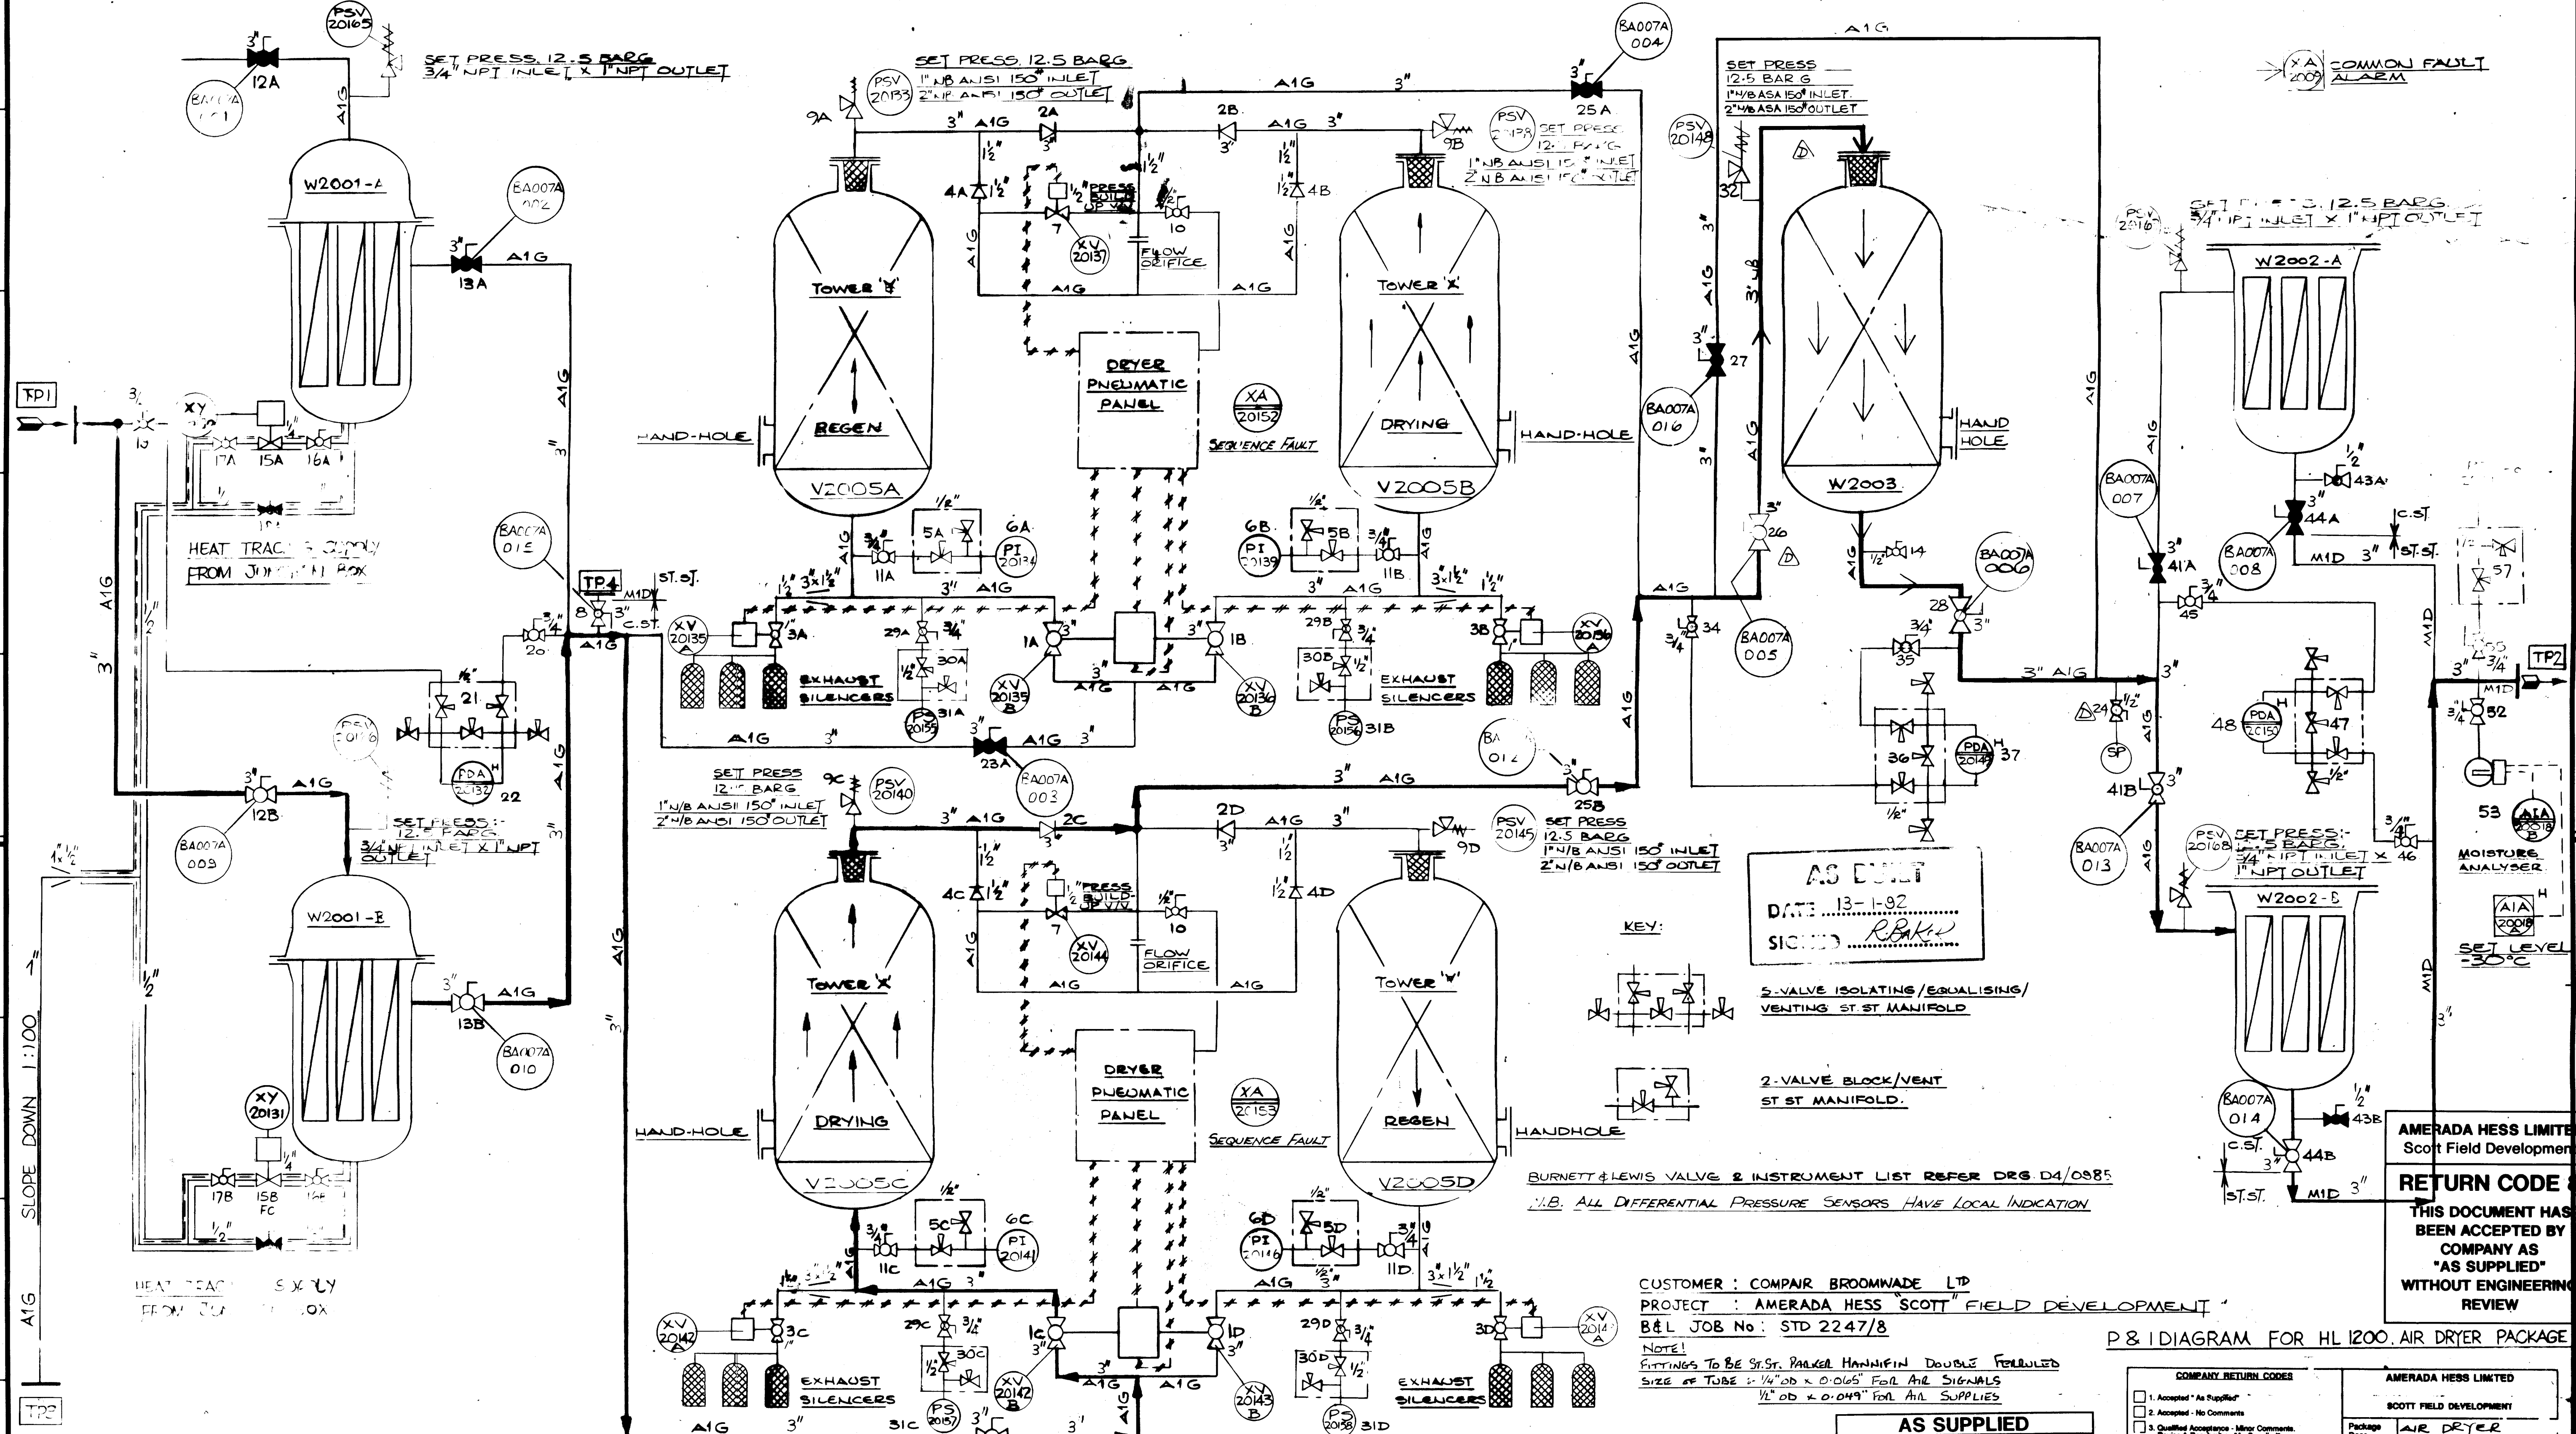

AS BUILT  
DATE 13-1-92  
SIGNED R. B. K.

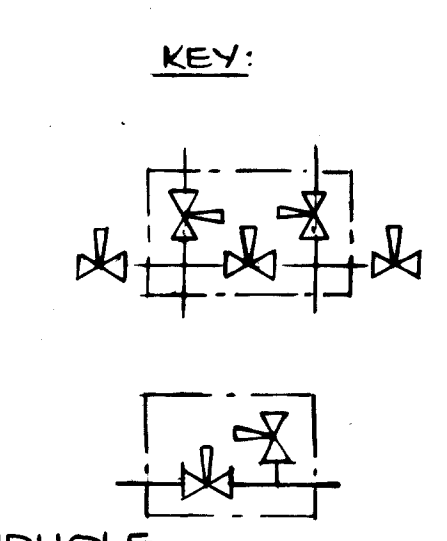

BURNETT & LEWIS VALVE & INSTRUMENT LIST REFER DRG D4/0585  
N.B. ALL DIFFERENTIAL PRESSURE SENSORS HAVE LOCAL INDICATION

CUSTOMER: COMPAIR BROOMWADE LTD  
PROJECT: AMERADA HESS SCOTT FIELD DEVELOPMENT  
B&L JOB No: STD 2247/8

NOTE:  
FITTINGS TO BE ST-ST PARKER HANFORD DOUBLE FEMALE  
SIZE OF TUBE 1/4" OD x 0.049" FOR AIR SIGNALS  
1/4" OD x 0.049" FOR AIR SUPPLIES

CONNECTION SCHEDULE			
REF	SIZE	DESCRIPTION	CONNECTION
TP1	3" NB	AIR INLET	FLANGED ANSI 150# R.F.
TP2	3" NB	INSTRUMENT AIR OUTLET	FLANGED ANSI 150# R.F.
TP3	1" NB	CONDENSATE DRAIN	FLANGED ANSI 150# R.F.
TP4	3" NB	PLANT AIR INLET	FLANGED ANSI 150# R.F.

DRYER CYCLE: TOTAL TIME 10 MINS  
ADSORPTION TIME: 5 MINS.  
REGEN TIME: 5 MINS.

EQUIPMENT No.:	MY 2002
DESCRIPTION:	INSTRUMENT AIR DRYER PACKAGE
SIZE:	HL 1200
DESIGN TEMP.:	60°C / MINUS 10°C
OPERATING TEMP.:	40°C
DESIGN PRESS.:	12.5 BARG
OPERATING PRESS.:	10.5 BARG

AS SUPPLIED  
Seller shall complete both Sections A & B, sign & date  
A All Company comments on previous submission have been fully incorporated  
B There are no design changes, other than incorporation of Company comments, from previous submission  
Seller's Verifying Statement:  
This document accurately represents the "As Supplied" condition of the Work  
Sellers Authorised Signature: [Signature]  
Date: 13-1-92

COMPANY RETURN CODES  
1. Accepted - As Supplied  
2. Accepted - No Comments  
3. Qualified Acceptance - Minor Comments  
4. Qualified Acceptance - Minor Comments  
5. Qualified Acceptance - Minor Comments  
6. Rejected - Revises & Resubmits Immediately  
7. Review Not Required  
AMERADA HESS LIMITED  
SCOTT FIELD DEVELOPMENT  
Package Desc: AIR DRYER PACKAGE  
Equip No: MY 2002  
SORS Codes: D01  
Module: 011  
Purchase Order No: [Blank]  
Document No: [Blank]  
Date: 16-11-90  
Scale: [Blank]

REF	REVISION	REF	REVISION	REF	REVISION	REF	REVISION	REF	REVISION
E	1/4" DRIP PIPEWORK ADDED TO SUB AS-BUILT G.A. SILENCERS WERE 1/4" R.B.	D	3" AS-BUILT FLOW NOW ENTERS CARBON FILTER THROUGH TOP NOZZLE.	C	3" SET PRESS ADDED TO 1" NB ANSI 150# INLET 2" NB ANSI 150# OUTLET. 2" NB VALVE NOS ADDED IN BUBBLES.	B	3" PACKAGE SIZE WAS HL1200 R.V.S ADDED TO FILTERS CUSTOMER COMMENTS ADDED AS PER M.D.P.	A	3" CUSTOMER'S COMMENTS INCORPORATED PER REVISED B&L JOB NO. 2247/8.

COPYRIGHT: THIS DRAWING AND DESIGN IS THE PROPERTY OF BURNETT & LEWIS LTD. AND IS CONFIDENTIAL. IT MUST NOT BE LOANED, COPIED OR OTHERWISE COMMUNICATED TO A THIRD PARTY WITHOUT PERMISSION. AND IS SUBJECT TO RECALL AT ANY TIME.

DRAWN R.B. CHECKED [Signature] DATE 16-11-90 SCALE [Blank]

BURNETT & LEWIS LTD. ALDRIDGE WEST MIDLANDS.

ISSUED DRG. No. D2/176-E