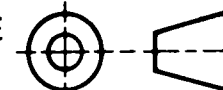
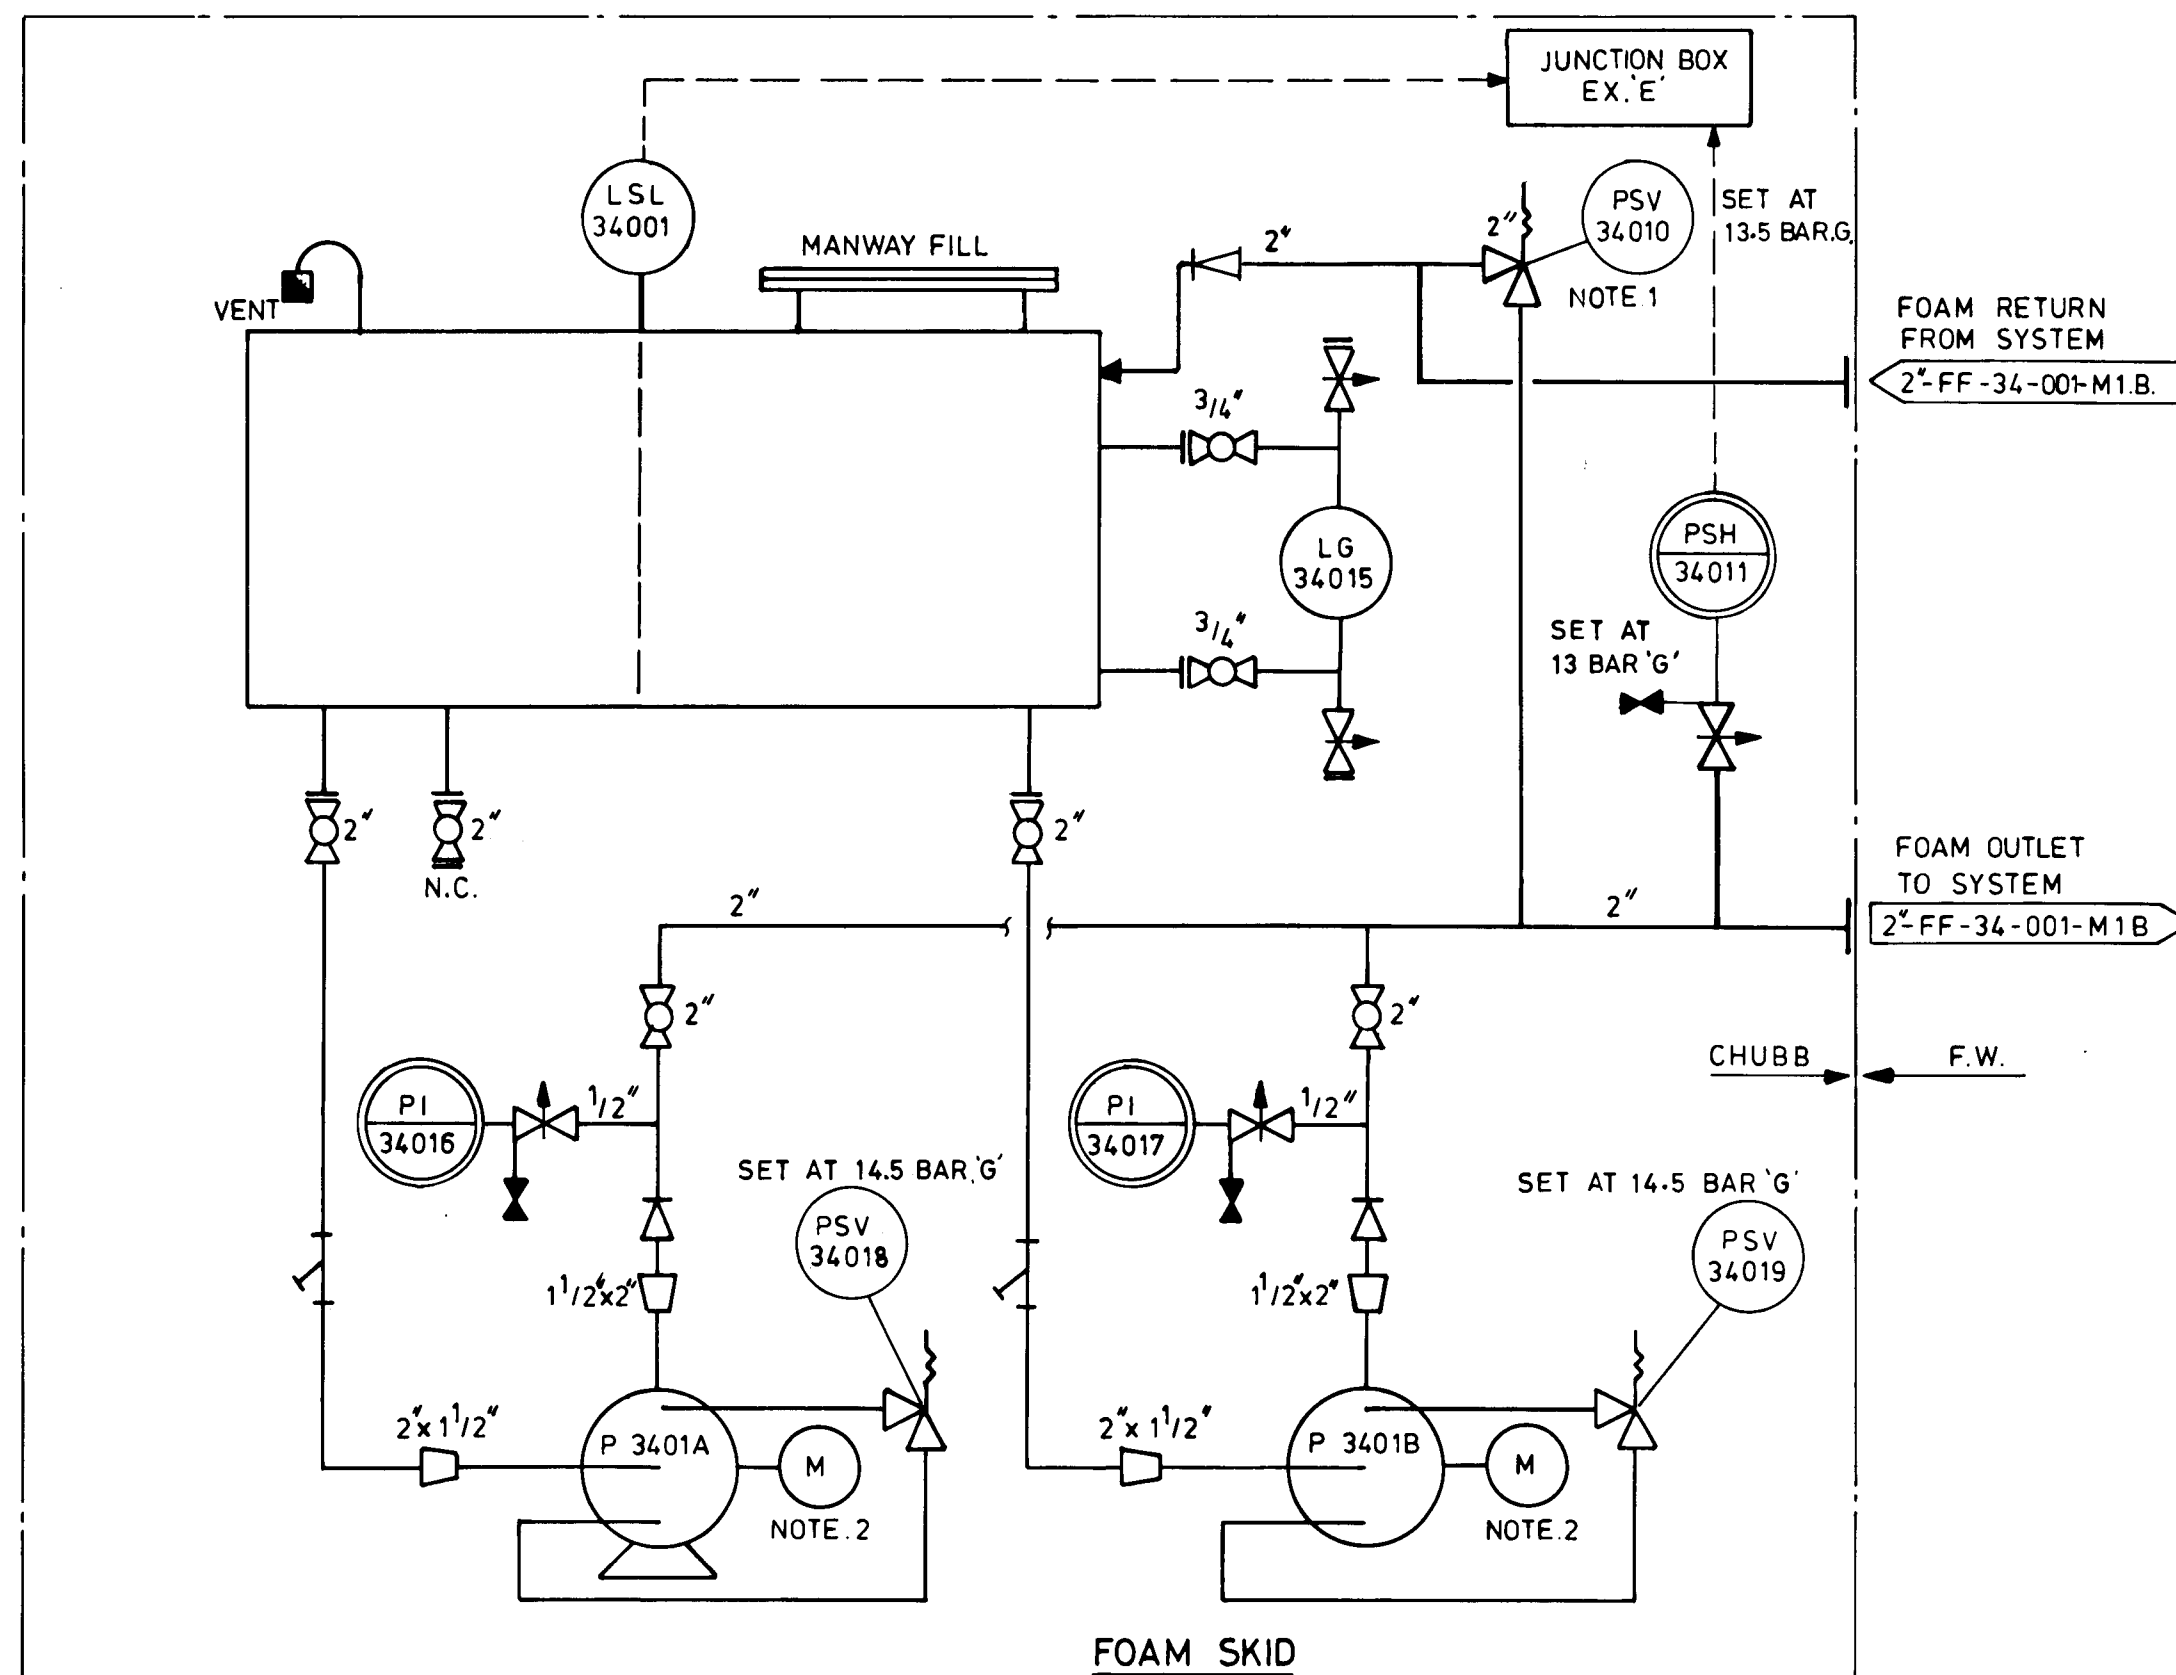


DRG. No. 12259-K-01

A2

**CHUBB FIRE ENGINEERING.**Lancaster Road, Cressex Industrial Estate,
High Wycombe, Bucks. HP12 3QF, England.
Tel: (0494) 441114 Telex: 83560 CNF Fax: (0494) 31710CHUBB FIRE ENGINEERING. OWNS THE
COPYRIGHT OF THIS DRAWING WHICH IS
SUPPLIED IN CONFIDENCE AND WHICH MUST
NOT BE USED FOR ANY PURPOSE OTHER
THAN THAT FOR WHICH IT IS SUPPLIED AND
MUST NOT BE REPRODUCED WITHOUT
PERMISSION IN WRITING FROM THE OWNERS.FIRST YEAR OF
PUBLICATION
19THIRD ANGLE
PROJECTION813-042441-01-1T
813042441011**NOTES**

1. RELIEF LINE TO BE SET AT LOW LEVEL.
2. LOCAL MOTOR START/STOP BUTTONS AND LOCAL/REMOTE BUTTONS TO BE SUPPLIED, AND MOUNTED OFF SKID BY OTHERS.

AMERADA HESS LIMITED
Scott Field Development**RETURN CODE 8**
THIS DOCUMENT HAS
BEEN ACCEPTED BY
COMPANY AS
"AS SUPPLIED"
WITHOUT ENGINEERING
REVIEW**AS SUPPLIED**

Seller shall complete both Sections A & B, sign & date	
A	All Company comments on previous submission have been fully incorporated <input checked="" type="checkbox"/> Yes <input type="checkbox"/> No <input type="checkbox"/> Not Applicable
B	There are no design changes, other than incorporation of Company comments, from previous submission <input checked="" type="checkbox"/> Yes <input type="checkbox"/> No
Seller's Verifying Statement: This document accurately represents the "As Supplied" condition of the Work	
Seller's Authorised Signature: <i>B. J. J. J.</i>	Date: 10.6.92

COMPANY RETURN CODES		AMERADA HESS LIMITED	
<input type="checkbox"/> 1. Accepted - "As Supplied"		SCOTT FIELD DEVELOPMENT	
<input type="checkbox"/> 2. Accepted - No Comments		Package Desc	FOAM SKID
<input type="checkbox"/> 3. Qualified Acceptance - Minor Comments. Revise & Resubmit as "As Supplied" Work May Proceed		Equip Nos	LF-3401
<input type="checkbox"/> 4. Qualified Acceptance - Minor Comments. Revise & Resubmit To Obtain Code 2 Work May Proceed		SORS Codes	Do 1
<input type="checkbox"/> 5. Qualified Acceptance - Major Comments. Revise & Resubmit To Obtain Code 2 Work May Proceed		Module	P130
<input type="checkbox"/> 6. Rejected - Revise & Resubmit Immediately Work May Not Proceed In The Affected Areas		Purchase Order No	001001013
<input type="checkbox"/> 7. Review Not Required		Current No	
Company's Signature:		Rev	
Date:		Sheet 1 of 1	

REVISIONS
DETAILS/SIGNATURE/DATE

ISS No.	1	2	3
INITIAL ISSUE	14.12.90		
DRG. NO. 12259-K-01			
CLIENT'S COMMENTS INCORPORATED.			
N.J. JAN 91.			
(3) JAN 91.			
AS SUPPLIED			
20-1-92.			

SITE

SCOTT FIELD
DEVELOPMENT

CLIENT

AMERADA HESS LIMITED

SO. No. 12259

MATERIAL

FINISH

TITLE

P&I. DIAGRAM FOR FOAM SKID.
EQUIPMENT N° LF-3401ALL DIMENSIONS IN M/METRES. M/C FINISH
REMOVE ALL BURRS AND SHARP EDGES GEN. TOL. ± 0.4 MM

SCALE: N.T.S. DRAWN: N.J. 11-12-90

ENGR. TRACED

APPVD. R. J. J. J. CHKD. (3) DEC 90

USED ON PRODUCT

DRG. No. 12259-K-01

A2

ISSUE 1/2/3