

710296/201-4

TO/FROM 710296/201-3

FOR NOTES REFER TO DRG. 710296/201-1  
SEQ-1222-ME-01-C01-0001  
FOR PARTS LIST REFER TO DOC. SEQ-1222-ME-01-C13-0004

TP SCHEDULE

TP56	1/2" PARKER A-LOK B/H	INJECTION LINE S
TP57	1/2" PARKER A-LOK B/H	INJECTION LINE T
TP58	1/2" PARKER A-LOK B/H	INJECTION LINE U
TP59	1/2" PARKER A-LOK B/H	INJECTION LINE V
TP61	1/2" PARKER A-LOK B/H	INJECTION LINE W
TP62	1/2" PARKER A-LOK B/H	INJECTION LINE X
TP36	1" 150lb RF FLANGE	DRIP TRAY DRAIN



ISSUED FOR APPROVAL

ORIGINAL  
IF RED

Review of supplier's data does not relieve supplier of responsibility for correctness under terms of contract.


CODE	COMMENT	ACTION REQUIRED	MANUFACTURE
F	ACCEPTED	DO NOT RE-SUBMIT UNLESS DATA IS MODIFIED	MAY PROCEED
A	ACCEPTED WITH COMMENT	FULLY INCORPORATE COMMENTS & RE-SUBMIT DOCUMENTS	MAY PROCEED
B	REJECTED	FULLY INCORPORATE COMMENTS & RE-SUBMIT DOCUMENTS	MUST NOT PROCEED
I	INFORMATION ONLY	NO IMPACT ON MANUFACTURE. DO NOT RE-SUBMIT	MAY PROCEED

SIRL Code: C01

Purchase Document No:  
SEQ-1222-ME-01-C01-0004

Purchase Revision:  
04

Client Review Signature: *[Signature]*

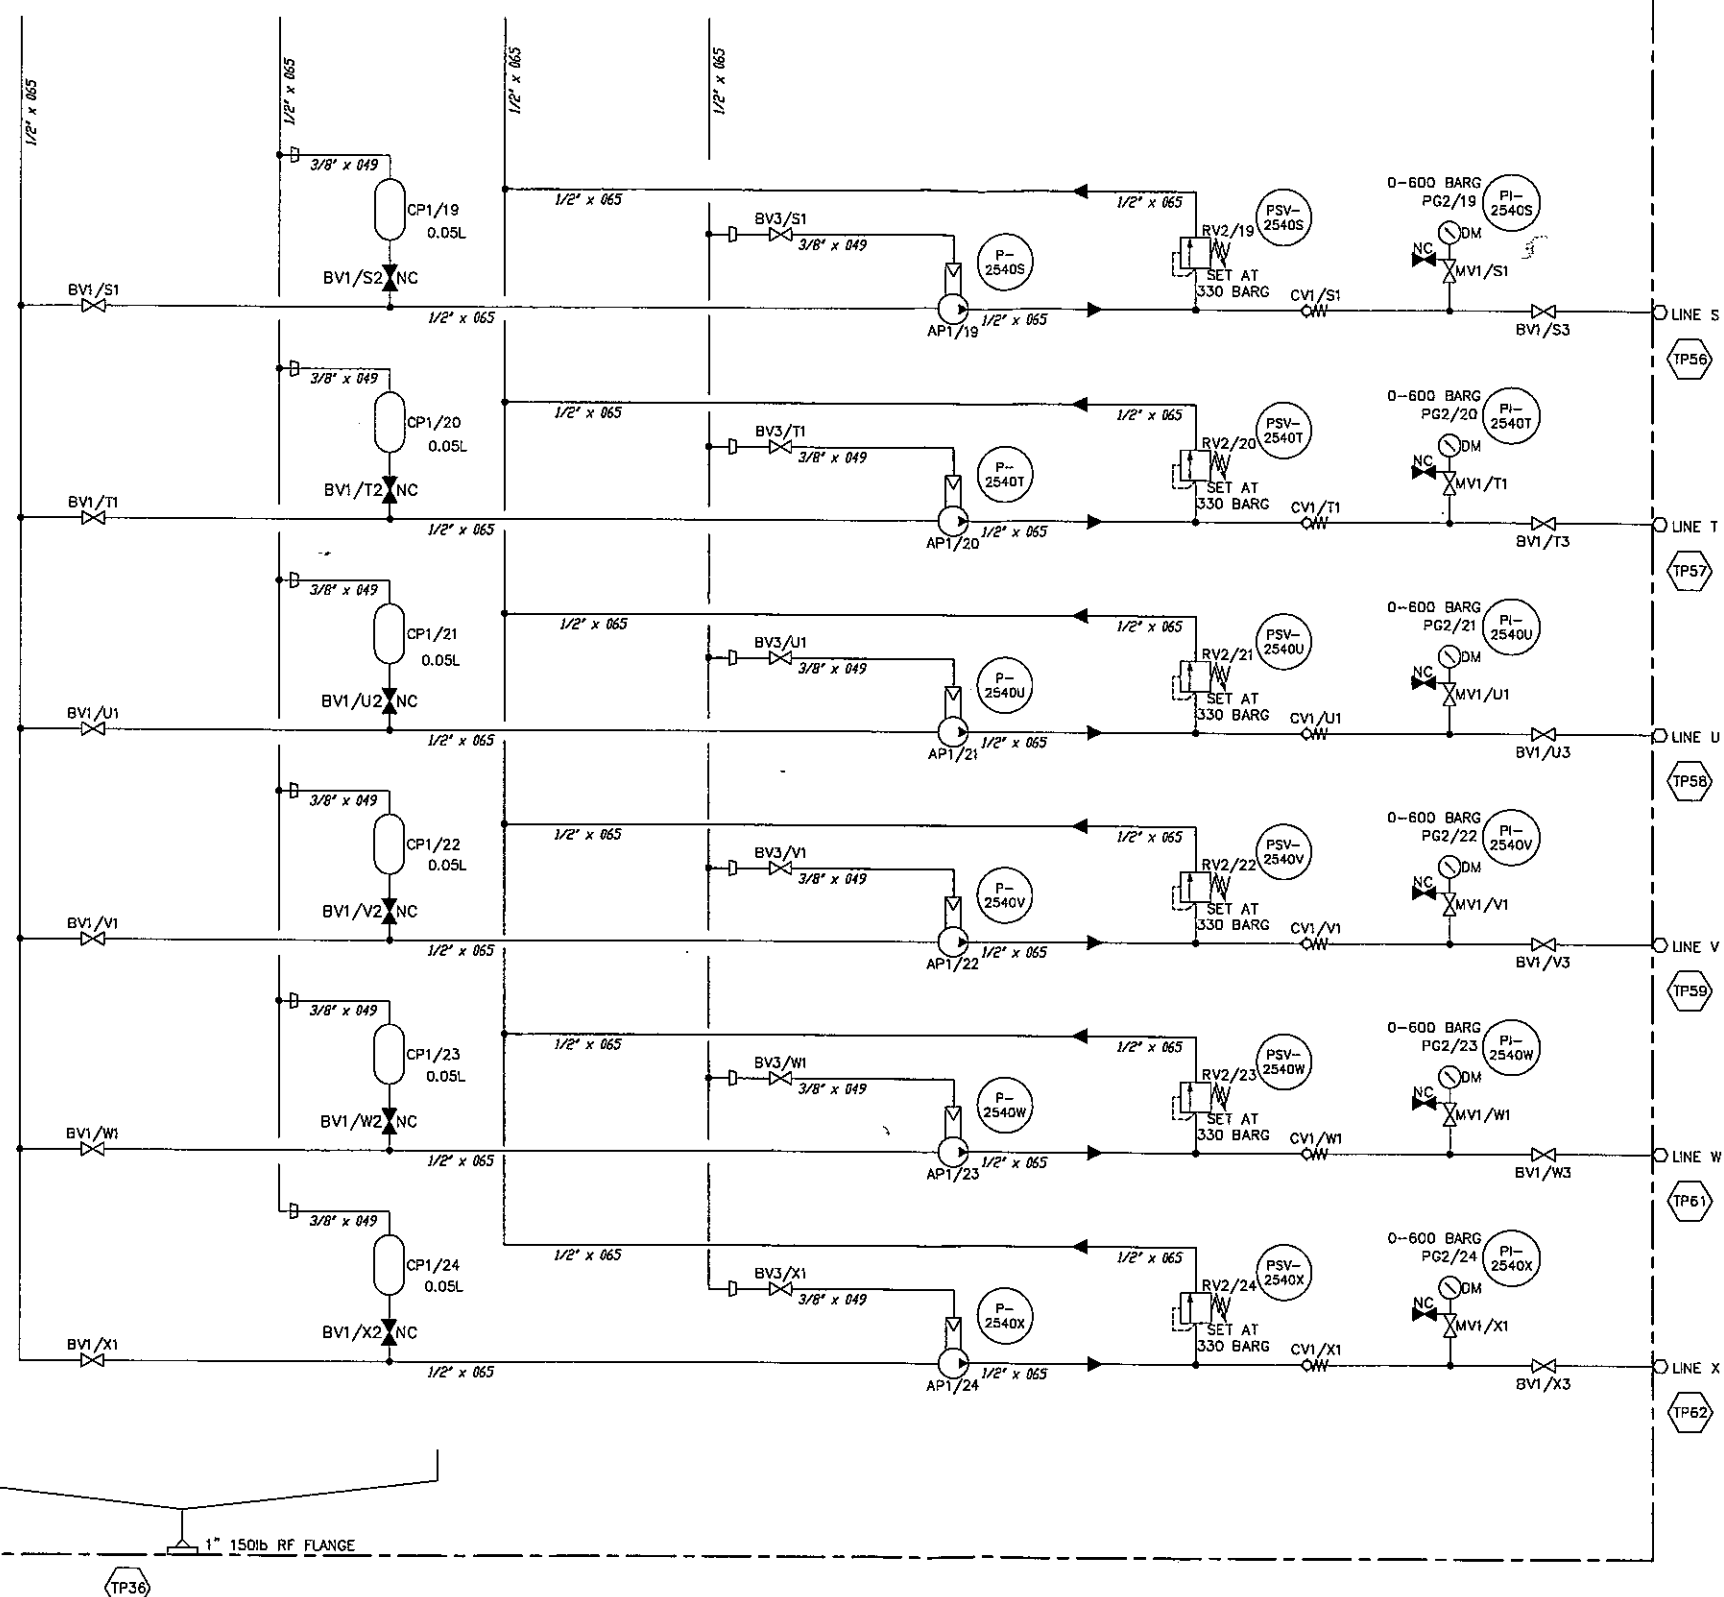

Rev	A	1	2	3
Description	ISSUED FOR APPROVAL	REVISED & ISSUED FOR MANUFACTURE	REVISED & RE-ISSUED FOR MANUFACTURE C.S.No.2282	REVISED & ISSUED 'AS BUILT' C.S.No.2298
Date Orig App	31/8/06 LD	18/10/06 AD SC	2/11/06 AD SC	21/11/06 AD SC

IF IN DOUBT ASK

This drawing is confidential and copyright property of Tyco Fire & Integrated Solutions and must not be copied or lent without their written permission.

Sig	Date
Orig LD	31/8/06
Chd SC	27/09/06
App MW	27/09/06

**tyco**  
Fire & Integrated Solutions

Oil & Gas/Marine  
Jarrod Way, Bowthorpe,  
Norwich, Norfolk  
NR5 5JD England

Tel: +44 (0) 1603 201201  
Fax: +44 (0) 1603 201333  
www.tycofs.com

Project: AKER KVAERNER SCOTT PLATFORM  
SCALE INHIBITOR PACKAGE MY-2540  
Drawing Title: P & I.D.

Contract No.: WN710296

Drg No: 710296/201-4

Rev 3