


PROBE	FUNCTION	INTERFACE	ACTION
SD2	SPEED SENSOR	MODULE H, RAIL 11	ALARM SHUTDOWN
SD14	SPEED SENSOR	MODULE F, RAIL 11	SHUTDOWN
UD59	VIBRATION ACCEL	TERM RAIL 18	ALARM SHUTDOWN
UD61	VIBRATION ACCEL	TERM RAIL 18	ALARM SHUTDOWN

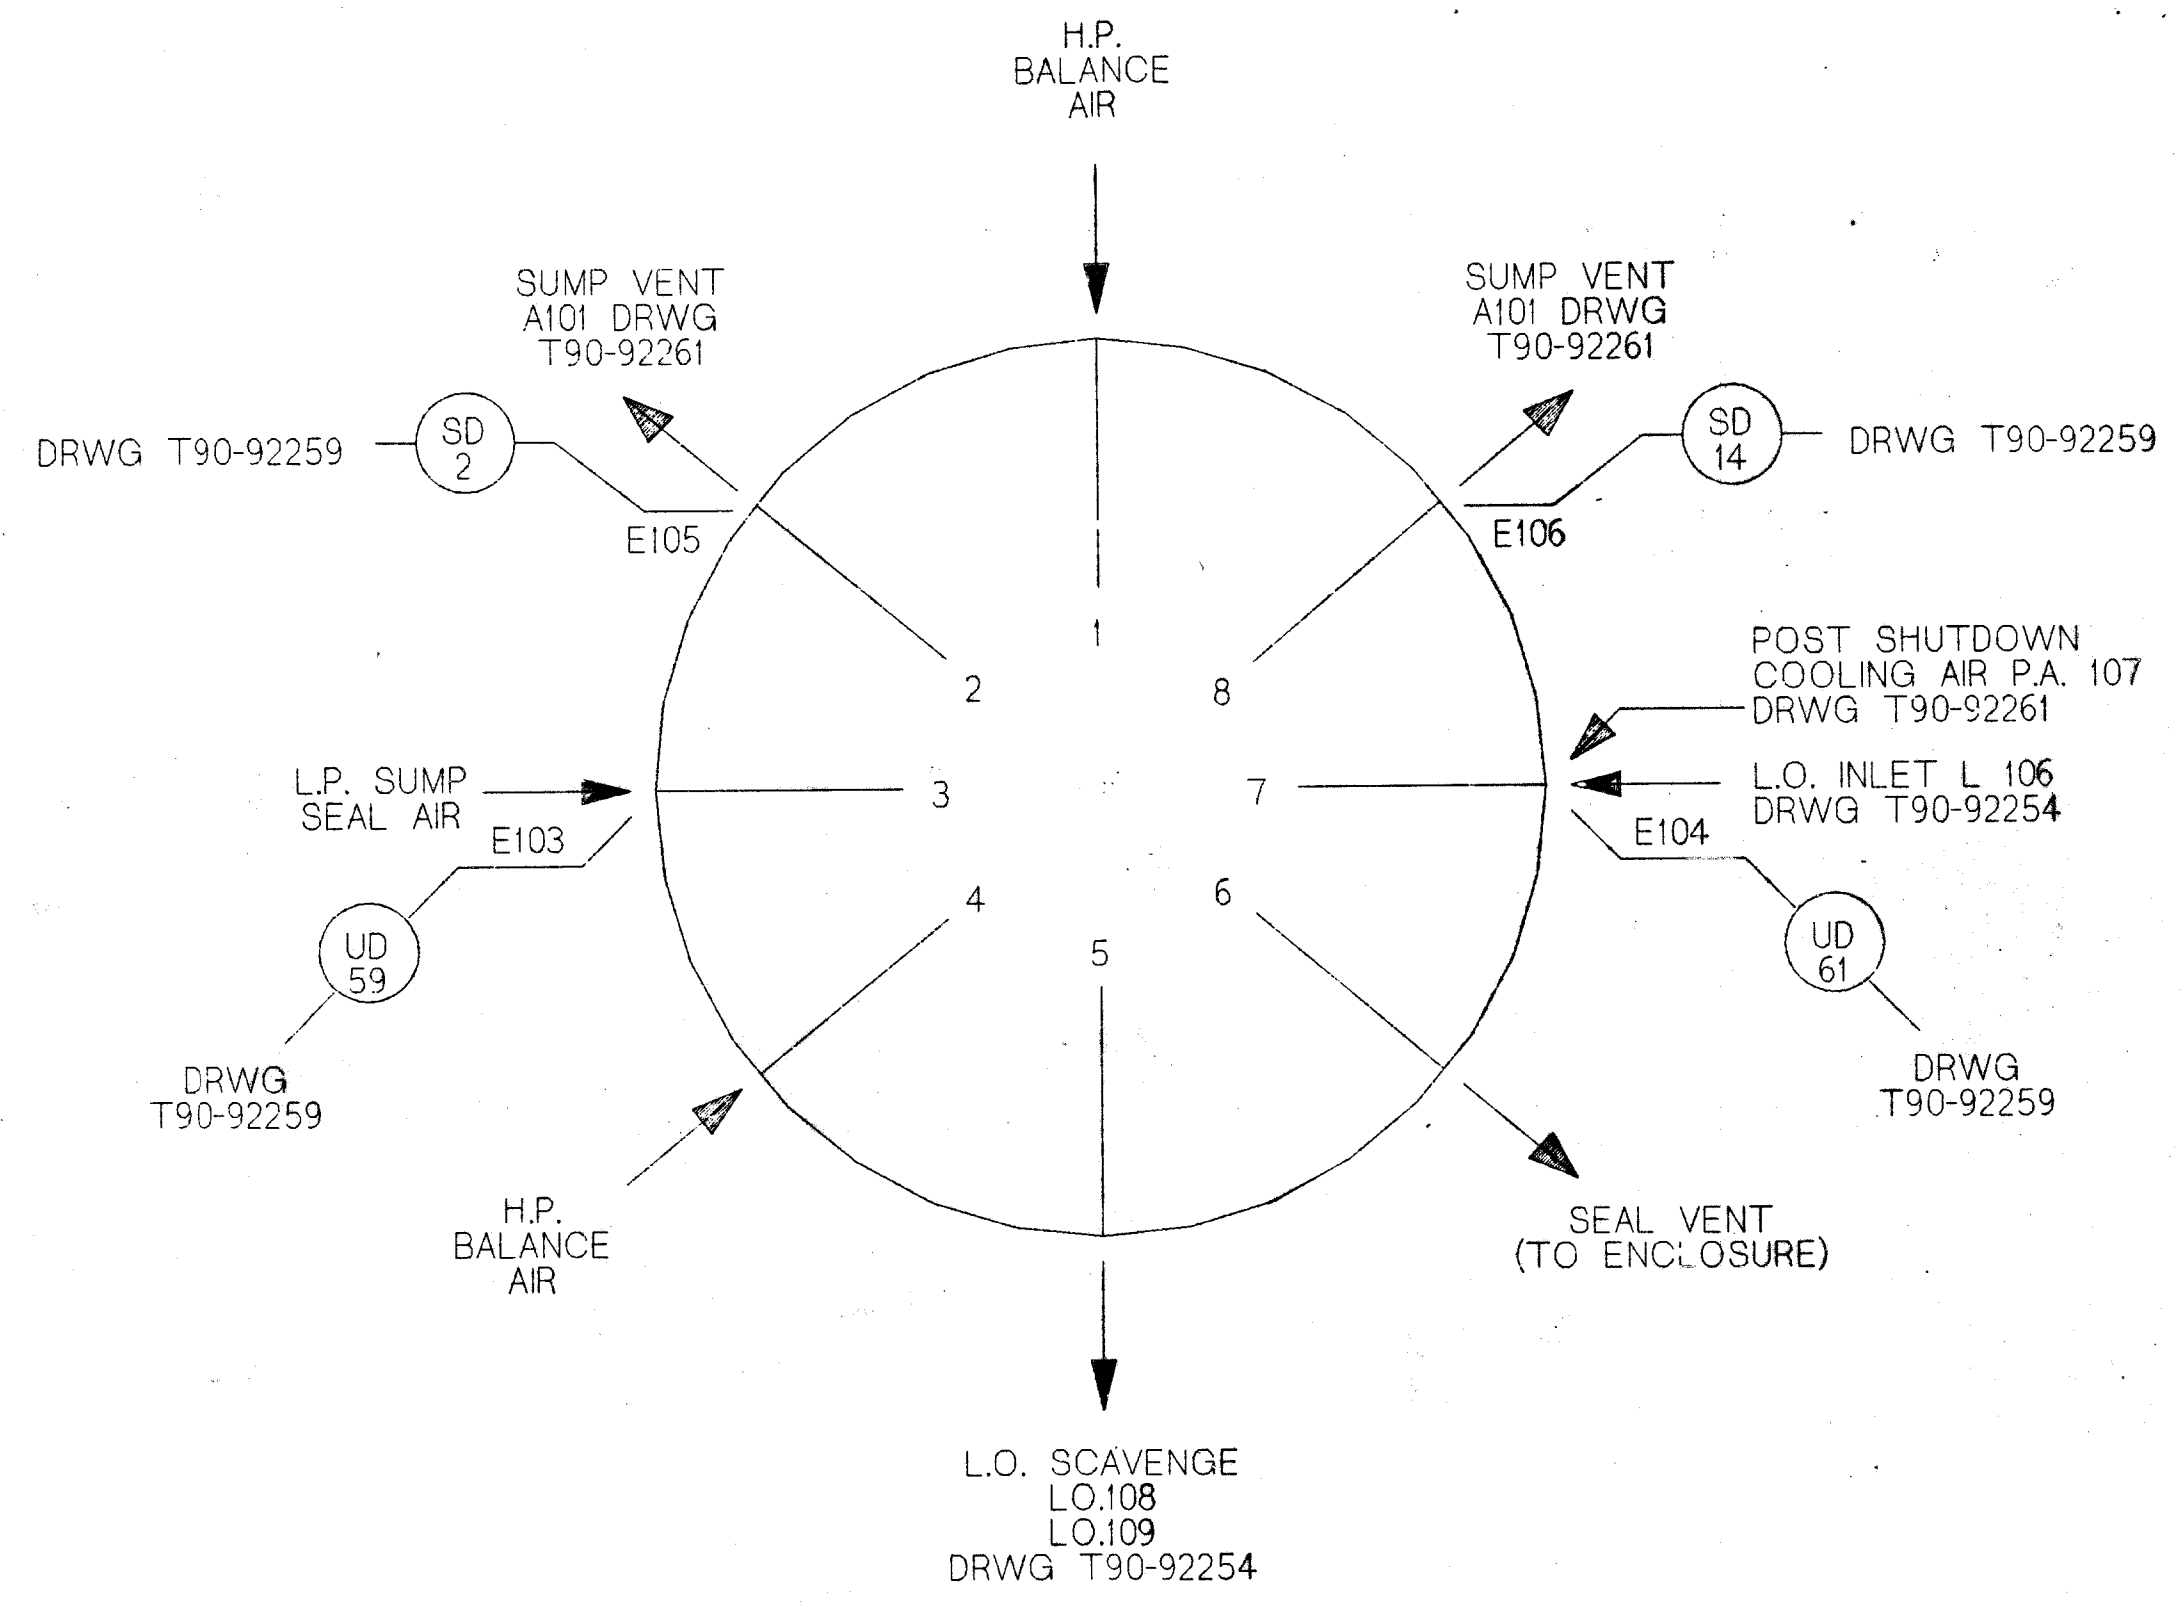

- NOTES
1. VIEW ON STRUTS LOOKING AFT
  2. STRUTS 1 & 4 FROM COMMON LINE FROM H.P. COMPRESSOR 8th STAGE.
  3. STRUTS 2 & 8 TO COMMON A101 INTERFACE
  4. STRUT 3 FROM L.P. COMPRESSOR
  5. WHERE NO DRAWING OR INTERFACE REFERENCE GIVEN, PIPING IS INTEGRAL
  6. ALL INTERFACES PIPED AND/OR WIRED BY RGT. NO CLIENT CONNECTIONS

AS SUPPLIED

Seller shall complete both Sections A & B along with date.

A) All Company comments on previous submission have been fully incorporated.

☒ Yes ☐ No ☐ Not Applicable

B) There are no design changes, other than incorporation of Company comments, from previous submission.

☒ Yes ☐ No

Seller's Verifying Statement:

This document accurately represents the "As Supplied" condition of the Work.

Seller Authorized Signature: *[Signature]* Date: 1-7-92

COMPANY RETURN CODES		AMERADA HESS LIMITED	
<input checked="" type="checkbox"/> 1. Accepted "As Supplied"		SCOTT FIELD DEVELOPMENT	
<input type="checkbox"/> 2. Accepted - No Comments		Package Desc:	MAIN GENERATION PACKAGE
<input type="checkbox"/> 3. Qualified Acceptance - Minor Comments. Revise & Resubmit as "As Supplied". Work May Proceed		Equip Nos:	GY 4701 A/B/C
<input type="checkbox"/> 4. Qualified Acceptance - Minor Comments. Revise & Resubmit To Obtain Code 2. Work May Proceed		SORS Codes:	D.01
<input type="checkbox"/> 5. Qualified Acceptance - Major Comments. Revise & Resubmit To Obtain Code 2. Work May Proceed		Module:	UI
<input type="checkbox"/> 6. Rejected - Revise & Resubmit Immediately. Work May Not Proceed In The Affected Area		Purchase Order No:	P0001
<input type="checkbox"/> 7. Review Not Required		Document No:	D.010.062
Company Signature: <i>[Signature]</i> Date: 10/1/92		Rev:	02

3	1-1-92	RB	C67635	AS SUPPLIED DRAWING
2	1-7-92	MD	C 66171	NOTE 6 ADDED
1	1-5-91	AK	G20922F	DRAWING ISSUED
PRE LIM.				
ISS.	DATE	ENG	CAD	FORM N°
ENGINEER.				AJKELLAM
DRAWN				M.DEALTRY
CHECKED.				AKELLAM
EXAMINED.				B.BUCKTHORPE
DATE.				1-5-91
				DESCRIPTION
				LATEST ISSUE CANCELS ALL PREVIOUS ISSUES.
				IF IN DOUBT ASK

ORDER NO. X 049/01-03

CUSTOMERS REFERENCE. AMERADA HESS

SYMBOLS USED IN THIS SCHEMATIC DIAGRAM ARE, WHERE APPLICABLE, IN ACCORDANCE WITH RUSTON GAS TURBINES LTD., LINCOLN ENGLAND.

TITLE. RLM 5000 POWER TURBINE INTERFACE P & I.D.

DRAWING NO. T90-92660

SHEET 1 OF 1