

COMMON TEMPERATURE ALARM
TAH 11739

COMMON TEMPERATURE TRIP
TAHH 11740

QTY	MAKE FROM / MATERIAL	WT KG	QTY	SYMBOL	DESCRIPTION	PT
			#	C065380A000	VIBRATION AND TEMPERATURE SCHEMATIC	000

- LOCAL INSTRUMENT
- EQUIPMENT CONTROL PANEL, FRONT
- EQUIPMENT CONTROL PANEL, REAR

DELAVAL-STORK V.O.F.

THIS DRAWING IS FOR:

- ☐ INFORMATION ONLY
- ☐ APPROVAL PRIOR TO MANUFACTURE OR PURCHASE OF MATERIAL (REQUIRED BY TO ASSURE MAINTAINING PRESENT SCHEDULE.)
- ☐ RECORD APPROVAL ONLY
- ☐ FINAL DISTRIBUTION
- ☐ CERTIFIED FINAL DISTRIBUTION
- ☒ AS BUILT

DATE: 30-1-92
SIGN:

AMERADA HESS LIMITED
Scott Field Development

RETURN CODE 8

THIS DOCUMENT HAS BEEN ACCEPTED BY COMPANY AS "AS SUPPLIED" WITHOUT ENGINEERING REVIEW

AS SUPPLIED

Seller shall complete both Sections A & B, sign & date

A All Company comments on previous submission have been fully incorporated

☐ Yes ☐ No ☒ Not Applicable

B There are no design changes, other than incorporation of Company comments, from previous submission

☒ Yes ☐ No

Seller's Verifying Statement:
This document accurately represents the "As Supplied" condition of the Work

Sellers Authorised Signature: [Signature] Date: 29-01-92

END-USER : AMERADA HESS LTD.
CONTRACTOR : FOSTER WHEELER LTD.
LOCATION : SCOTT FIELD
PURCHASE ORDER NO. : T200-ME-RM-0302-P002
DLS ORDER NO. : LC0653

COMPANY RETURN CODES		AMERADA HESS LIMITED SCOTT FIELD DEVELOPMENT	
<input type="checkbox"/> 1 Accepted "As Supplied"		Package Desc	COMPRESSOR PACKAGE LP/IP CENTRIFUGAL
<input type="checkbox"/> 2 Accepted - No Comments		Equip Nos	CT 1101 B
<input type="checkbox"/> 3 Qualified Acceptance - Minor Comments Review & Resubmit to Obtain Code 2 Work May Proceed		SERS Codes	DD1
<input type="checkbox"/> 4 Qualified Acceptance - Minor Comments Review & Resubmit to Obtain Code 2 Work May Proceed		Module	
<input type="checkbox"/> 5 Qualified Acceptance - Major Comments Review & Resubmit to Obtain Code 2 Work May Proceed		Purchase Order No	
<input type="checkbox"/> 6 Rejected - Review & Resubmit Immediately Work May Not Proceed in The Affected Area		Document No	
<input type="checkbox"/> 7 Review Not Required		Rev	

Company's Signature: Date: 29-01-92

CHG	ZONE	ALTERATIONS	DATE	BY	CHK	WHY	M/C

SEE A7822.001 FOR DRAFTING SYSTEM USED
SEE A0621.2 FOR TOL'S ETC. NOT SPECIFIED

DRAWN : AVK 8-91 REF. DWG.:
CHK. : G.M. 19-9-91 SCALE: --

ENGCHK. : SHEETNO. 1 OF 9
IDCHK. : PROJ. METHOD
ISSUED : CAD DRAWING SIZE A2

DELAVAL-STORK

TITLE: VIBRATION AND TEMPERATURE SCHEM. LP/IP COMPRESSOR 'B'

DRW NO. C065380A000


DELAVAL STORK HENGLO (OV) NETHERLANDS

A
B

B
C

D
E

E
F

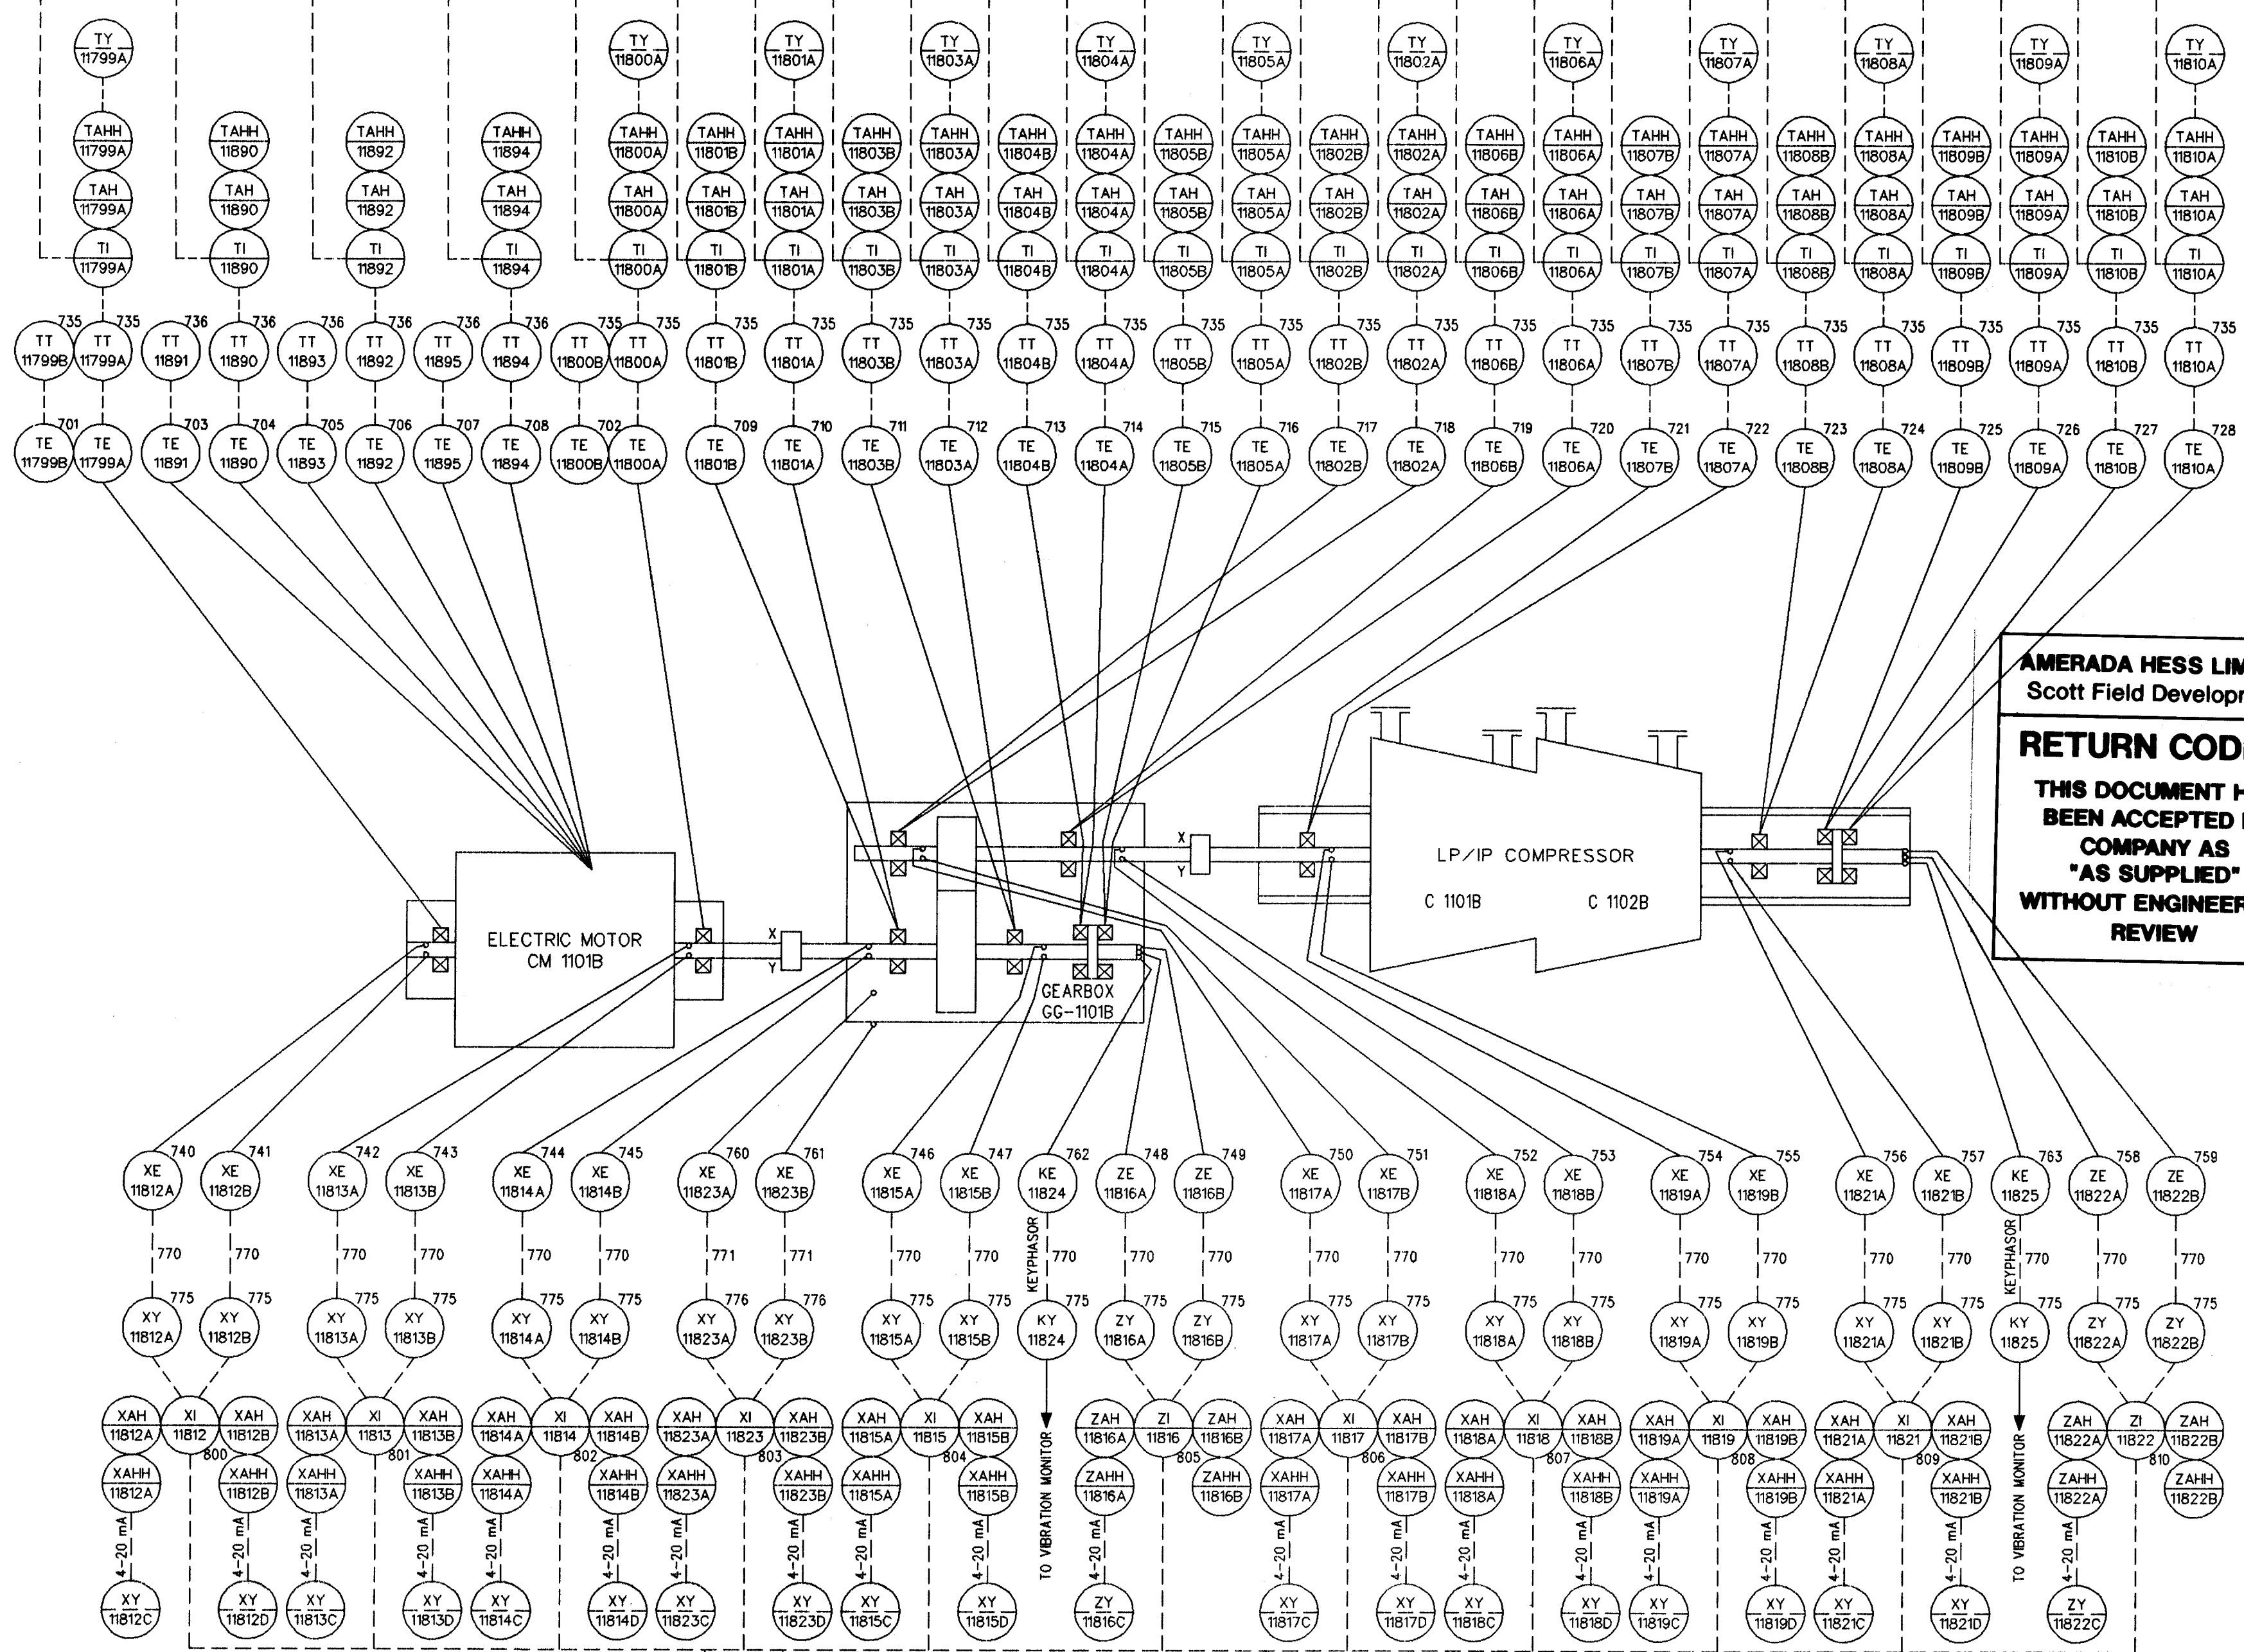

COMMON VIBRATION ALARM
XAH 11529

COMMON VIBRATION TRIP
XAHH 11530