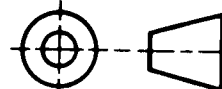
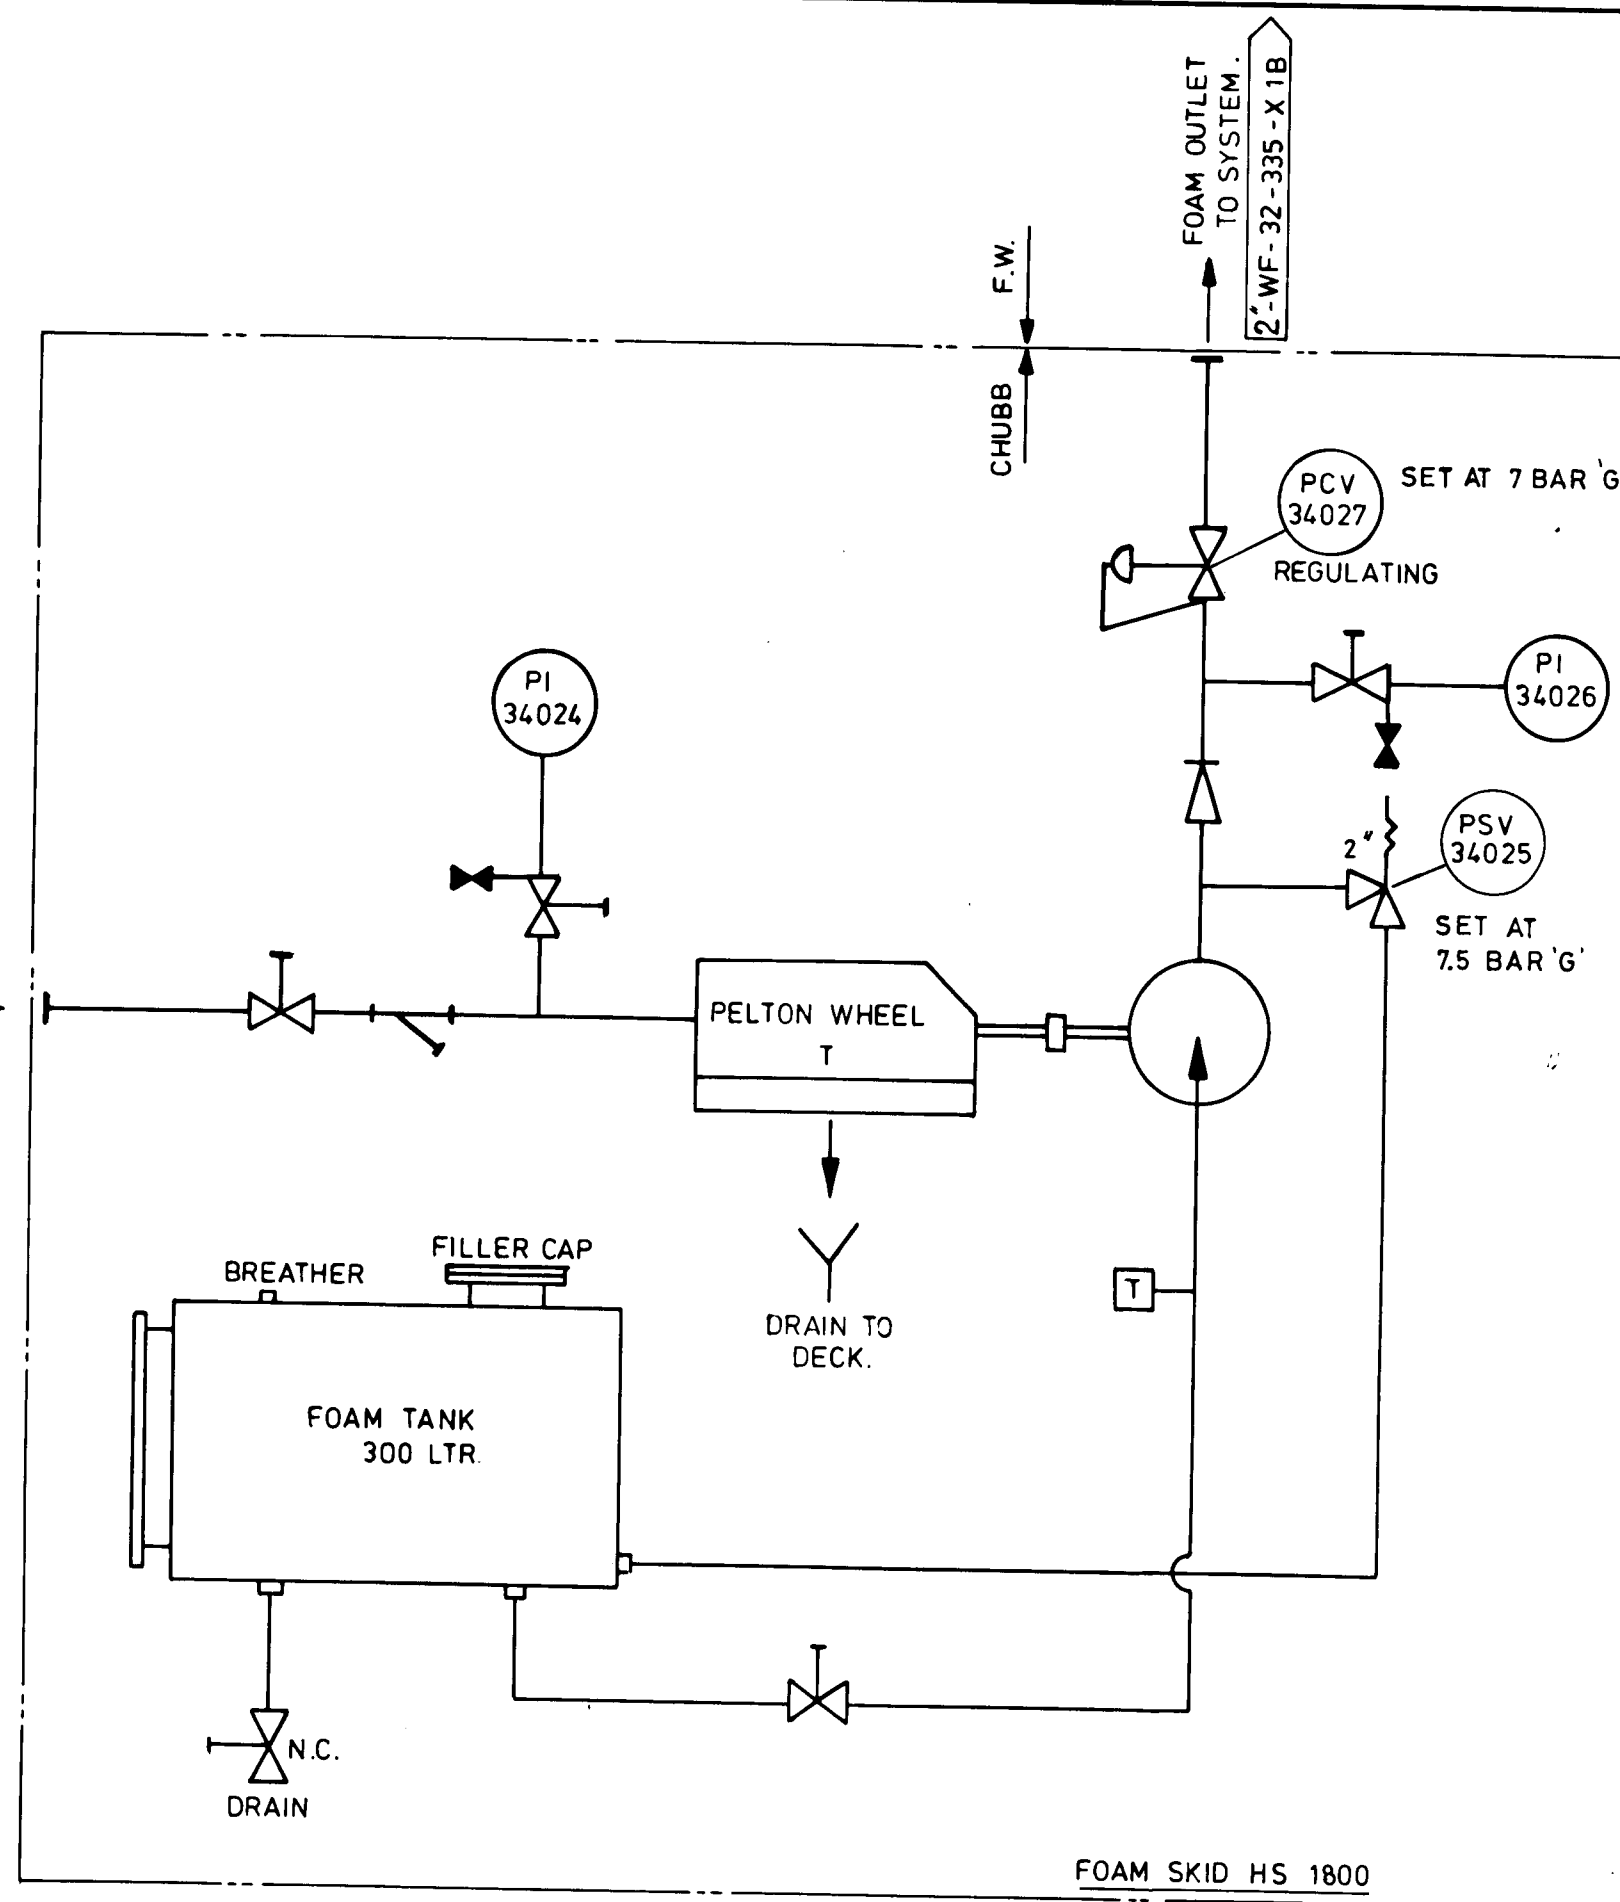


DRG. No. 12259-K-03

A2

**CHUBB FIRE ENGINEERING**Lancaster Road, Cressex Industrial Estate,
High Wycombe, Bucks. HP12 3QF, England.
Tel: (0494) 441114 Telex: 83560 CNF Fax: (0494) 31710CHUBB FIRE ENGINEERING OWNS THE
COPYRIGHT OF THIS DRAWING WHICH IS
SUPPLIED IN CONFIDENCE AND WHICH MUST
NOT BE USED FOR ANY PURPOSE OTHER
THAN THAT FOR WHICH IT IS SUPPLIED AND
MUST NOT BE REPRODUCED WITHOUT
PERMISSION IN WRITING FROM THE OWNERS.FIRST YEAR OF
PUBLICATION
19THIRD ANGLE
PROJECTIONSEAWATER INLET
TO PELTON WHEEL.
2" WF-32-131-X1BAMERADA HESS LIMITED
Scott Field Development**RETURN CODE 8****THIS DOCUMENT HAS
BEEN ACCEPTED BY
COMPANY AS
"AS SUPPLIED"
WITHOUT ENGINEERING
REVIEW****AS SUPPLIED**

Seller shall complete both Sections A & B, sign & date

A All Company comments on previous submission
have been fully incorporated
☒ Yes ☐ No ☐ Not Applicable**B** There are no design changes, other than
incorporation of Company comments, from
previous submission
☒ Yes ☐ NoSeller's Verifying Statement:
This document accurately represents the "As Supplied"
condition of the WorkSellers Authorised Signature: B. Welford Date: 10.6.92**COMPANY RETURN CODES**

- ☐ 1. Accepted "As Supplied"
- ☐ 2. Accepted - No Comments
- ☐ 3. Qualified Acceptance - Minor Comments.
Revise & Resubmit as "As Supplied"
Work May Proceed
- ☐ 4. Qualified Acceptance - Minor Comments.
Revise & Resubmit To Obtain Code 2
Work May Proceed
- ☐ 5. Qualified Acceptance - Major Comments.
Revise & Resubmit To Obtain Code 2
Work May Proceed
- ☐ 6. Rejected - Revise & Resubmit Immediately
Work May Not Proceed In The Affected
Areas
- ☐ 7. Review Not Required

Company's
Signature: _____ Date: _____**AMERADA HESS LIMITED****SCOTT FIELD DEVELOPMENT**

Package Desc	FOAM SKID		
Equip No	LF-3402 B		
SDRS Codes	D01		
Module	L160	Sheet 1 of 1	
Purchase Order No	P0130	Document No	D 01013 013
Rev			

REV	ISS	DATE	SIGNATURE
1	1	14-12-90	
2	2	06-01-91	
3	3	06-01-92	

SITE

SCOTT FIELD
DEVELOPMENT.

CLIENT

AMERADA HESS LIMITED

SO. No. 12259

MATERIAL

FINISH

TITLE

P&I. DIAGRAM FOR FOAM SKID (H.S.1800)
EQUIPMENT N° LF-3402 BALL DIMENSIONS IN MILLIMETRES. M/C FINISH \pm 0.4 MM
REMOVE ALL BURRS AND SHARP EDGES GEN. TOL. \pm 0.4 MM

SCALE: N.T.S. DRAWN: N.J. 13-12-90

ENGR. TRACED

APPVD. B. Welford CHKD. B. Welford 28-90

USED ON PRODUCT

DRG. No. 12259-K-03

A2

ISSUE 1/2/3