


P-5223A - 0.37kW
P-5223B - 0.37kW

JB4/1
NON IS ANALOGUE
PSD
JUNCTION BOX
Ex e

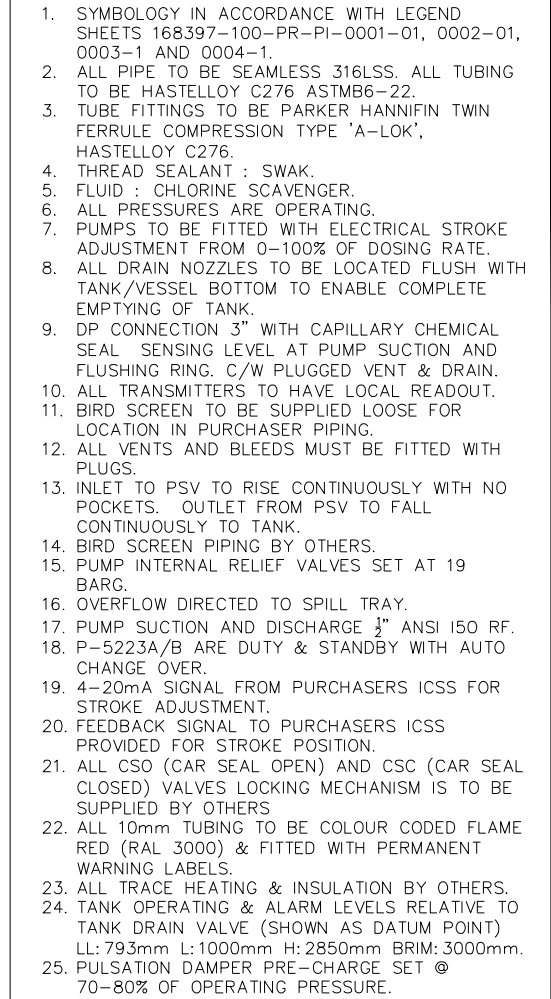

X-5201 TIE-IN SCHEDULE					
TIE-IN No	TANK No	SIZE	RATING	FLANGE	SERVICE
TP3	—	2"	150#	RF	DECANTING PLATFORM INLET
TP10	—	2"	150#	RF	CHLORINE SCAVENGER VENT
TP17	—	1/2"	150#	RF	CHLORINE SCAVENGER OUTLET
TP31	—	2"	150#	RF	SPILL TRAY

Nexen Petroleum (U.K.) Limited						
VENDOR : TYCO (AS-BUILT BY AMEC FW)						
EQUIPMENT TITLE : CHEMICAL INJECTION PACKAGE (WATER INJECTION) – CHLORINE SCAVENGER						
EQUIPMENT TAG NO(S) : X-5201						
Vendor Document Number						
Purchase Order Number	Doc Code	Seq. No	Rev.	DATE		
168397-100-PO-3366	MC2	013	Z3	21/06/21		
SUPPLIER DOCUMENT REVIEW						
Rejected (Assai Code – REJ) – Quality and content is out of conformity with Requirements. Documents shall be revised by Supplier to incorporate the necessary changes and subsequently re-submitted.						
Accepted With Comments (Assai Code – AWC) – Generally acceptable but elements require to be addressed. Document shall be revised by Supplier to incorporate the necessary changes and subsequently re-submitted.						
Accepted As Final (Assai Code – FIN) – Documents are considered acceptable, do not re-submit.						
Accepted For Information (Assai Code – AFI) – No further action required, do not re-submit.						
Review of Vendor documents does not relieve Vendor of the responsibility for correctness under the Purchase Order. Permission to proceed does not constitute acceptance of design, detail and calculations, test methods or materials developed or selected by the Vendor and/or does not relieve the Vendor from full compliance with the Purchase Order and any other obligations, not detract from any of the Purchaser's rights.						
Z3	21/06/21	AS-BUILT AS PER GIC0098	TF	JL	JL	TR
REV	DATE	DESCRIPTION	DRN	CHK	APP	CLT

[illegible]