


CY-1103B  
HP COMPRESSOR PACKAGE

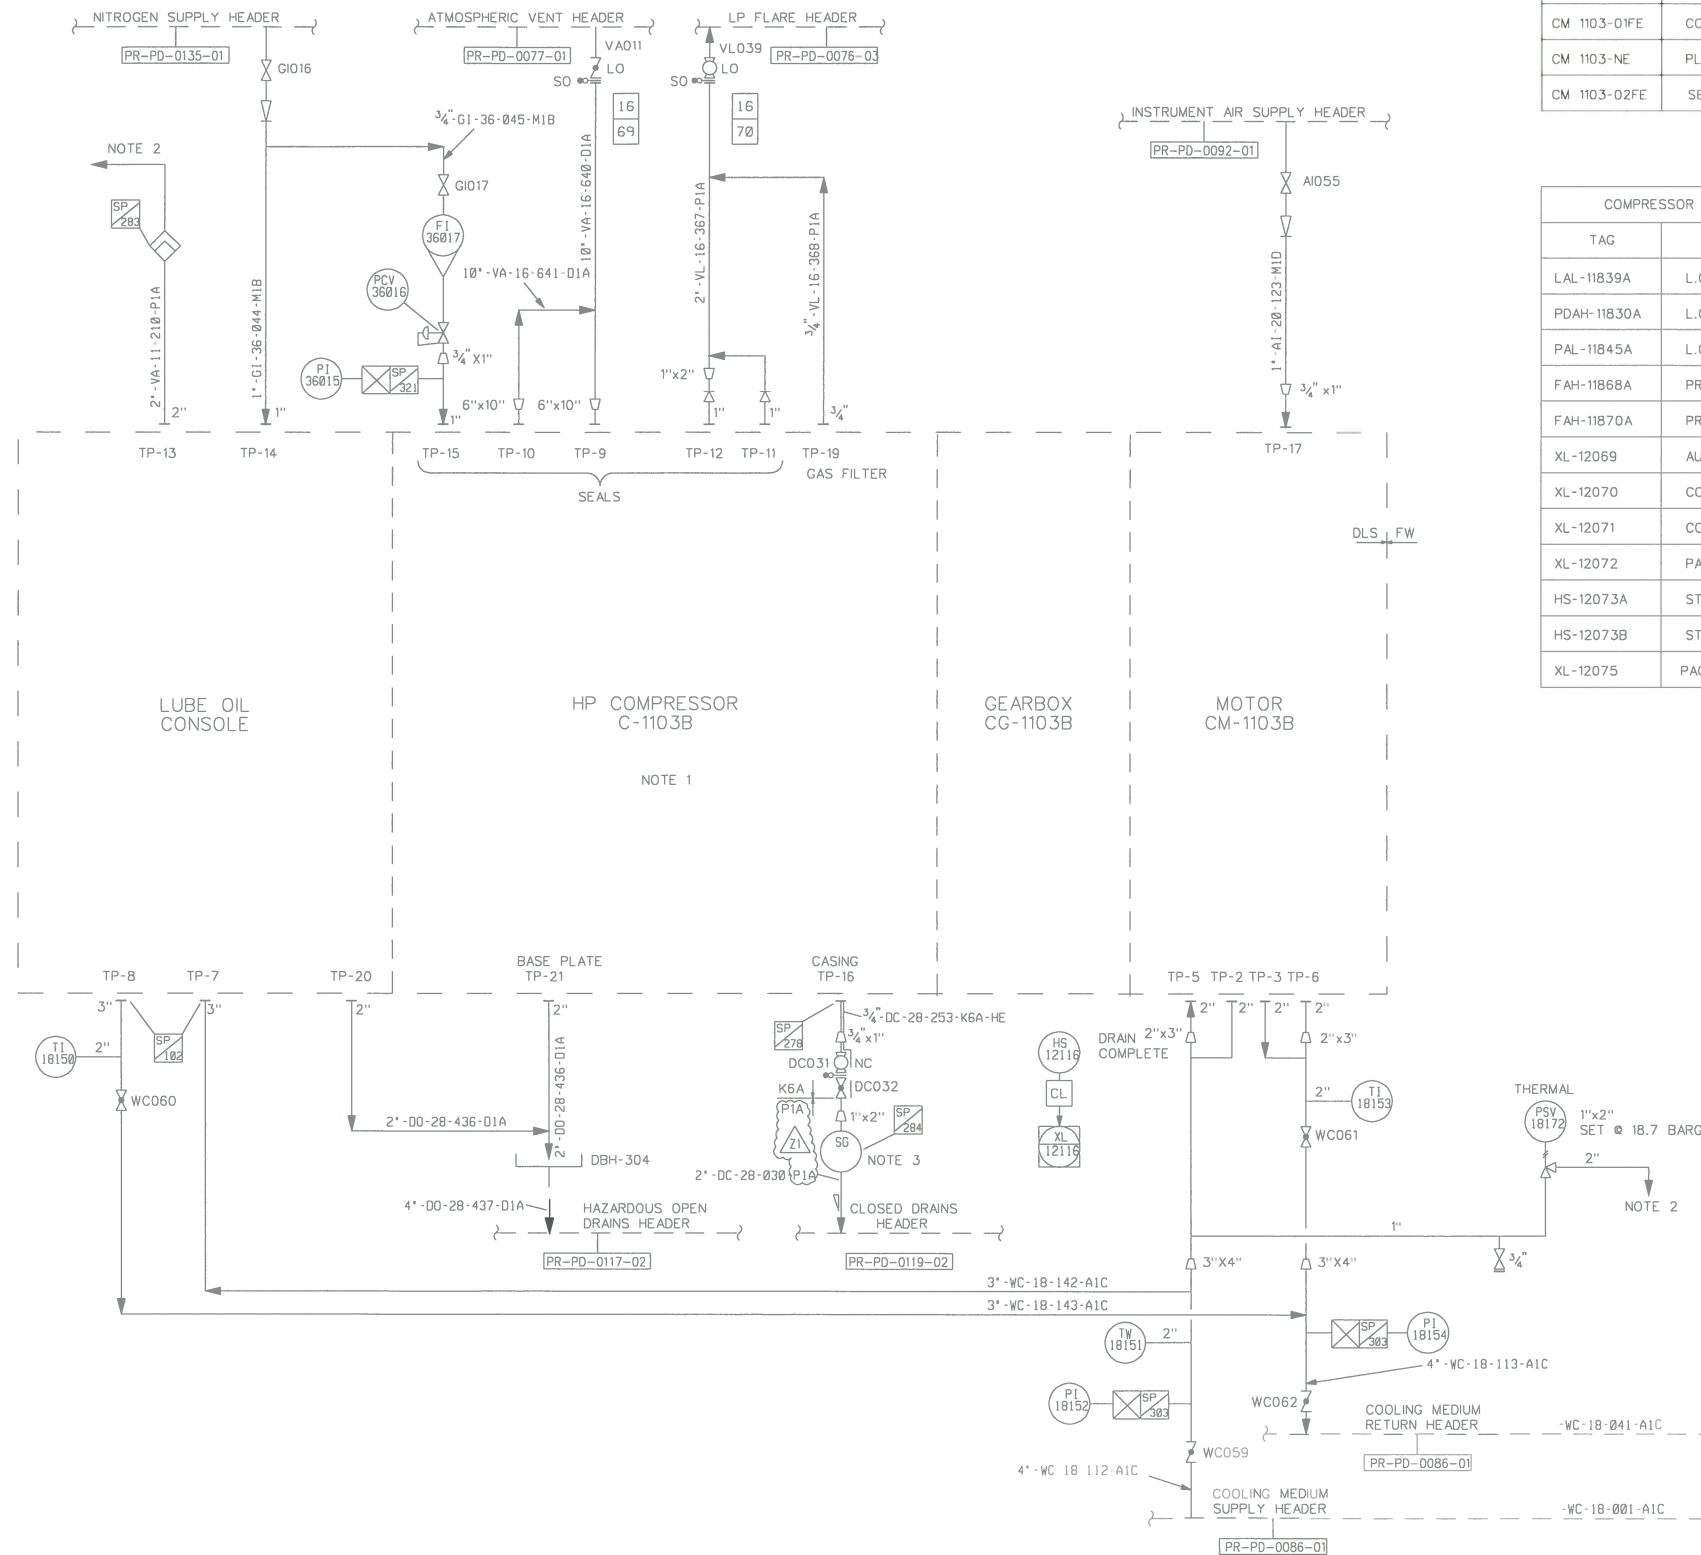

COMPRESSOR UCP SIGNALS TO/FROM ESD	
TAG	DESCRIPTION
CM 1103-01FE	COMPRESSOR MACHINERY PROTECTION
CM 1103-NE	PLATFORM E.S.D.
CM 1103-02FE	SEAL FAILURE

COMPRESSOR UCP SIGNALS TO/FROM DCS	
TAG	DESCRIPTION
LAL-11839A	L.O. RESERVOIR
PDAH-11830A	L.O. FILTER
PAL-11845A	L.O. HEADER
FAH-11868A	PRIMARY SEAL FAILURE D.E.
FAH-11870A	PRIMARY SEAL FAILURE N.D.E.
XL-12069	AUXILIARIES RUNNING
XL-12070	COMMON FAULT ALARM
XL-12071	COMMON TRIP ALARM
XL-12072	PACKAGE AVAILABLE
HS-12073A	START AUXILIARIES
HS-12073B	STOP AUXILIARIES
XL-12075	PACKAGE/DCS START OF AUXILIARIES

NOTES

1. FOR DETAILS SEE DELAVAL STORK SCHEMATIC - P-0002-D-3002 & 3007.
2. VENT AT SAFE LOCATION.
3. SG IN VIEW FROM DRAIN VALVE.

ONLY ACTIVATED TRACE HEATING IS SHOWN ON P & ID, ALL OTHER INSTALLED TRACE HEATING IS NOT ACTIVATED AND NOT SHOWN ON P & ID.

FOR APPROVAL SIGNATURES SEE ARCHIVED DRAWING AT REV 0

REFERENCE DRAWINGS		13	UPDATED TO REFLECT SEQ-1080	12.12.03	GPG	SH	DB	MS	19.12.03
DRG.No.	REV	TITLE							
DCP 5000-297	ARN 2085 (EP 191)		12	AS BUILT TO INCLUDE DO 254	29.06.94	WN	GWM		
DCP 5000-729	ARN 3869 (EPJ 128)		11	AS COMMISSIONED	29.06.94	RTS	RM		KJH
DCP 5000-AH1054			4	REVISED TO LATEST INFORMATION	14.06.93				
			3	AS BUILT					
			2	REVISED FOR CONSTRUCTION	03.02.92				
REV	REASON FOR ISSUE		DATE	DRN.	CKD.	BY	ENG	L.E.	NEXEN
							CKD.	APPD	APPD

1	REVISED FOR CONSTRUCTION	11-10-91	DB						
0	APPROVED FOR CONSTRUCTION	7-6-91	-	GC	RT	JS	BAR	KTL	
DD	APPROVED FOR FINAL DESIGN	12-3-91	TER	GC	RT	JS	BAR	KTL	
CD	APPROVED FOR DESIGN	02-01-91	GP	GC	PDA	JS	BAR		
B	ISSUED FOR COMPANY REVIEW	16-10-90	GM	GC	PDA	JS			
Z1	AS-BUILT FOR SMOC1860	19/12/03	OD	EN	WJ	AL	AL		
REV	REASON FOR ISSUE		DATE	DRN.	CKD.	BY	ENG	L.E.	NEXEN
							CKD.	APPD	APPD

**nexen**  
Nexen Petroleum U.K. Limited

Scott House,  
Horeness Road, Altness,  
Aberdeen AB12 3LE  
Tel: (01224) 351100  
Fax: (01224) 351101

THIS IS A C.A.D. PRODUCED  
DRAWING AND SHOULD NOT  
BE MANUALLY MODIFIED

SCOTT	amec foster wheeler	
TITLE		
PIPING AND INSTRUMENT DIAGRAM AUXILIARY CONNECTIONS HP COMPRESSOR TRAIN B		
DRAWING No.		
SCOTT-FW-0000-PR-PD-0171-01		
Z1	NONE	
PROJECT	ORG	AREA/MOD
DISC	TYPE	SEQ. No.
SHT.	REV	SCALE