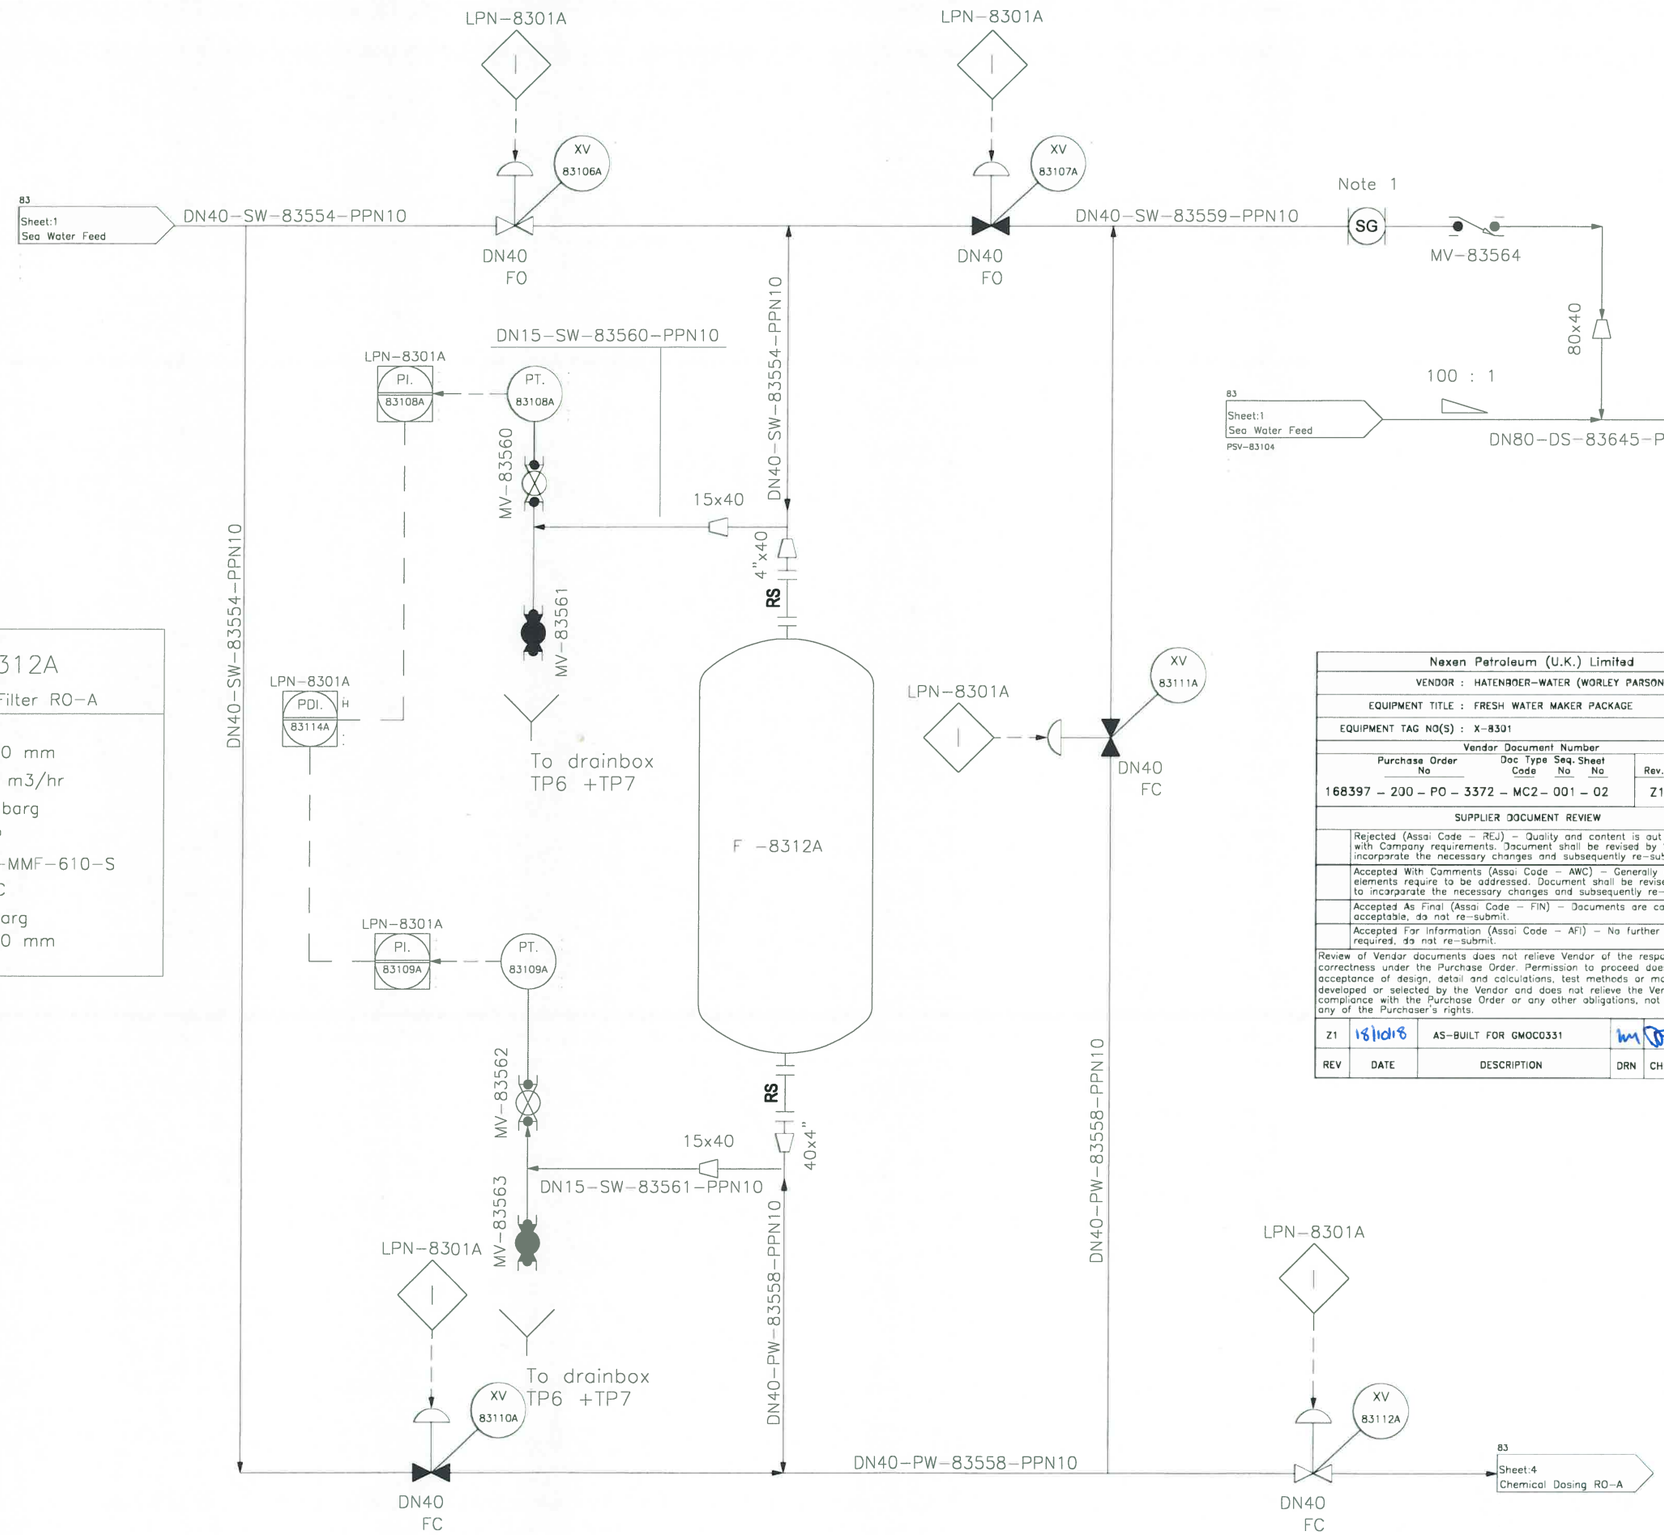

F -8312A

Multi Media Filter RO-A

Dimensions	: ø610 mm
Capacity	: 5.8 m3/hr
Design Press.	: 10 barg
Material	: GRP
Type	: HW-MMF-610-S
Design temp.	: 50°C
Operating pressure	: 5 barg
Tan to Tan	: 2460 mm

Nexen Petroleum (U.K.) Limited					
VENDOR : HATENBOER-WATER (WORLEY PARSONS)					
EQUIPMENT TITLE : FRESH WATER MAKER PACKAGE					
EQUIPMENT TAG NO(S) : X-8301					
Vendor Document Number					
Purchase Order No	Doc Type Code	Seq. No	Sheet No	Rev.	DATE
168397 – 200 – PO – 3372 – MC2 – 001 – 02				Z1	18/10/18
SUPPLIER DOCUMENT REVIEW					
Rejected (Assai Code – REJ) – Quality and content is out of conformity with Company requirements. Document shall be revised by Supplier to incorporate the necessary changes and subsequently re-submitted.					
Accepted With Comments (Assai Code – AWC) – Generally acceptable but elements require to be addressed. Document shall be revised by Supplier to incorporate the necessary changes and subsequently re-submitted.					
Accepted As Final (Assai Code – FIN) – Documents are considered acceptable, do not re-submit.					
Accepted For Information (Assai Code – AFI) – No further action required, do not re-submit.					
Review of Vendor documents does not relieve Vendor of the responsibility for correctness under the Purchase Order. Permission to proceed does not constitue acceptance of design, detail and calculations, test methods or materials developed or selected by the Vendor and does not relieve the Vendor from full compliance with the Purchase Order or any other obligations, not detract from any of the Purchaser's rights.					
Z1	18/10/18	AS-BUILT FOR GMOC0331			
REV	DATE	DESCRIPTION	DRN	CHK	APP	CLT

Nexen Petroleum U.K. Limited
Golden Eagle Area Development

Vendor: Hatenboer-Water BV
Equipment title: Fresh Water Maker Package
Equipment tag NO(S): X-8301

GEAD Document Number

PO Number	Doc Type Code	Seq. No	Rev.	Date
168397-200-PO-3372	MC2	001	10	13/10/2018

INCLUDES DOC CODES: TOTAL SHEETS: 16

F	Final (accepted)-Manufacturing may proceed.
A	Qualified Release-. revice and re-submit. Manufacturing may proceed subject to incorporation of comments
R	Rejected-revise and re-submit. Manufacturing may not proceed.
I	Accepted for information only

Review of Vendor documents does not relieve Vendor of the responsibility for correctness under the Purchase Order. Permission to proceed does not constitute acceptance of design, detail and calculations, test methods or materials developed or selected by the Vendor and does not relieve the Vendor from full compliance with the Purchase Order or any other obligations, nor detract from any of the Purchaser's rights.

Engineer: Date:

NOTES

Note1: Sight Glass

REV	DATE	DESCRIPTION	DRN	CHK	APP
9	27-06-13	ASBUILD	PR	LDG	PJ
8	06-05-13	ASBUILD	PR	LDG	PJ
7	06-02-13	ASBUILD	PR	LDG	PJ
6	14-11-12	ASBUILD	PR	LDG	PJ
5	24-10-12	AFTER COMMENTS	LDG	PR	LDG
4	06-07-12	AFTER COMMENTS	MdV	RU	LdG
3	03-05-12	AFTER COMMENTS	MdV	RU	LdG
2	18-01-12	AFTER COMMENTS	AO	RU	LDG
1	16-11-11	REV 1	RM	RU	LDG
0	14-09-11	FIRST ISSUE	AK	RU	LDG

DRAWING INFORMATION:
P&ID: 2
Description: MMF F-8312A
Drawn by: renmic
Date: 27/09/2018

HATENBOER - WATER

PROJECT INFORMATION:
Project: 458058
Client: Nexen
Client Ref: Package Golden Eagle
Description: PO 3372

Drawing number: | Sheet: 2/16 | Rev: 9