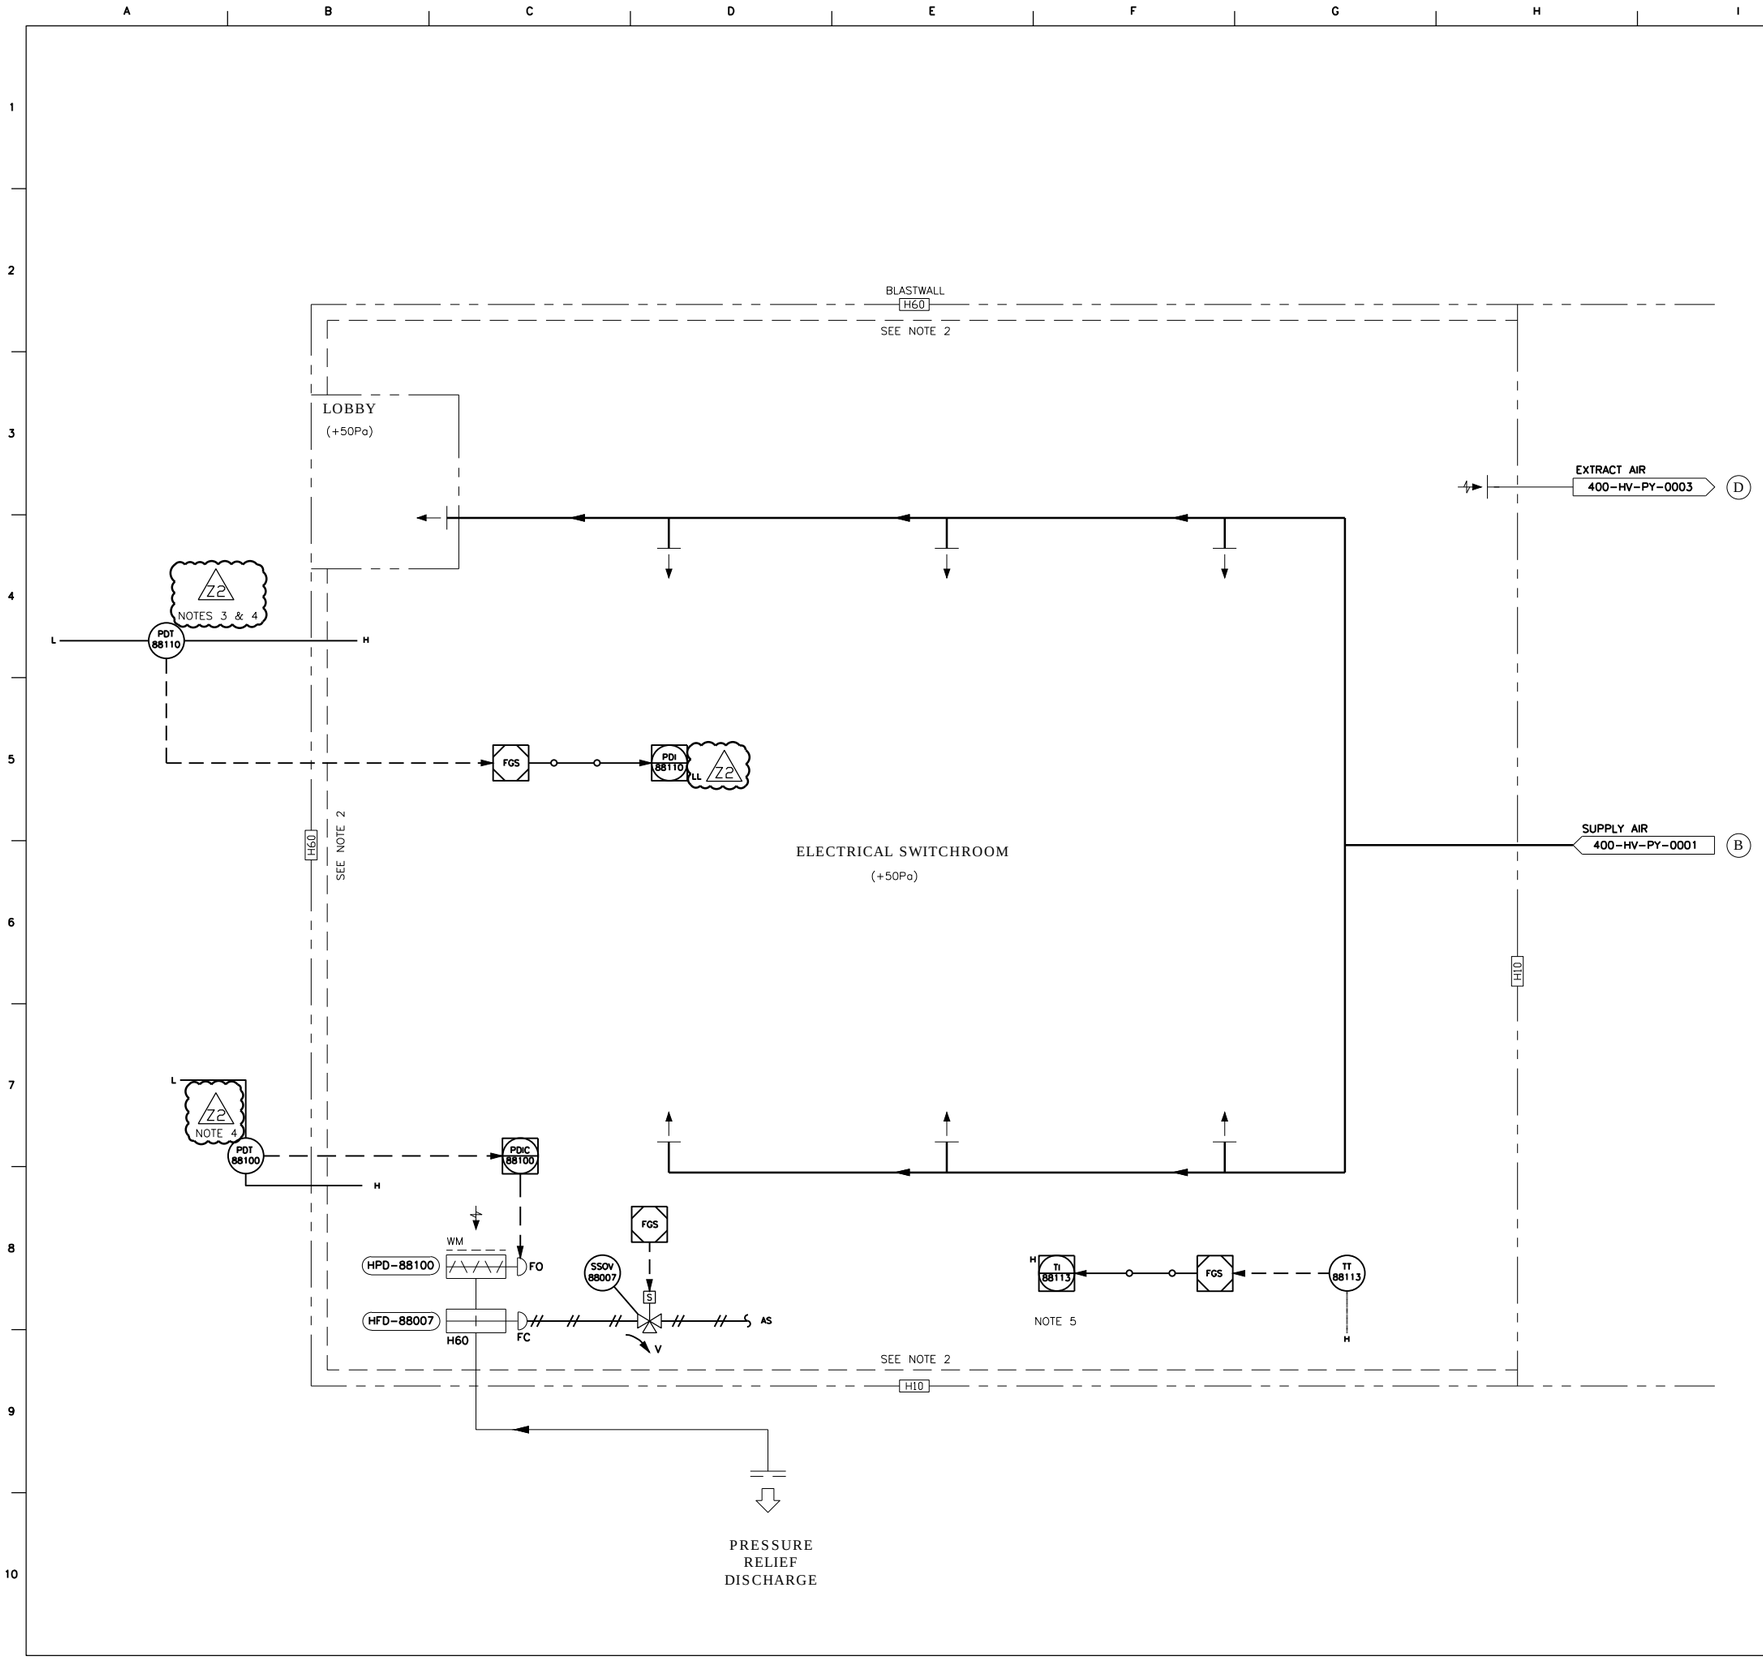

NOTES

1. THIS DRAWING SHALL BE READ IN CONJUNCTION WITH THE HVAC DESIGN PHILOSOPHY DOCUMENT NUMBER 168397-100-HV-PH-0001 AND THE HVAC CONTROLS PHILOSOPHY 168397-100-HV-PH-0002.
2. EXTRACT/RECIRC AIR FROM LER BELOW TO SWITCHROOM VIA FLOOR GAP.
3. ALARM INITIATES WHEN PRESSURE DIFFERENTIAL IS BELOW 30Pa FOR 60 SECONDS OR MORE. Z2
4. EXTERNAL ATMOSPHERIC/ROOM PRESSURE DIFFERENTIAL.
5. ROOM TEMPERATURE LIMIT ALARM/INDICATOR.

HOLDS

REFERENCE DRAWINGS

168397-100-HV-PY-0001-05	HVAC D&ID CONTROL CONFIGURATION DIAGRAM
168397-100-PR-PI-0004-01	PIPING & INSTRUMENTATION DIAGRAM LEGEND SHEET
168397-100-HV-SM-0001-01	HVAC GENERAL LEGEND
168397-400-HV-PY-0001	HVAC D&ID SUPPLY & EXTRACT PLANT W PLATFORM
168397-400-HV-PY-0003	HVAC D&ID LER & FIRE PUM ROOM W PLATFORM

REV	DATE	DESCRIPTION	DRN	CHK	APP	CLT
Z2	03/11/20	AS BUILT FOR GMOC0013				MB
Z1	29.07.14	As Built	DP	BH	BH	BH
0	01.03.12	ISSUED AFC	JC	PG	SR IV	DS
D2	09.12.11	APPROVED FOR DESIGN	NTD	PJD	CNL/IV	CAT
D1	24.10.11	APPROVED FOR DESIGN	NTD	PJD	CNL/IV	CAT
A1	19.09.11	ISSUED FOR IDC	NTD	PJD	CNL	

nexen
Nexen Petroleum U.K. Limited

Golden Eagle
Golden Eagle Area Development

TITLE:
HVAC D & ID
SUPPLY & EXTRACT DISTRIBUTION
ELECTRICAL SWITCHROOM
W PLATFORM

SCALE (A1): N.T.S.

ASSAI No:

CONTRACT No: 168397

CLIENT CONTRACT No: GEA-CT-CON-00808

DRAWING No.	REV
168397-400-HV-PY-0002	Z2

FILENAME: \\ABZ3-FS1\SHARED\PROJECT\NEXEN\GOLDEN EAGLE\WORKSCOPES\GMOC0013 BUZZARD LEG DELUGE ACTIVATION FACILITY\CLOSE OUT\168397-400-HV-PY-0002-Z2.DWG (PRINTED: 03/11/2020 11:04:39)