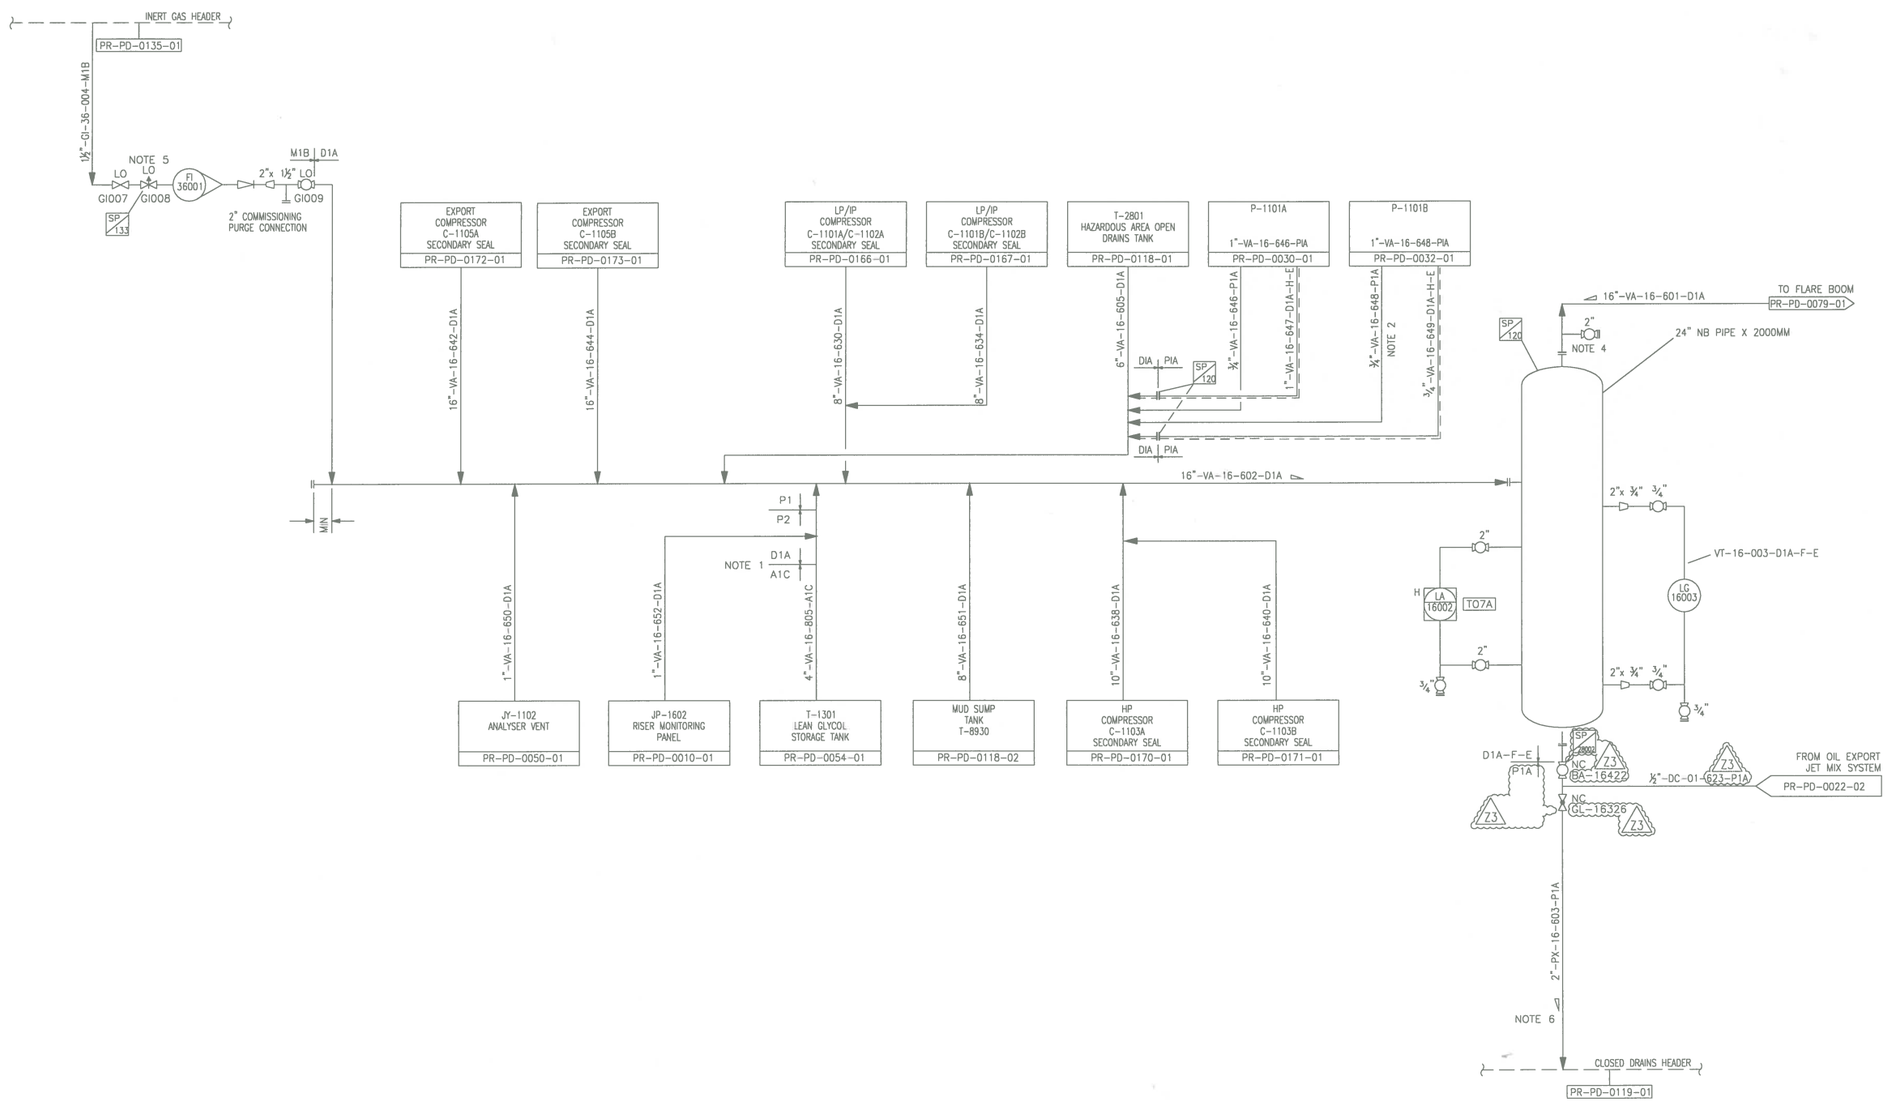

NOTES

1. SPEC BREAK TO BE 2m MINIMUM FROM HEADER.
2. 1" AND ¾" LINES NOT TO BE MANIFOLDED.
3. ALL HEADERS AND LATERALS TO BE RUN WITHOUT POCKETS AND WITH MINIMUM SLOPE TO KO POT OF 1:50 APPROX
4. SNUFFING CONNECTION
5. VALVE LOCKED IN POSITION
6. NO POCKETS AND MINIMUM SLOPE OF 1:100.

ONLY ACTIVATED TRACE HEATING IS SHOWN ON P & ID, ALL OTHER INSTALLED TRACE HEATING IS NOT ACTIVATED AND NOT SHOWN ON P & ID.

FOR APPROVAL SIGNATURES SEE ARCHIVED DRAWING REV. 0

REFERENCE DRAWINGS

DRG.No.	REV	TITLE
		DCP 5000 ARN 1993 EP-205
		DCP 5000 ARN 1975 EP-206
		DCP 5000 -770 ARN 6524 (EP-245)
		DCP 5000 -822 ARN 7310 (EP-246)
		DCP 5000 - AH 1054

REV	REASON FOR ISSUE	DATE	DRN.	CKD.	BY ENG	ENG CKD.	L.E. APP'D	NEXEN APP'D
3	AS BUILT	16.02.93						
2	REVISED FOR CONSTRUCTION	03.02.92						
1	REVISED FOR CONSTRUCTION	18.10.91	ID					
0	APPROVED FOR CONSTRUCTION	07.06.91		TS	RT	JS	BAR	KTL
Z3	AS-BUILT FOR SMOC1860	31/1/17	DD	MM	MM	SB	SB	AH
Z2	AS-BUILT FOR SMOC1860	31.07.17	LM	LM	LM	RS	RS	TR

REV	REASON FOR ISSUE	DATE	DRN.	CKD.	BY ENG	ENG CKD.	L.E. APP'D	NEXEN APP'D
Z1	AD-HOC AS-BUILT	12.01.16	LM	SB	SB	AH	AH	TR
15	AS BUILT AS PER SEQ1470 AND AD-HOC	19.11.14	LB	PG	PG	JM	AH	TR
14	REDRAWN & AS BUILT PER SEQ1321	24.03.11	AC	SW	SW	NW	NW	TR
13	AS BUILT TO INCLUDE DD-254	23.04.90	GWM					
12	AS COMISSIONED	27.04.94	RTS	RM			KJH	
11	REVISED TO LATEST INFORMATION	14.06.93						

nexen
Nexen Petroleum U.K. Limited
Scott House,
Horeness Road,Altens,
Aberdeen,AB12 3LE
Tel: (01224) 351100
Fax: (01224) 351101

THIS IS A C.A.D. PRODUCED DRAWING AND SHOULD NOT BE MANUALLY MODIFIED

SCOTT

amec foster wheeler

TITLE

PIPING AND INSTRUMENT DIAGRAM ATMOSPHERIC VENT COLLECTION HEADER

DRAWING No. SCOTT-FW-0000-PR-PD-0077-01

PROJECT	ORIG	AREA/MOD	DISC	TYPE	SEQ. No.	SHT.	REV	SCALE
							Z3	NONE