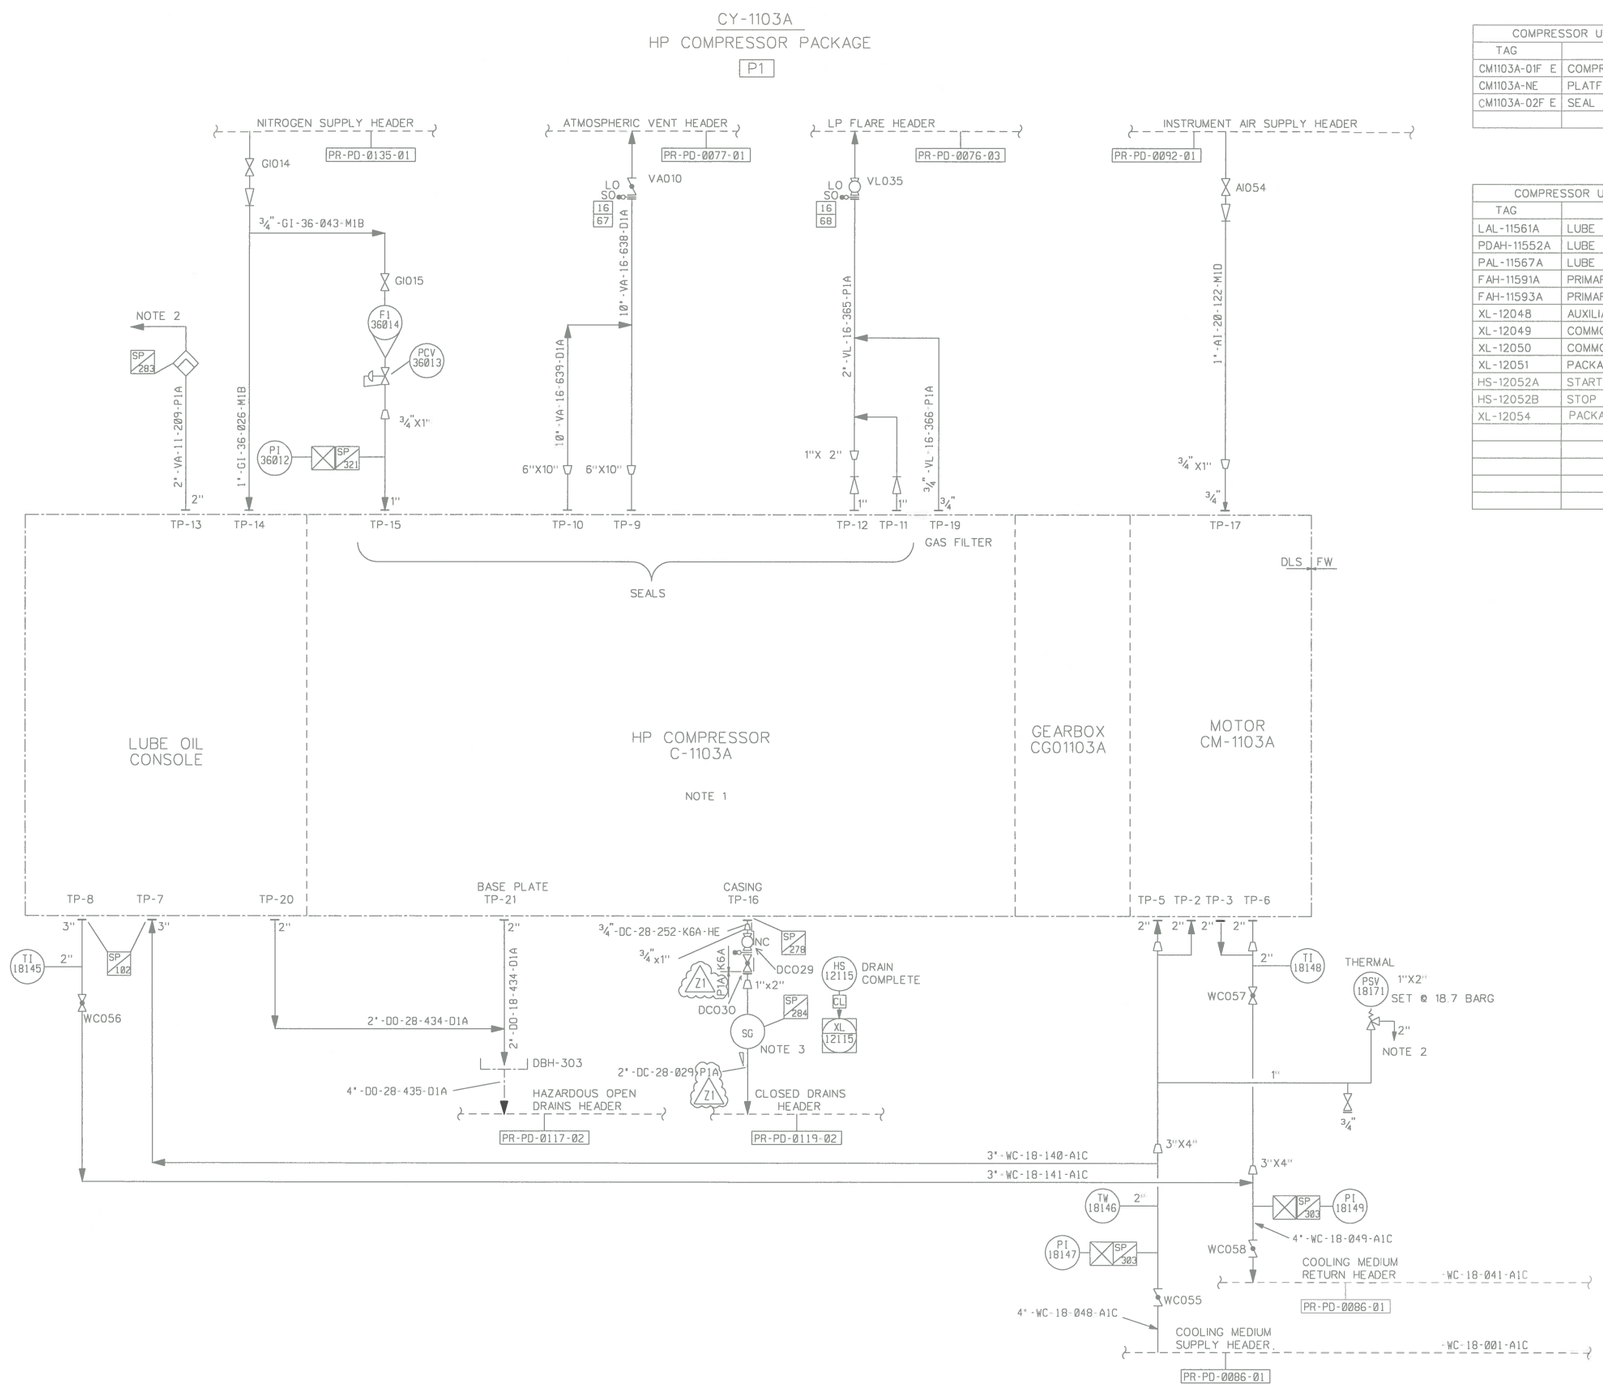

COMPRESSOR UCP SIGNALS TO/FROM ESD	
TAG	DESCRIPTION
CM1103A-01F E	COMPRESSOR MACHINERY PROTECTION
CM1103A-NE	PLATFORM E.S.D.
CM1103A-02F E	SEAL FAILURE

COMPRESSOR UCP SIGNALS TO/FROM DCS	
TAG	DESCRIPTION
LAL-11561A	LUBE OIL RESERVOIR
PDAH-11552A	LUBE OIL FILTER
PAL-11567A	LUBE OIL HEADER
FAH-11591A	PRIMARY SEAL FAILURE D.E.
FAH-11593A	PRIMARY SEAL FAILURE N.D.E.
XL-12048	AUXILIARIES RUNNING
XL-12049	COMMON FAULT ALARM
XL-12050	COMMON TRIP ALARM
XL-12051	PACKAGE AVAILABLE
HS-12052A	START AUXILIARIES
HS-12052B	STOP AUXILIARIES
XL-12054	PACKAGE/DCS START OF AUXILIARIES.

NOTES

1. FOR DETAILS SEE DELAVAL STORK SCHEMATIC P-0002-D-3002 & 3007
2. VENT AT SAFE LOCATION
3. SG IN VIEW FROM DRAIN VALVE

ONLY ACTIVATED TRACE HEATING IS SHOWN ON P & ID, ALL OTHER INSTALLED TRACE HEATING IS NOT ACTIVATED AND NOT SHOWN ON P & ID.

FOR APPROVAL SIGNATURES SEE ARCHIVED DRAWING AT REV 0

REFERENCE DRAWINGS

DRG.No.	REV	TITLE

REV	REASON FOR ISSUE	DATE	DRN.	CKD.	BY ENG	ENG CKD.	L.E. APP'D	NEXEN APP'D
2	REVISED FOR CONSTRUCTION	03/04/92						
1	REVISED FOR CONSTRUCTION	11/10/91	DB					
0	APPROVED FOR CONSTRUCTION	17/06/91	/	GC	RT	JS	BAR	KTL
DD	APPROVED FOR FINAL DESIGN	12/03/91	GM	GC	RT	JS	BAR	KTL
CD	APPROVED FOR DESIGN	07/01/91	GM	GC	PDA	JS	BAR	BP
Z1	AS-BUILT FOR SMOC1860	18/5/12	DD	[illegible]	[illegible]	[illegible]	[illegible]	[illegible]

REV	REASON FOR ISSUE	DATE	DRN.	CKD.	BY ENG	ENG CKD.	L.E. APP'D	NEXEN APP'D
14	AS BUILT TO INCLUDE SEQ1227	16/02/08	VM	EHC	EHC	AL	AL	GL
13	UPDATED TO REFLECT SEQ-1080	12/12/03	GPG	SH	DB		MG	
12	AS-BUILT TO INCLUDE DO-254	22/06/95	WN	GWM				
11	AS COMMISSIONED	29/04/94	RTS	RM			KJH	
4	REVISED TO LATEST INFROMATION	14/06/93						
3	AS BUILT							

nexen
Nexen Petroleum U.K. Limited
SCOTT HOUSE,
HARENESS ROAD, ALTENS,
ABERDEEN, AB12 3LE
TEL: (01224) 351100
FAX: (01224) 351101

THIS IS A C.A.D. PRODUCED DRAWING AND SHOULD NOT BE MANUALLY MODIFIED

SCOTT | amec foster wheeler

TITLE
PIPING AND INSTRUMENT DIAGRAM
AUXILIARY CONNECTIONS
HP COMPRESSOR TRAIN A

DRAWING No.
SCOTT-FW-0000-PR-PD-0170-01

PROJECT	ORIG	AREA/MOD	DISC	TYPE	SEQ. No.	SHT.	REV	SCALE
							Z1	NONE