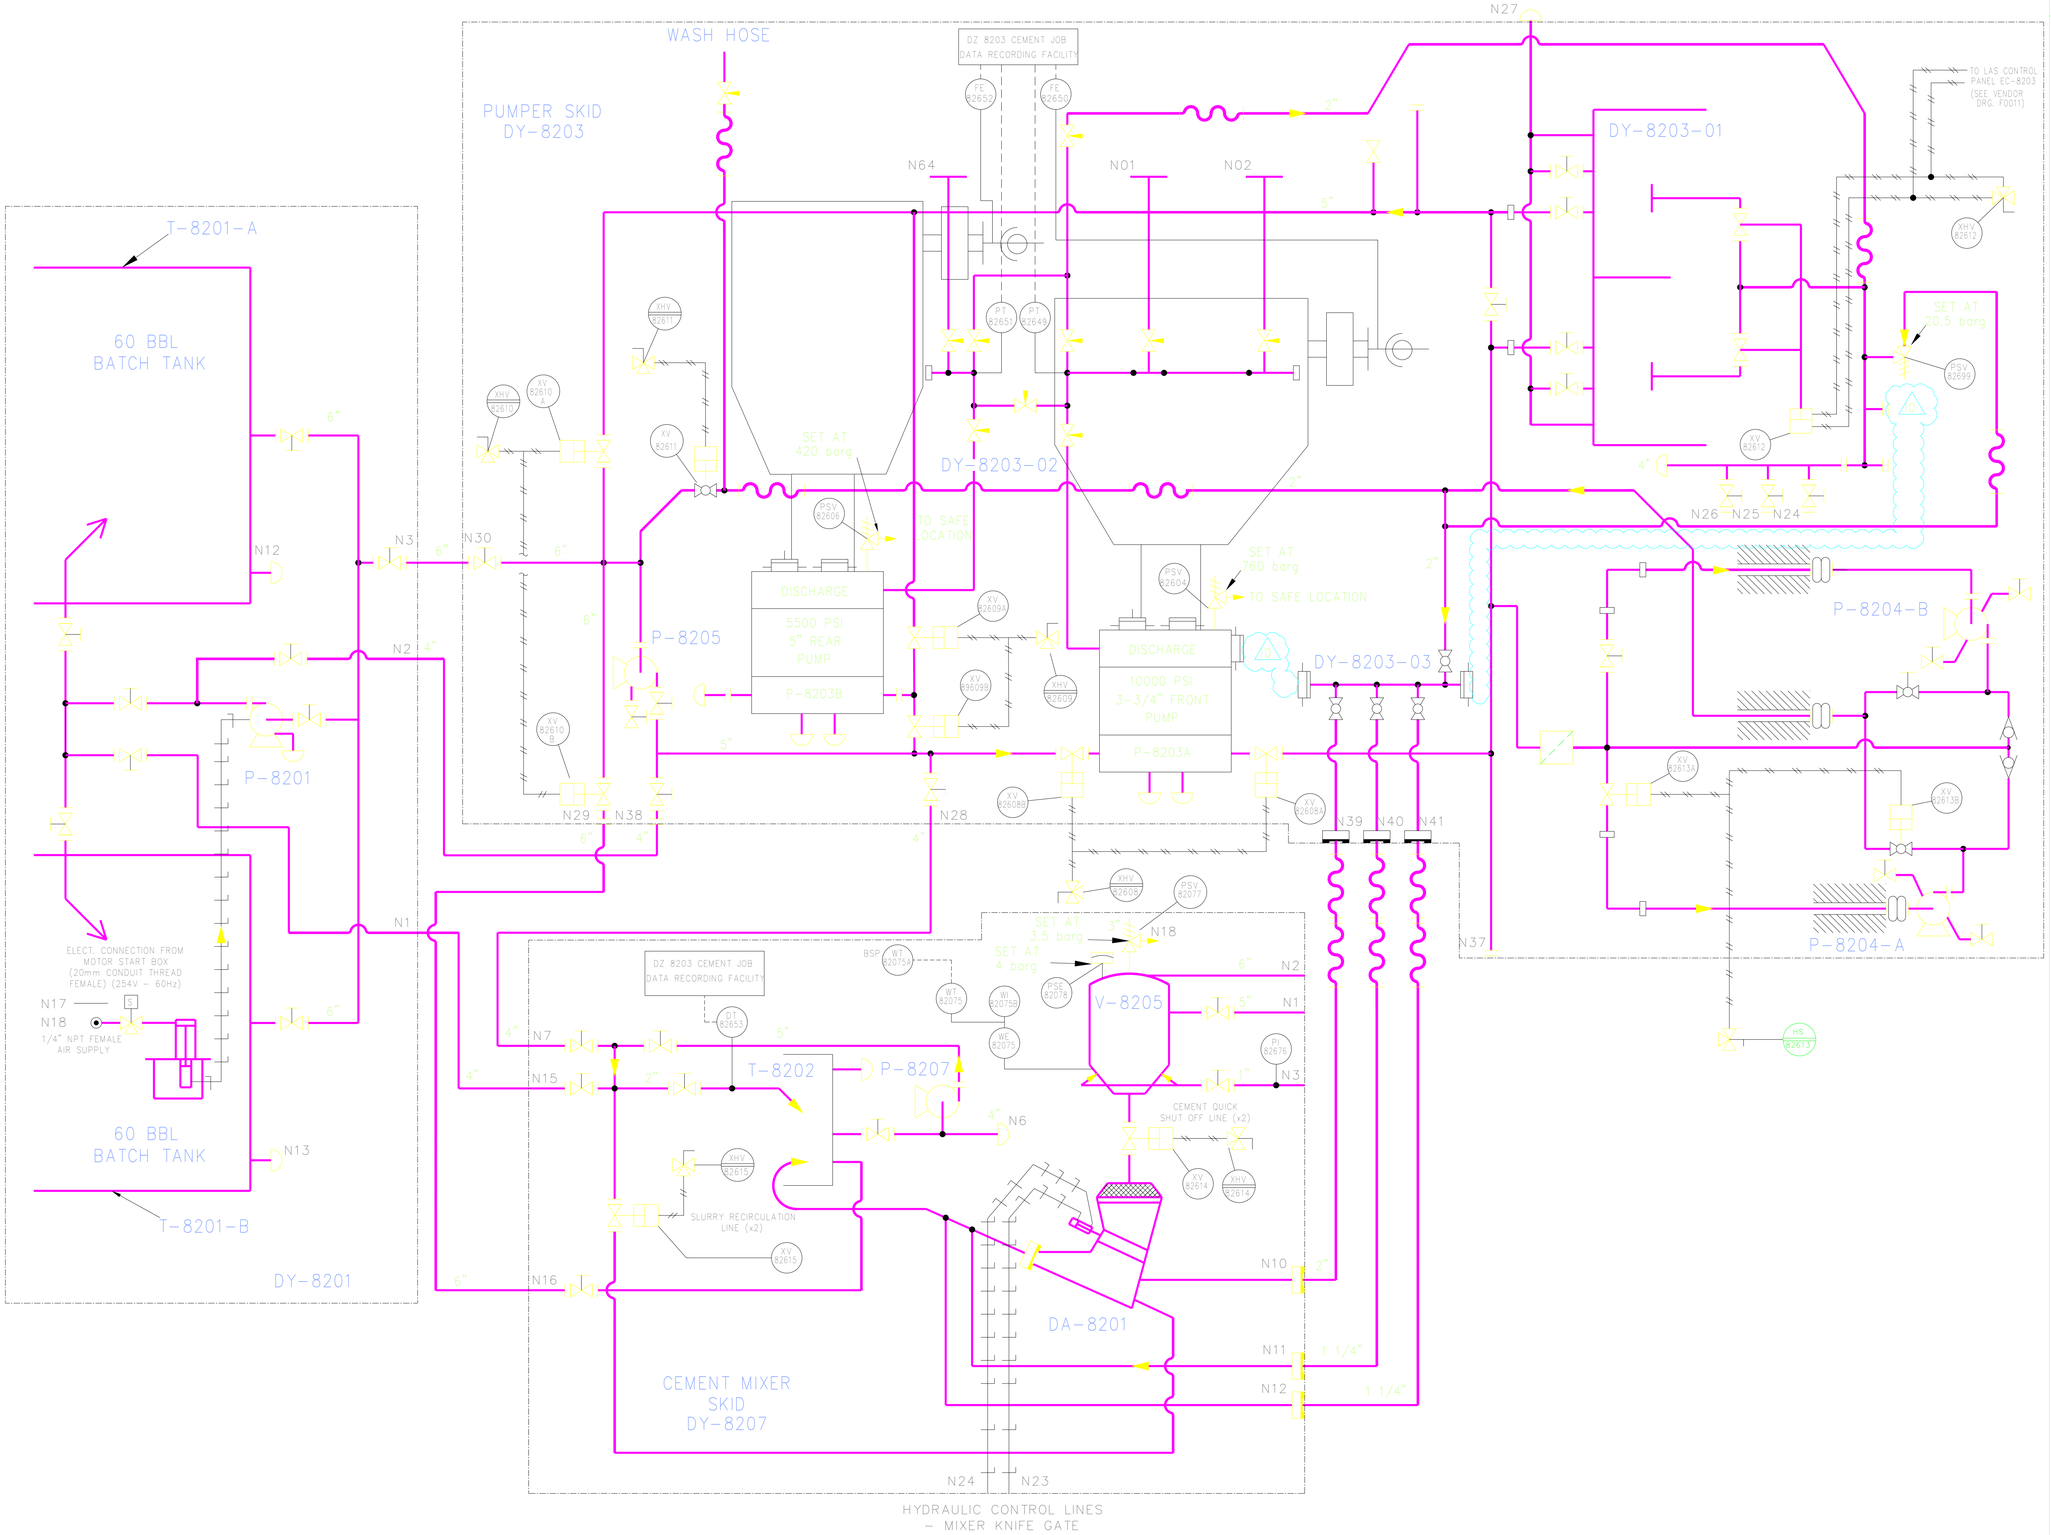

SYMBOL KEY

- ACOUSTIC ISOLATION
- ANTI-VIBRATION COUPLING
- BALL VALVE
- BUTTERFLY VALVE MANUAL (FLANGED)
- BUTTERFLY VALVE W/ACTUATOR (FLANGED)
- SCREWED END CAP
- CAPPED END
- FLANGE
- WING UNION CONNECTED
- WING UNION UNCONNECTED
- HUB COUPLING
- RELIEF VALVE
- HOSE FLEXIBLE
- STRAINER
- CENTRIFUGAL PUMP
- BURST DISK
- PLUG VALVE
- BOWL MIXER SLURRY CHIEF
- TRIPLEX PUMP & FLUID END
- LOCATED ON CEMENT UNIT CONTROL PANEL (JC-8203)
- BSP — BSP = BULK STORAGE PANEL

FOR ORIGINAL SIGNATURES REFER TO ARCHIVE VENDOR DRAWING No. P0131-D-0001-07 REV G

REFERENCE DRAWINGS

DRG.No.	REV	TITLE
SCOTT-FW-D000-DR-PD-5026-01	13	P&ID CEMENT SYSTEM
P0131-D-0001-07	G	VENDOR P&ID SHEET 1 OF 4 CIRCULATING SYSTEM
P0131-D-0002-04	F	VENDOR P&ID SHEET 2 OF 4 CIRCULATING SYSTEM
P0131-D-0003-06	F	VENDOR P&ID SHEET 3 OF 4 CIRCULATING SYSTEM
P0131-D-0004-03	F	VENDOR P&ID SHEET 4 OF 4 CIRCULATING SYSTEM

REV	REASON FOR ISSUE	DATE	DRN.	CKD.	BY ENG	ENG CKD.	L.E. APP'D	NEXEN APP'D
10	REDRAWN AS BUILT AS PER SEQ1493	25.02.10	RM	EM	EM	AW	NW	GL

nexen
Nexen Petroleum U.K. Limited
Nexen House, Horeness Road, Altens, Aberdeen AB12 3LE
Tel: (01224) 371100
Fax: (01224) 371101

THIS IS A C.A.D. PRODUCED DRAWING AND SHOULD NOT BE MANUALLY MODIFIED

SCOTT AkerSolutions

TITLE: PIPING & INSTRUMENT DIAGRAM CEMENT UNIT CIRCULATING SYSTEM (SHEET 1 OF 4)

DRAWING No. SCOTT-AK-D000-DR-PD-0001-01 | REV 10 | SCALE NONE