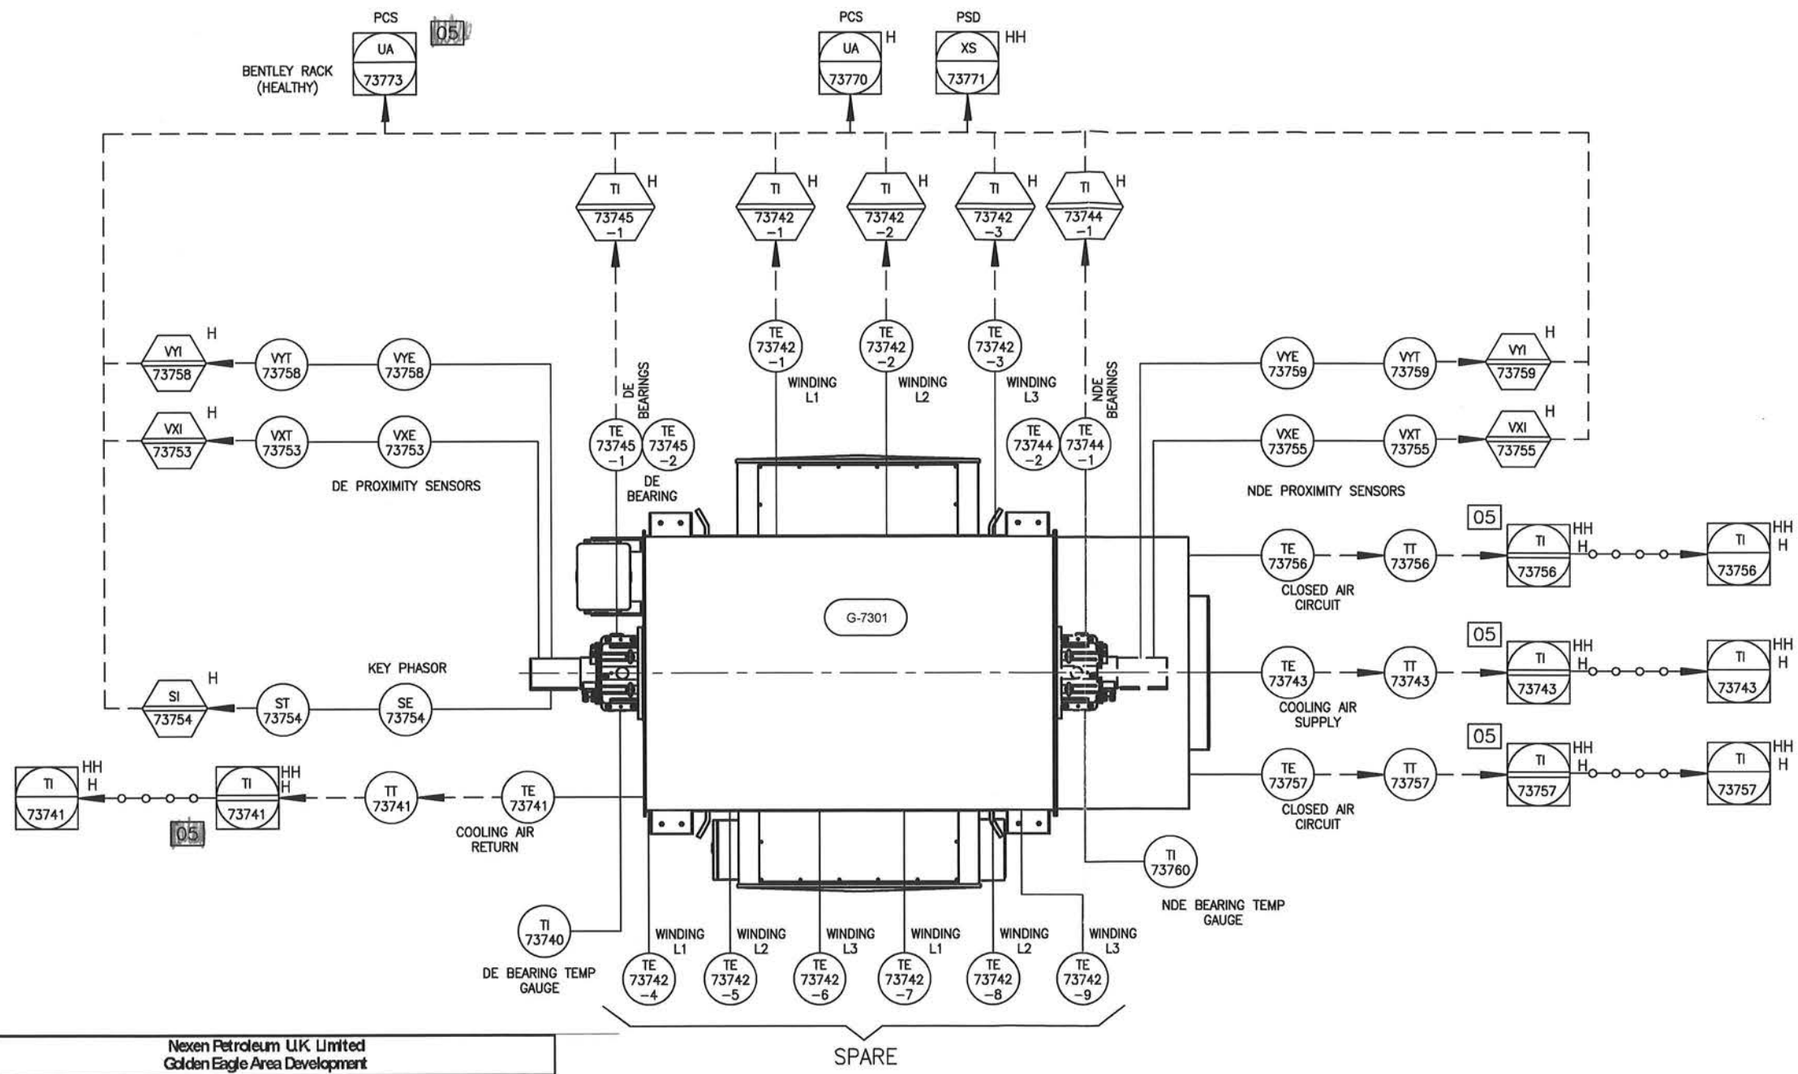

No.	ALTERATIONS	CHK'D	DATE
06	AS BUILT	N.RUDGLEY	24/01/2013
05	TAG N°'S MODIFIED	AV	31/05/2012
04	TT SIGNALS ADDED. DMS SIGANALS ADDED	AV	05/04/2012
03	SENSORS MODIFIED	AV	
02	NOTES DELETED. SYMBOLS MODIFIED AIR TEMP BACK TO PLC ALL OTHER SENSORS THROUGH THE BENTLEY NEVADA	AV	21/12/2011

NOTES - MECHANICAL

TOLERANCES:
GENERAL TOLERANCE + / - 5MM
FABRICATION + / - 3MM
HOLE CENTRES + / - 1MM
OTHER TOLERANCES AS STATED WHERE REQUIRED

DO NOT SCALE
IF IN DOUBT ASK

THIRD ANGLE PROJECTION

Nexen Petroleum U.K. Limited
Golden Eagle Area Development

VENDOR:	Broadcrown
EQUIPMENT TITLE:	ESSENTIAL SERVICES GENERATOR
EQUIPMENT TAG NO(S):	X-7301

GEAD Document Number

Purchase Order Number	Doc Type Code	Seq. No	Rev.	DATE
168397-200-PO-3279	MC2	008	06	24/01/2013

INCLUDES DOCUMENT CODES: TOTAL SHEETS: 01

X	F	Final (accepted) – manufacturing may proceed.
	A	Qualified Release –, revise and re-submit. Manufacturing may proceed subject to incorporation of comments
	R	Rejected - revise and re-submit. Manufacturing may not proceed.
	I	Accepted for information only

Review of Vendor documents does not relieve Vendor of the responsibility for correctness under the Purchase Order. Permission to proceed does not constitute acceptance of design, detail and calculations, test methods or materials developed or selected by the Vendor and does not relieve the Vendor from full compliance with the Purchase Order or any other obligations, nor detract from any of the Purchaser's rights.

Engineer: Date: 6-FEB-13

TITLE:	ALTERNATOR P&ID
CLIENT:	NEXEN PETROLEUM UK LIMITED
SITE:	GOLDEN EAGLE AREA DEVELOPMENT
W.O. No.: 565911	ENGINEER: N.RUDGLEY
TYPE: CAT3512	DRAWN BY: N.RUDGLEY
SCALE: N/A	DATE: 09/11/2011
TOTAL No. OF SHEETS (1 - 999)	01
DRAWING NO. GEAD-PID008	ISSUE 06

broadcrown
Broadcrown Ltd, Airfield Industrial Estate
Hixon, Stafford, Staffs ST18 0PF, England
tel:+44 (0) 1889 272200
email: info@broadcrown.co.uk
www.broadcrown.com