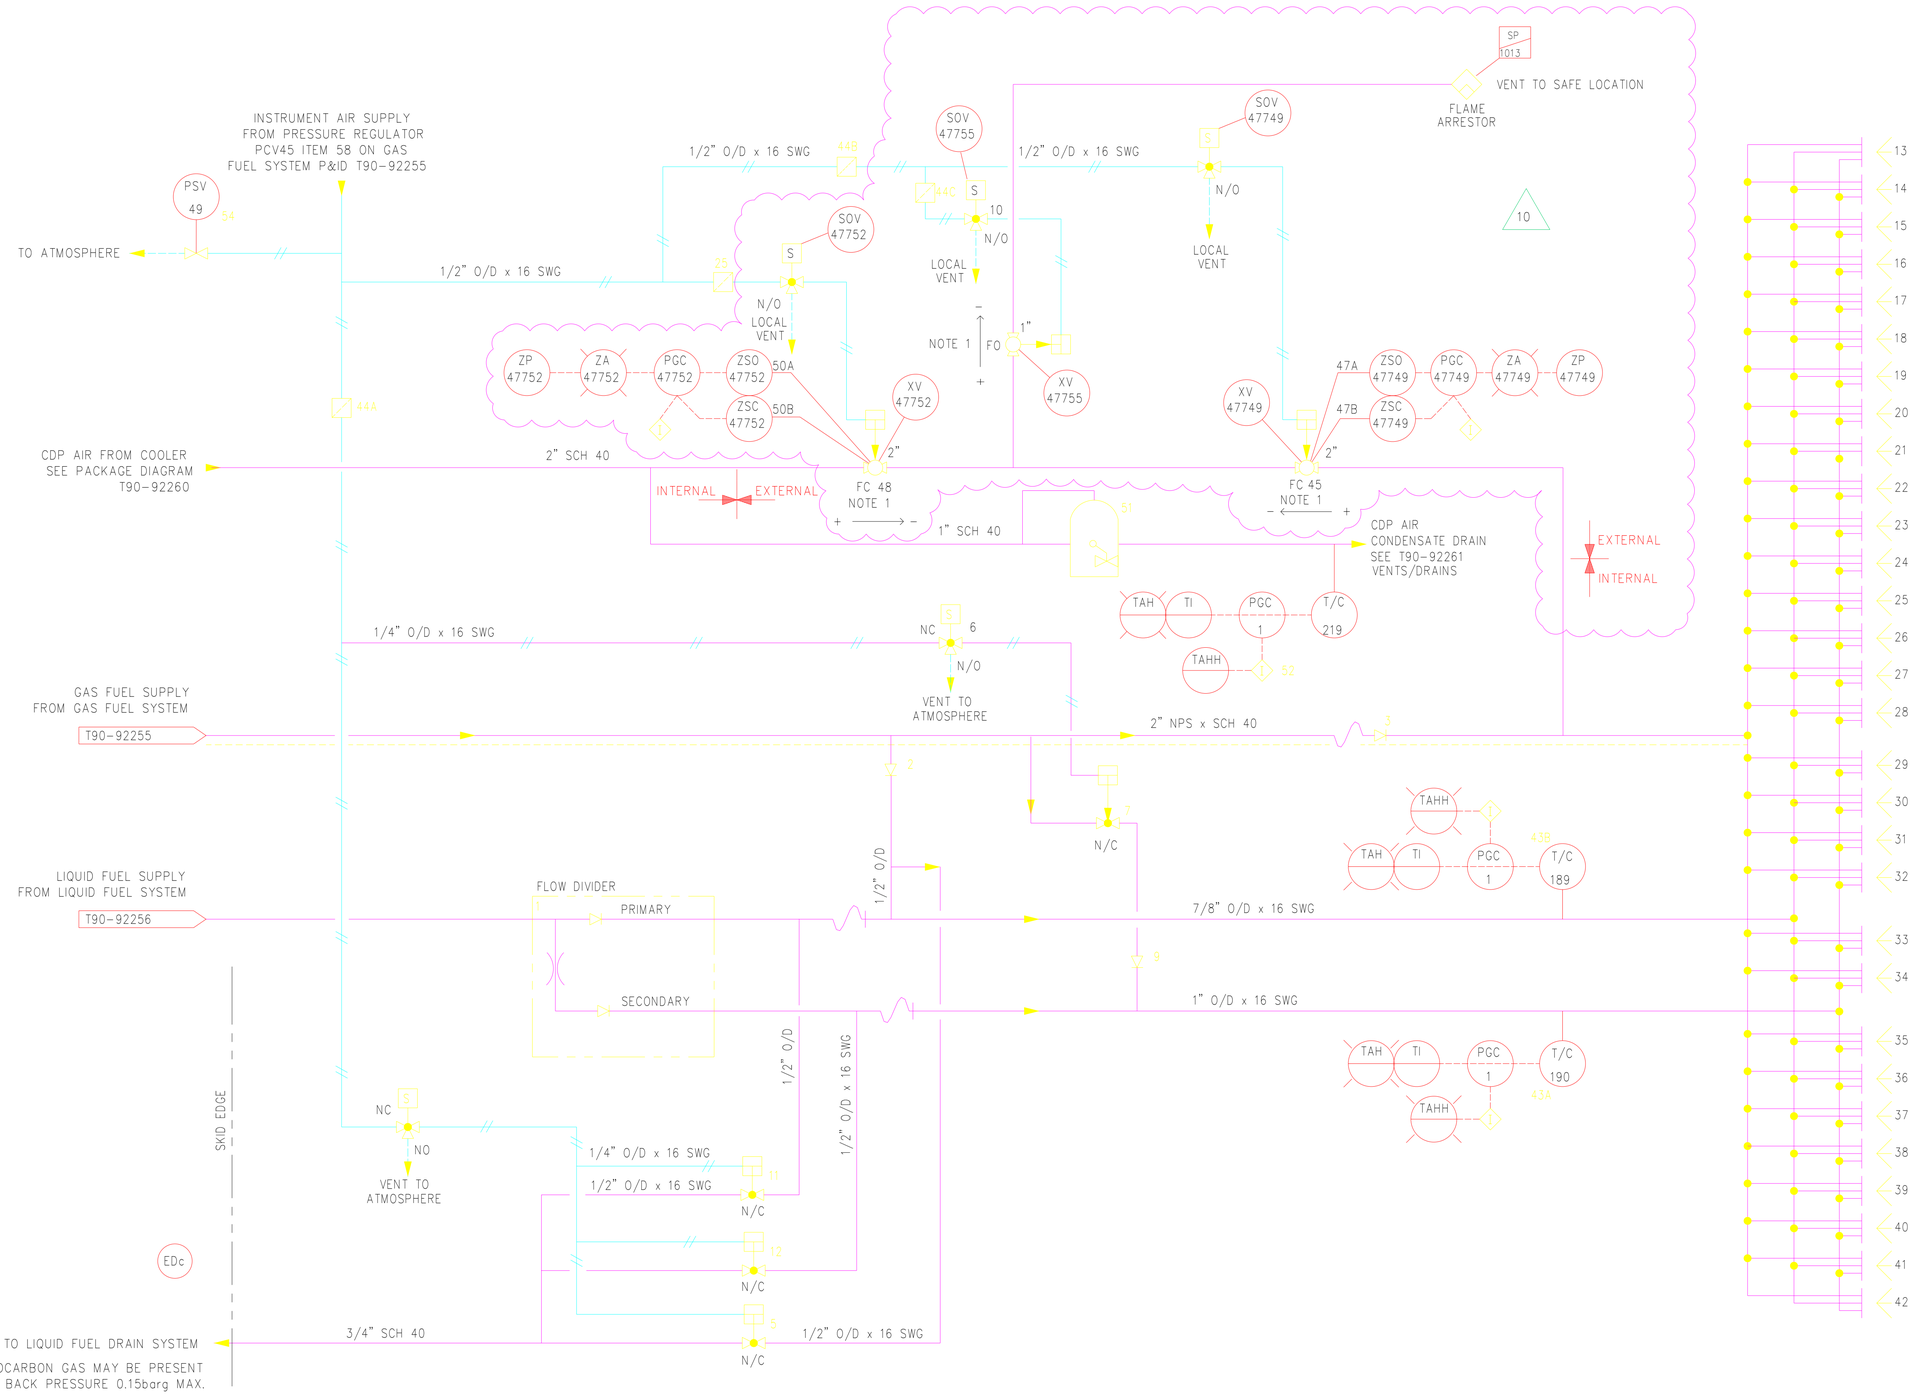

LEGEND

c — CUSTOMER CONNECTION POINTS.
REFER TO GENERAL ARRANGEMENT DRAWING FOR DETAILS.
REFER TO CT5107 FOR SAFETY PRECAUTIONS.

TRACE HEATING

NOTES

1. PREFERENTIAL DIRECTION SEALED VALVE. ARROW INDICATES PRESSURE DIFFERENTIAL FROM HIGH (+) TO LOW (−) IN CLOSED POSITION WHEN INSTALLED. (10)

FOR APPROVAL SIGNATURES SEE ARCHIVED DRAWING AT REV 1

REFERENCE DRAWINGS

DRG.No.	REV	TITLE
T90-92257 Sht. 1 of 4 (SCOTT-P0001-0020)	7	DUAL FUEL COMPONENTS P & ID

REV	REASON FOR ISSUE	DATE	DRN.	CKD.	BY ENG	ENG CKD.	L.E. APP'D	NEXEN APP'D
10	REDRAWN & AS BUILT AS PER SEQ1248	09.03.10	JJ	EM	EM	AW	NW	GL

nexen
Nexen Petroleum U.K. Limited
Nexen House,
Hareness Road,Altens,
Aberdeen AB12 3LE
Tel: (01224) 371100
Fax: (01224) 371101

THIS IS A C.A.D. PRODUCED DRAWING AND SHOULD NOT BE MANUALLY MODIFIED

SCOTT AkerSolutions

TITLE
PIPING & INSTRUMENT DIAGRAM
DUAL FUEL COMPONENTS
(PACKAGE B)

DRAWING No. SCOTT-AK-0000-PR-PD-0202-02 | REV 10 | SCALE NONE

PROJECT | ORIG | AREA/MOD | DISC | TYPE | SEQ. No. | SHT. | REV | SCALE